
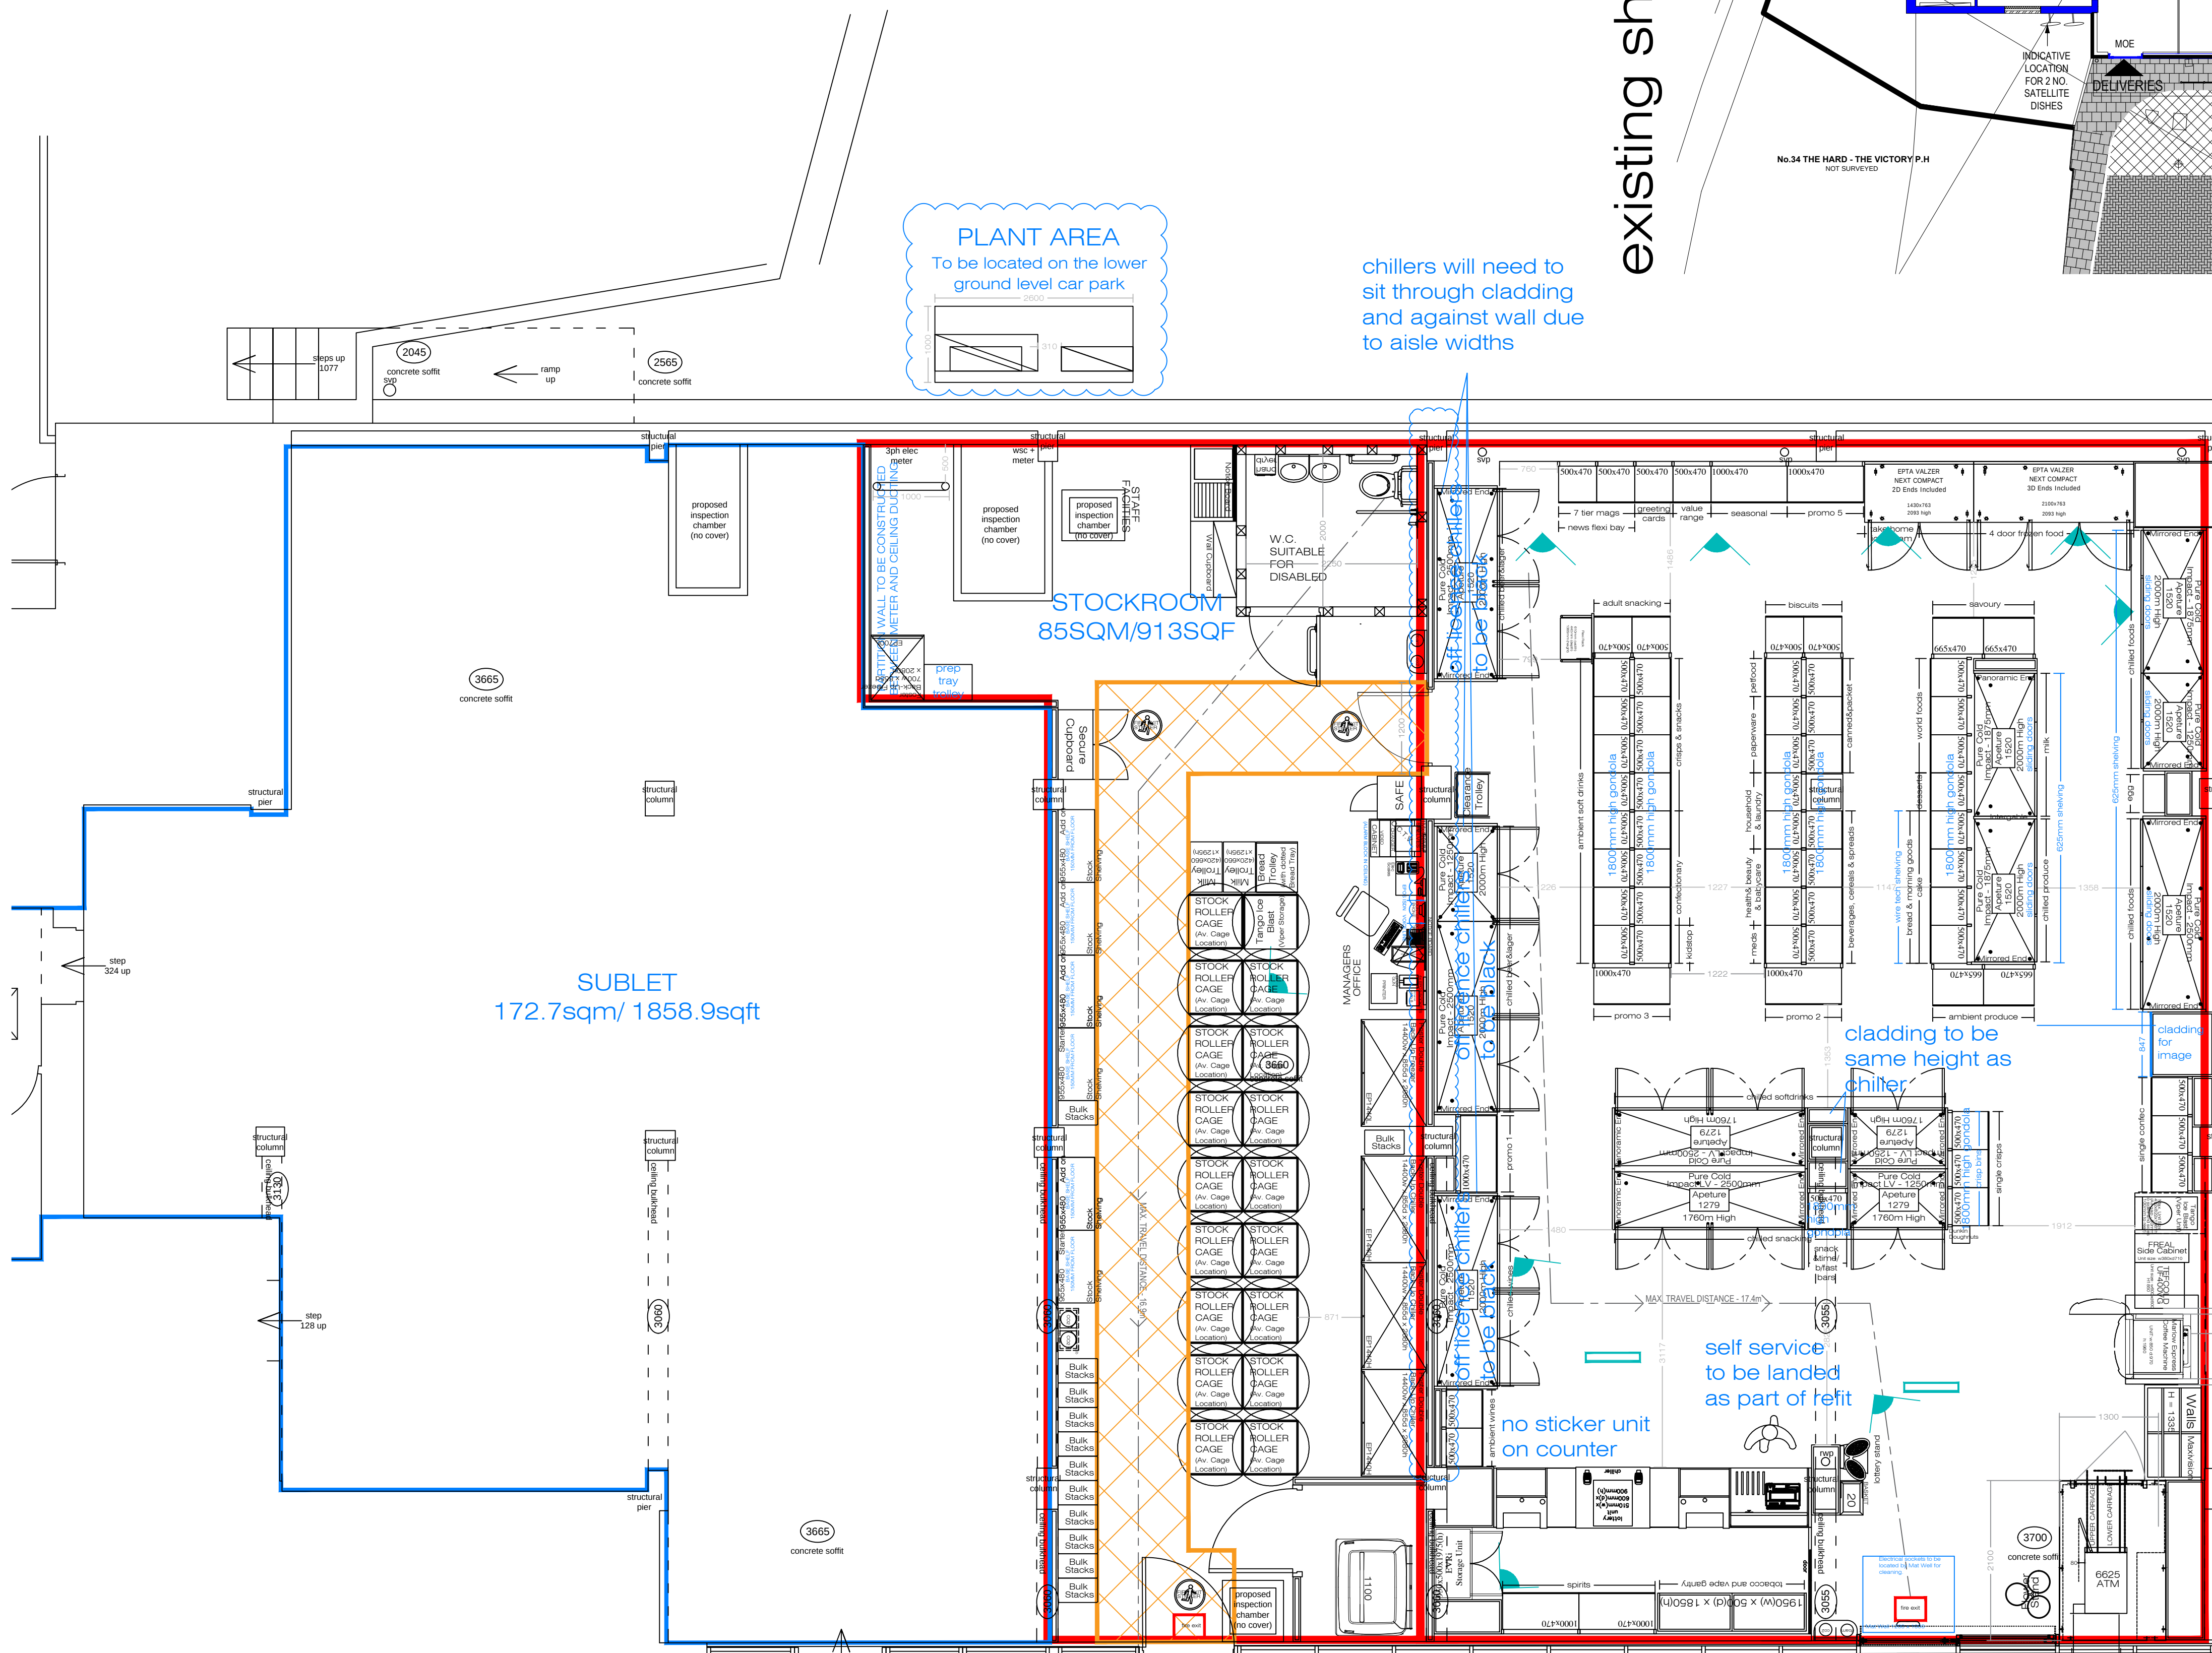


any changes to store layout must not be progressed without prior consent from the RDG approval process
please contact the one|stop design team for further information

existing shopfit plan 1:100

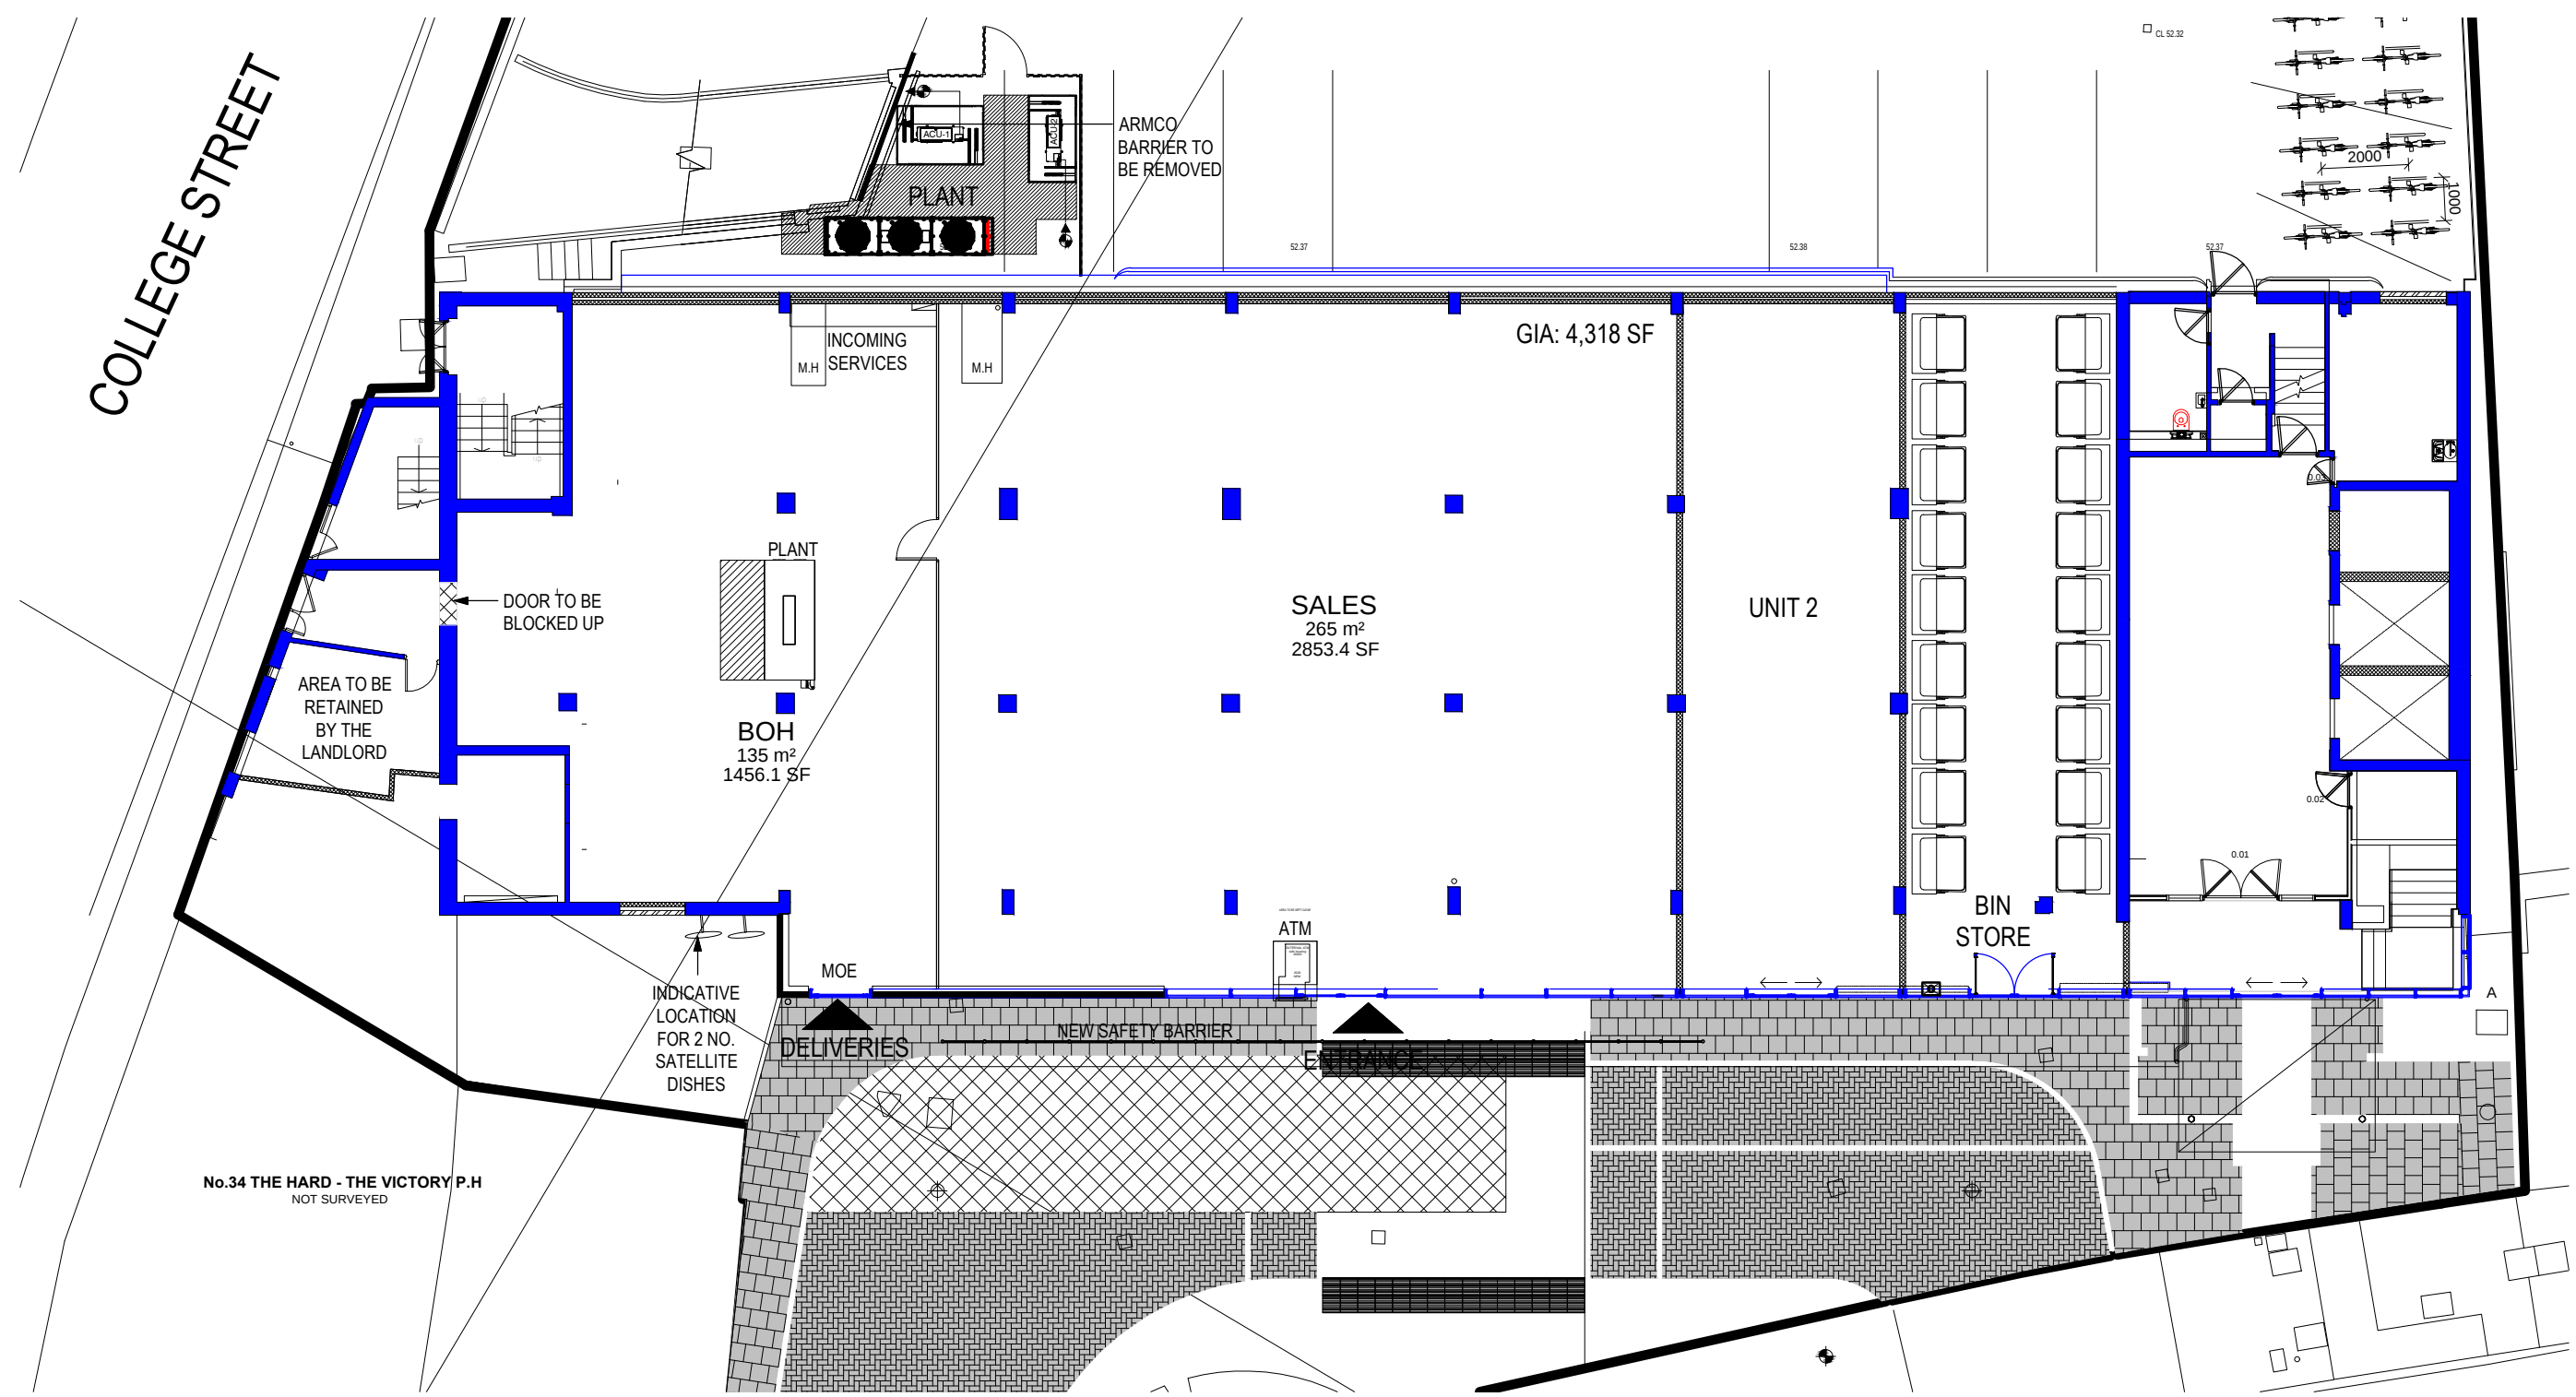

proposed shopfit plan

no	description	actioned date
linear comparison:

stock room size

store profile:

store fascia colour:
(corporate/white/conservation)

ofd grocery grading:

ofd off-license grading:

sales area: 160 m²

stock area: 85 m²

* ft²

new store

store address:
brunel house
the hard
portsmouth

store code: 0000

date: *

as approved by
retail design group

one|stop

SHOPFIT PLAN
PROPOSED

dwg no: job no:
DR - 0000 - 1