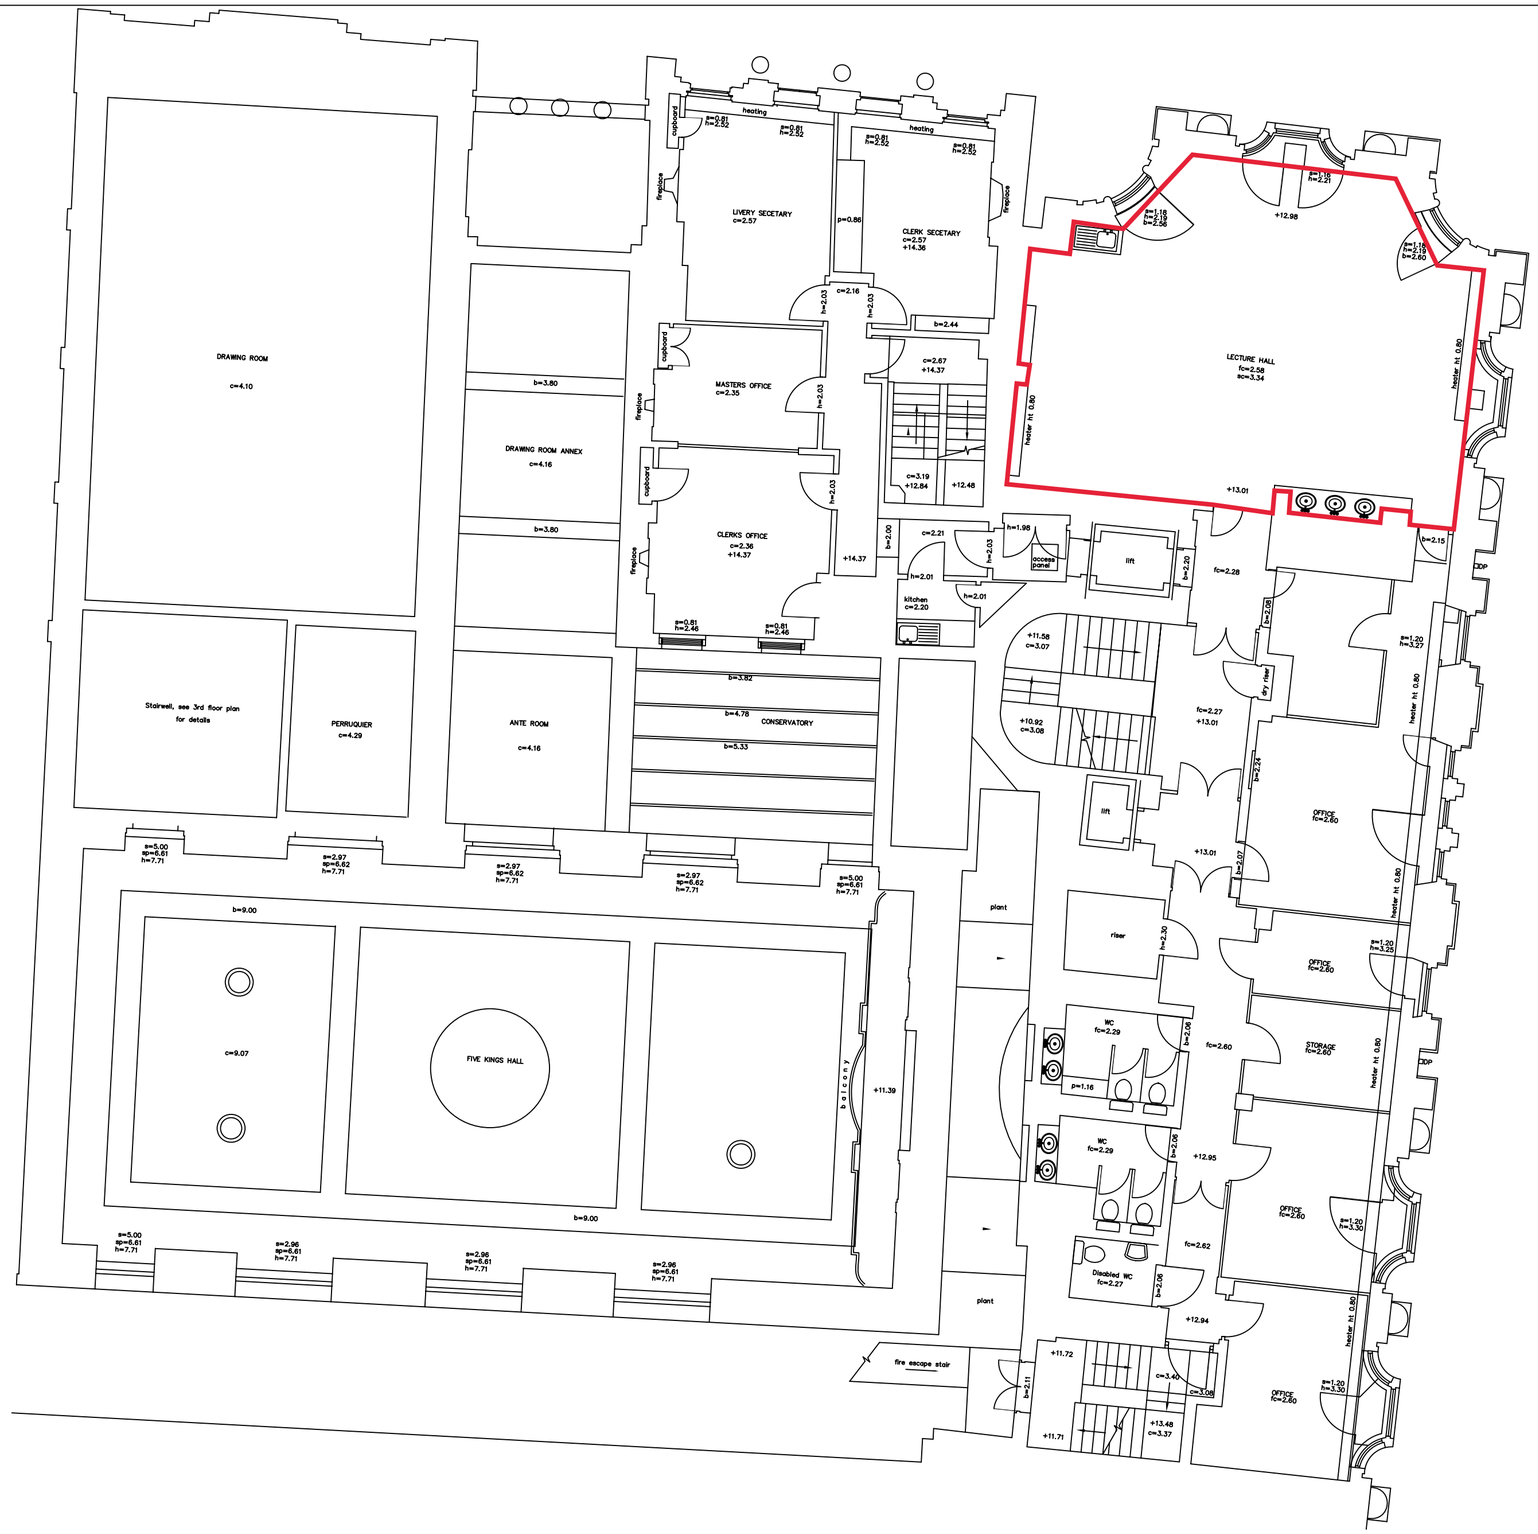

Although every effort has been made to confirm type, run and size of drainage it is advisable to check these details against statutory authority records before proceeding with any design.

Although every effort has been made to confirm species of trees shown on this drawing if it is critical to design we do not accept responsibility for any errors and advise consultation with an aboriculturalist.

Rev.	Notes:	Date

L E G E N D

when viewing individual floors please ensure that all layers beginning "C" are turned on & thawed , as well as the relevant floor prefix. e.g. "1*" for first floor

B	BASEMENT	P	PARTITIONING
G	GROUND	B	BRICK
1	FIRST	O	OVERHEADS
2	SECOND	T	TEXT
3	THIRD	W	WINDOWS/STEPS
4	FOURTH	S	SERVICES

s : Cill Height
h : Head Height
c : Ceiling Height
b : Beam Height
sp : Spring Point
sc : Structural Ceiling
fc : False Ceiling
Step Up
Slope UP
Stair Cut
Jamb
Hinge
Beam (Exposed)
Beam (Hidden)
A Section Line A
30.10 Detail Levels
30.10 Related to OSBM
(Unless otherwise stated)

Fit Mark

RICS THE SURVEY ASSOCIATION
S U R V E Y S
MINDENHALL COURT ¤ 17 HIGH STREET
STEVENAGE ¤ HERTFORDSHIRE ¤ SG1 3BG
TEL 0143 872 8441 ¤ FAX 0143 874 2435
¤ email mail@csl-surveys.co.uk ¤
¤ http://www.csl-surveys.co.uk ¤

Project
THE VINTNERS HALL
UPPER THAMES STREET
LONDON EC4

Title
VINTNERS HALL SECOND FLOOR
FIVE KINGS HOUSE FIRST FLOOR

Client
CB RICHARD ELLIS

Drawing No 20205X/2

Scale 1:50 | Date JULY 2005

Sheet 4 of 10

All levels related to OSBM located on SW corner of St.Micheal Royal Church, College St. Value 7.94m