




FRONT ELEVATION 1:100

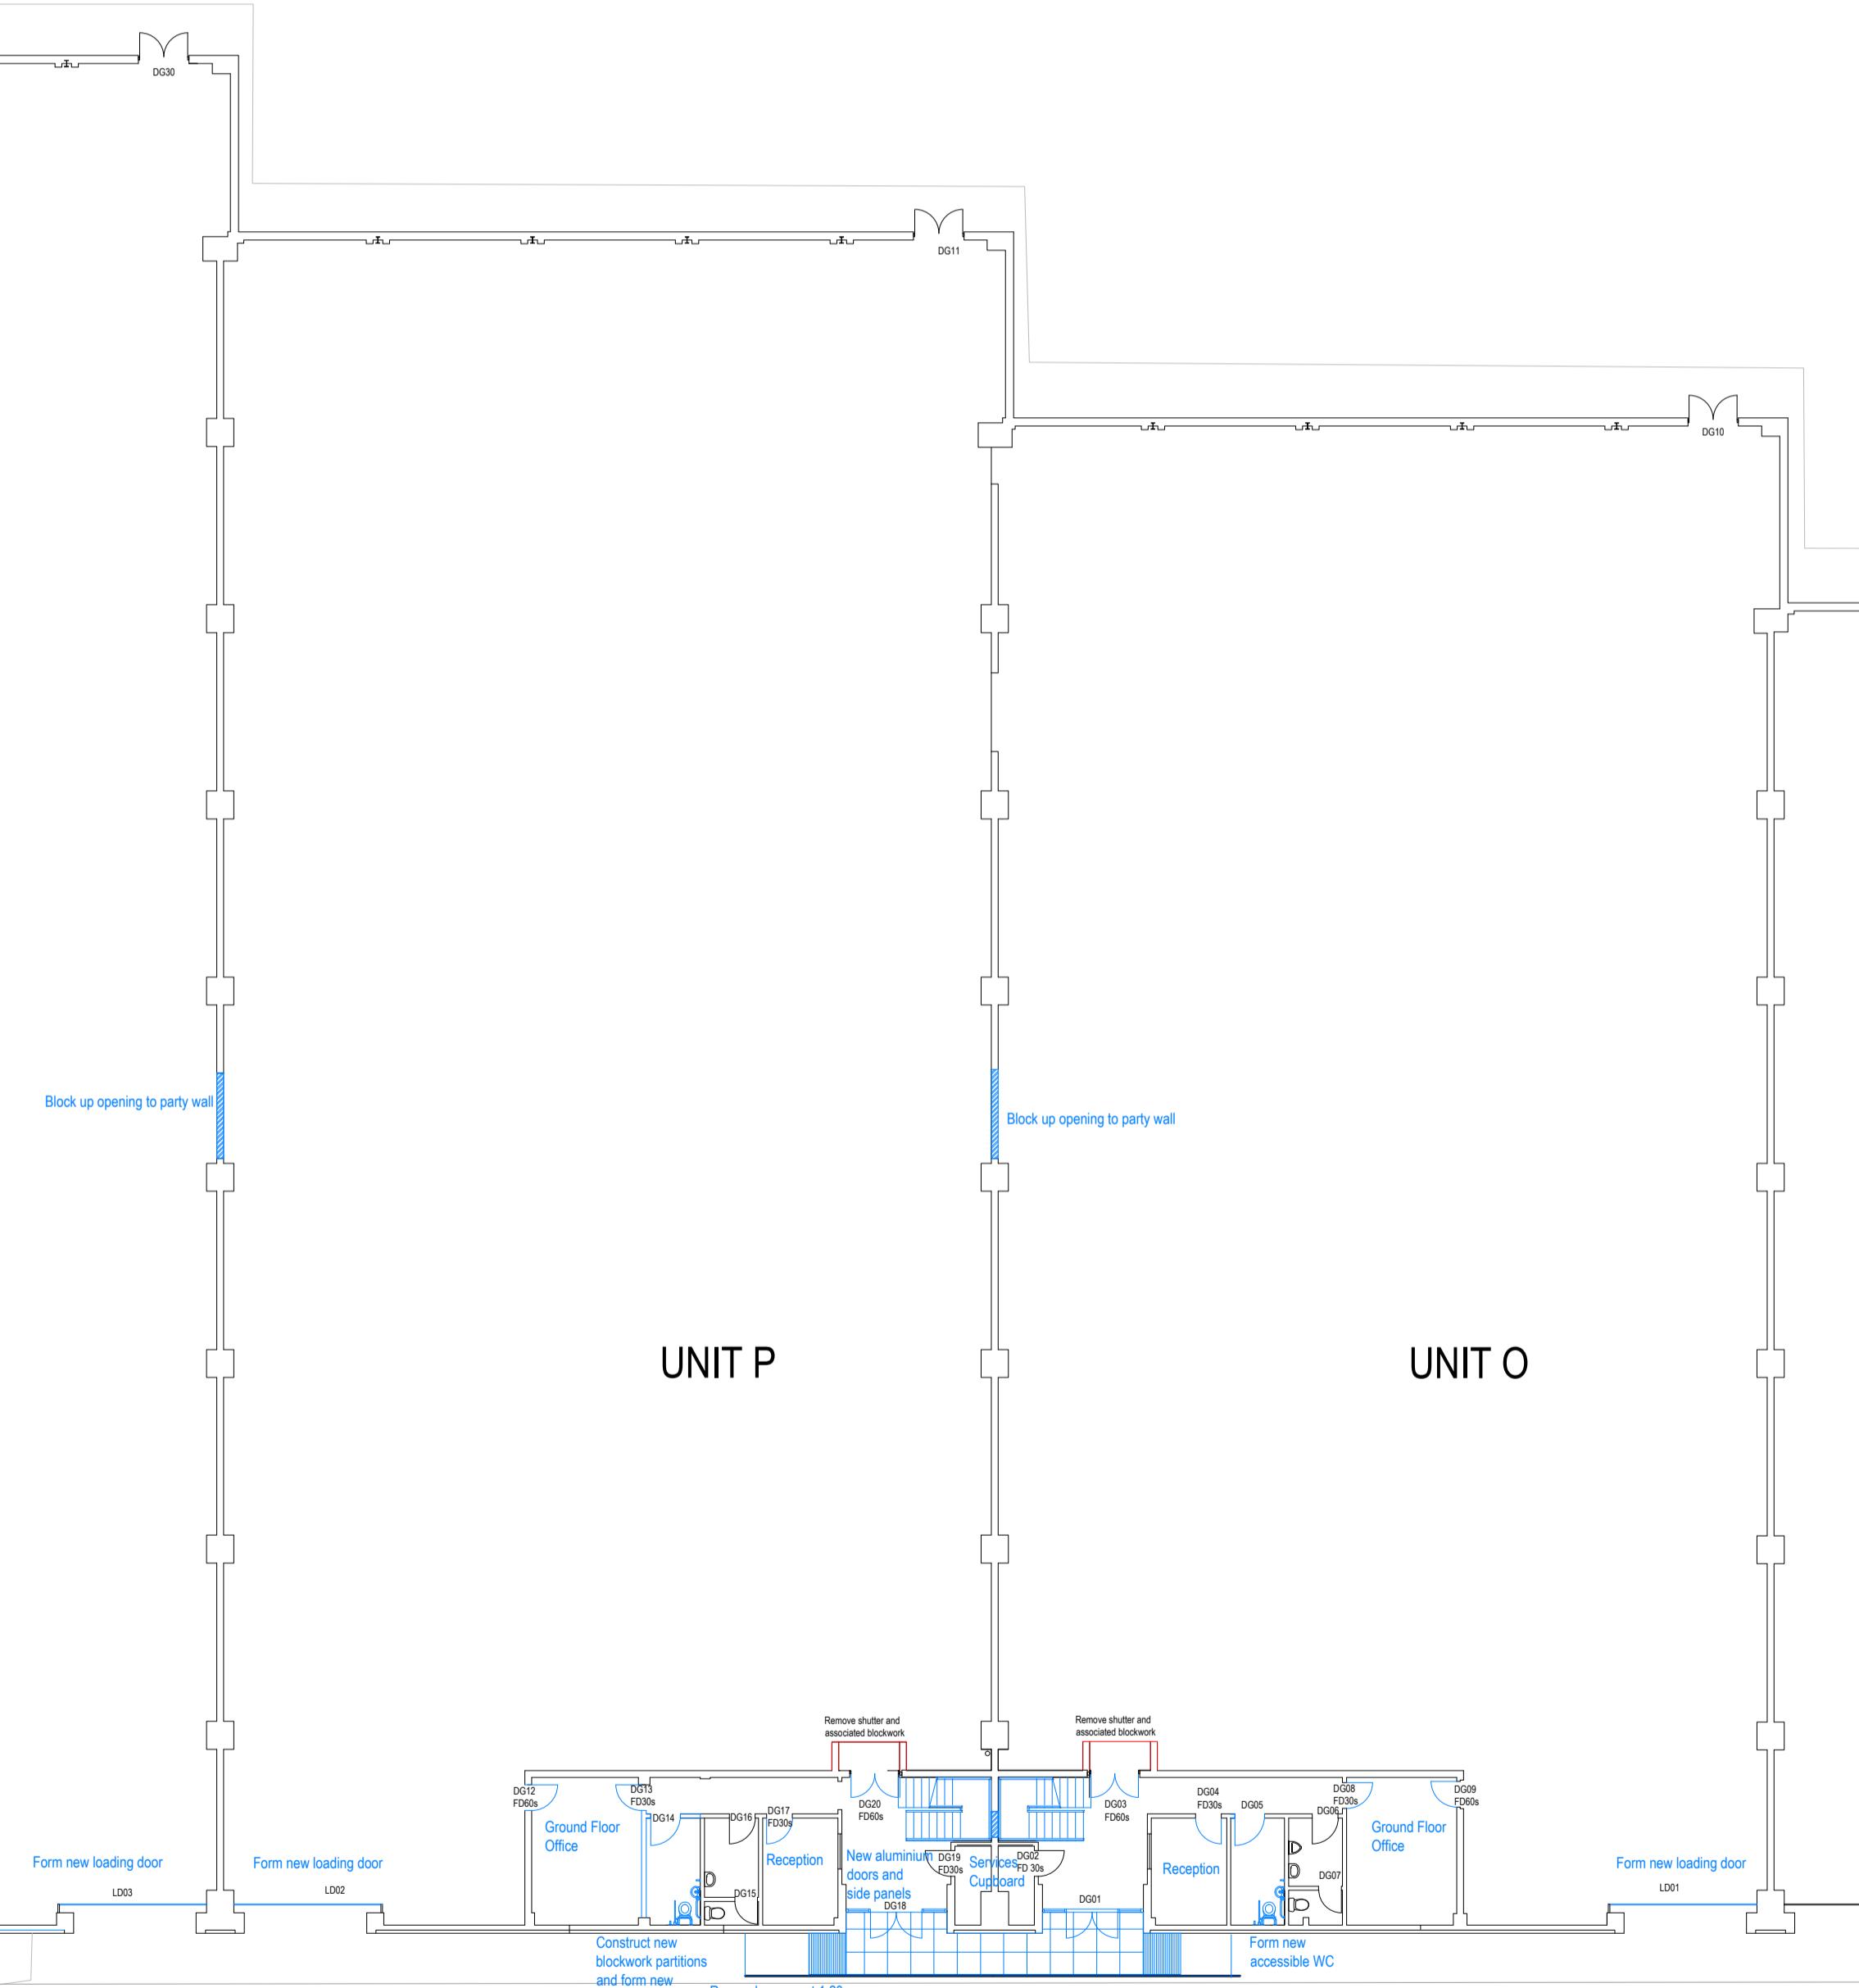

FLOOR PLAN 1:200

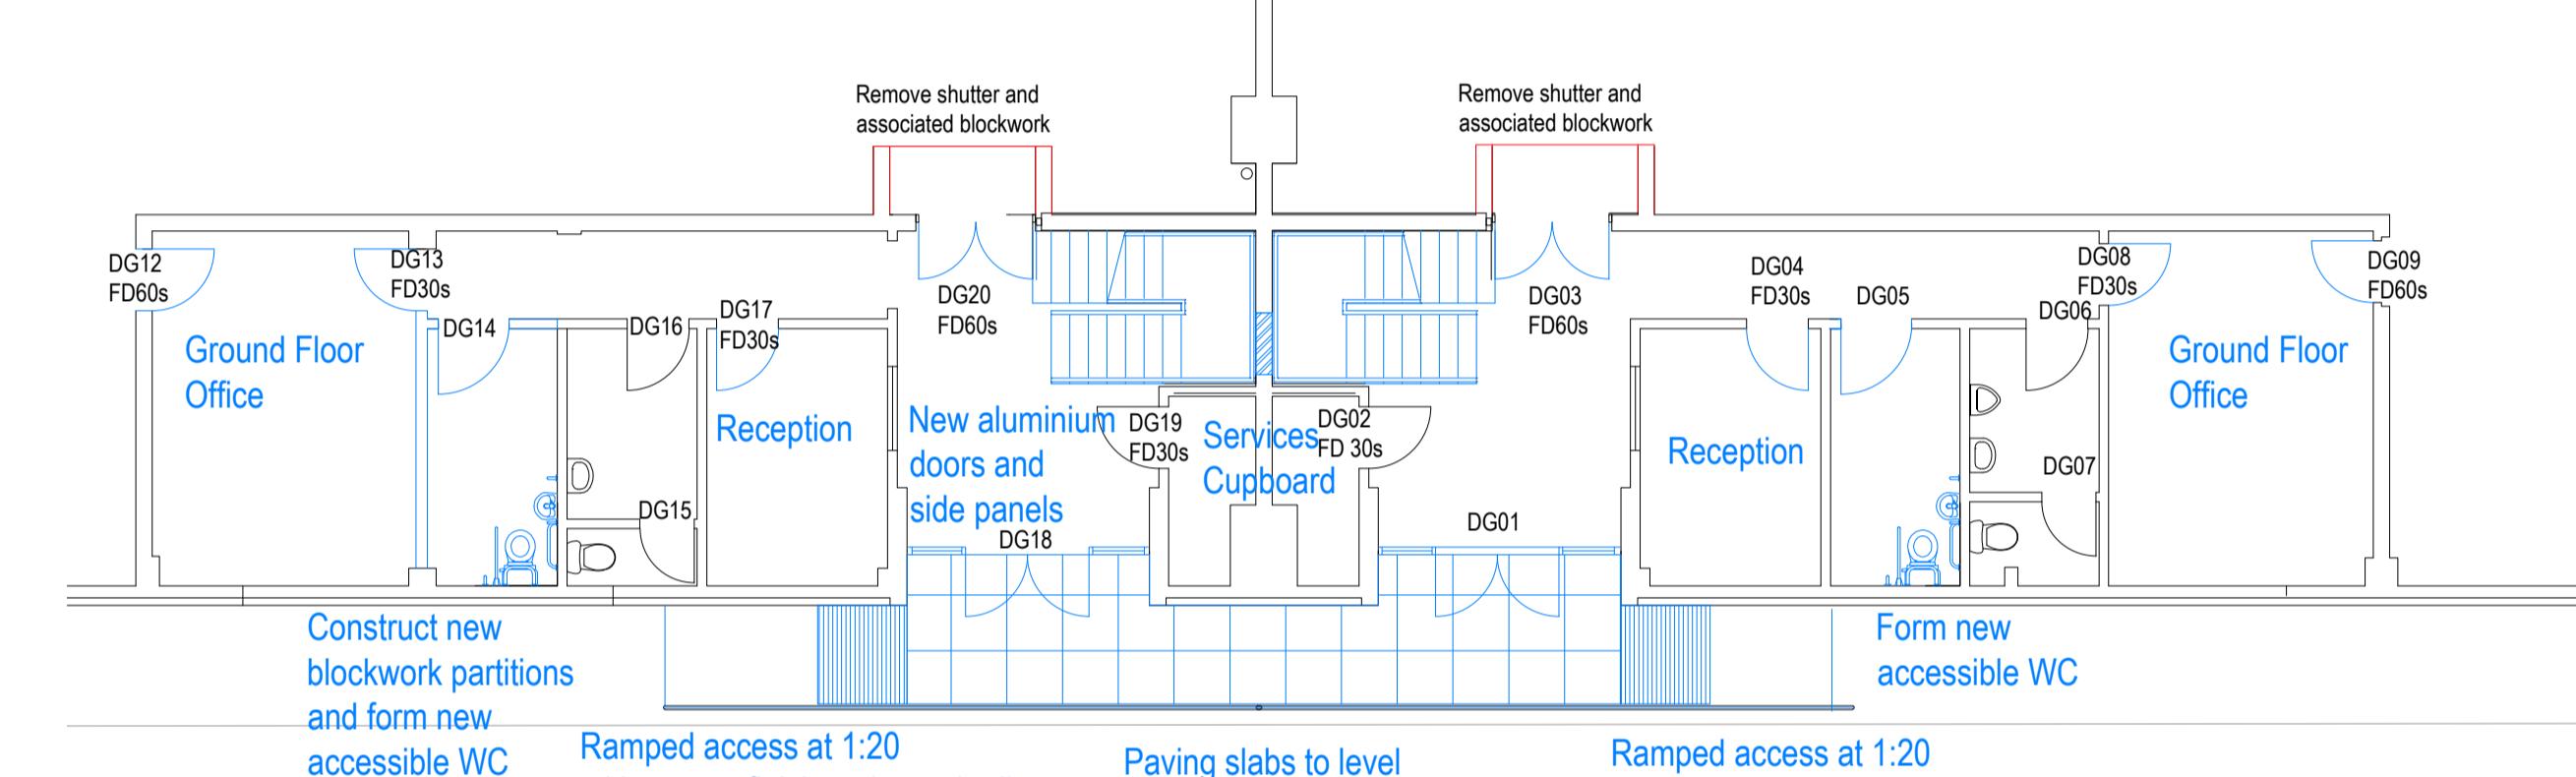

GROUND FLOOR 1:100

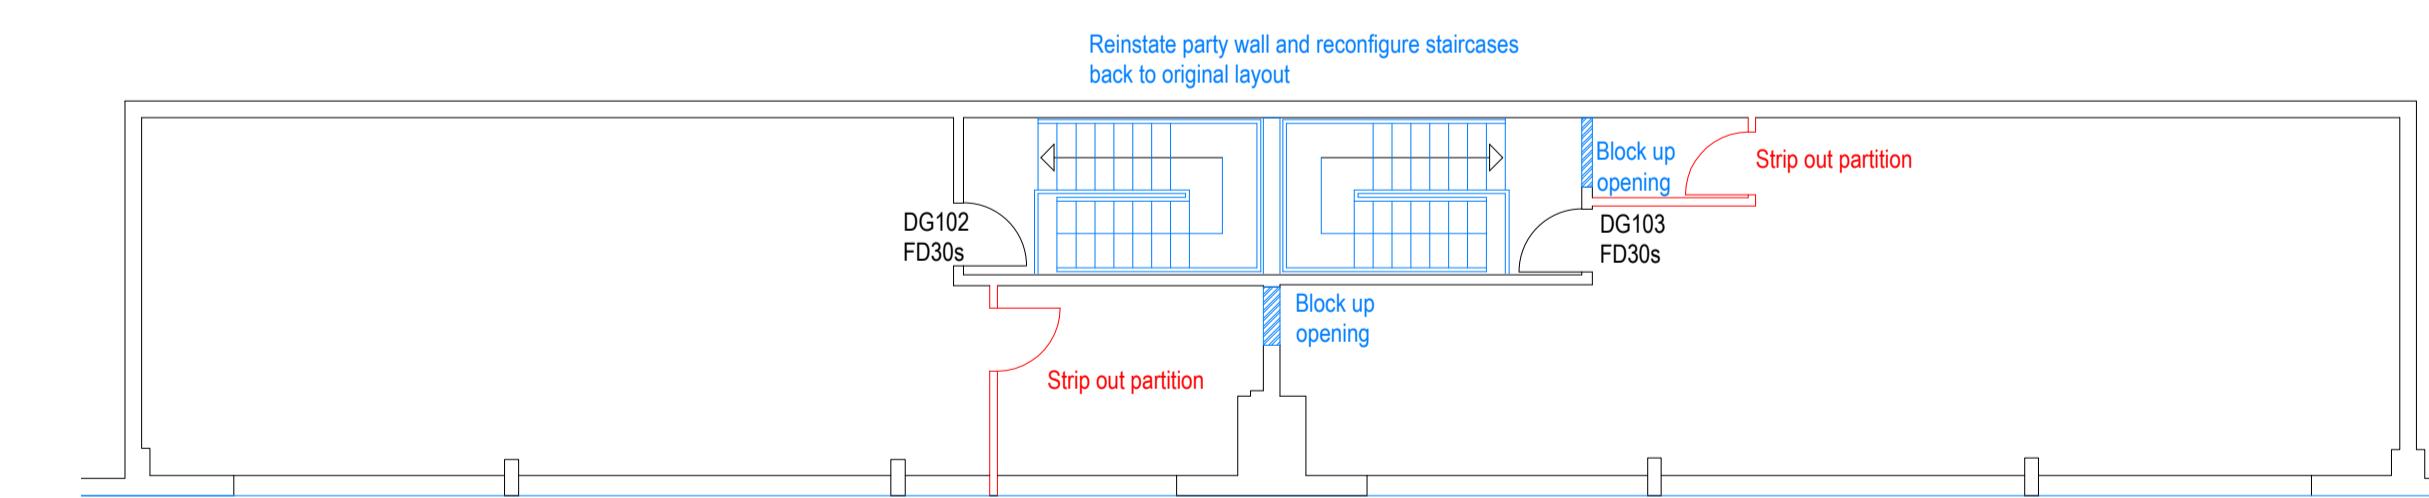

FIRST FLOOR 1:100

Rev	Description	Date	By	Chkd
	Latimer House 5-7 Cumberland Place Southampton SO15 2BH +44 (0)23 8023 2882 jll.co.uk/southampton			
	<b>JLL</b>			
	Client M&G REAL ESTATE	Scale 1 : 100/200 @ A1		
	Project UNIT O & P GRIFFIN INDUSTRIAL PARK TOTTON	Date MAY 2015	By DJB	Checked
	Description FLOOR PLANS AND ELEVATIONS AS PROPOSED	Job JLL 700127		
	Drg 700127/04	rev		

DO NOT SCALE THIS DRAWING. CHECK ALL DIMENSIONS ON SITE  
THIS DRAWING IS PROTECTED BY COPYRIGHT. IT MAY NOT BE REPRODUCED IN ANY FORM OR BY ANY  
MEANS FOR ANY PURPOSE, WITHOUT GAINING PRIOR WRITTEN PERMISSION FROM JONES LANG LASALLE