



NB | Responsibility is not accepted for errors made by others scaling from this drawing. All construction information should be taken from figured dimensions only

A3

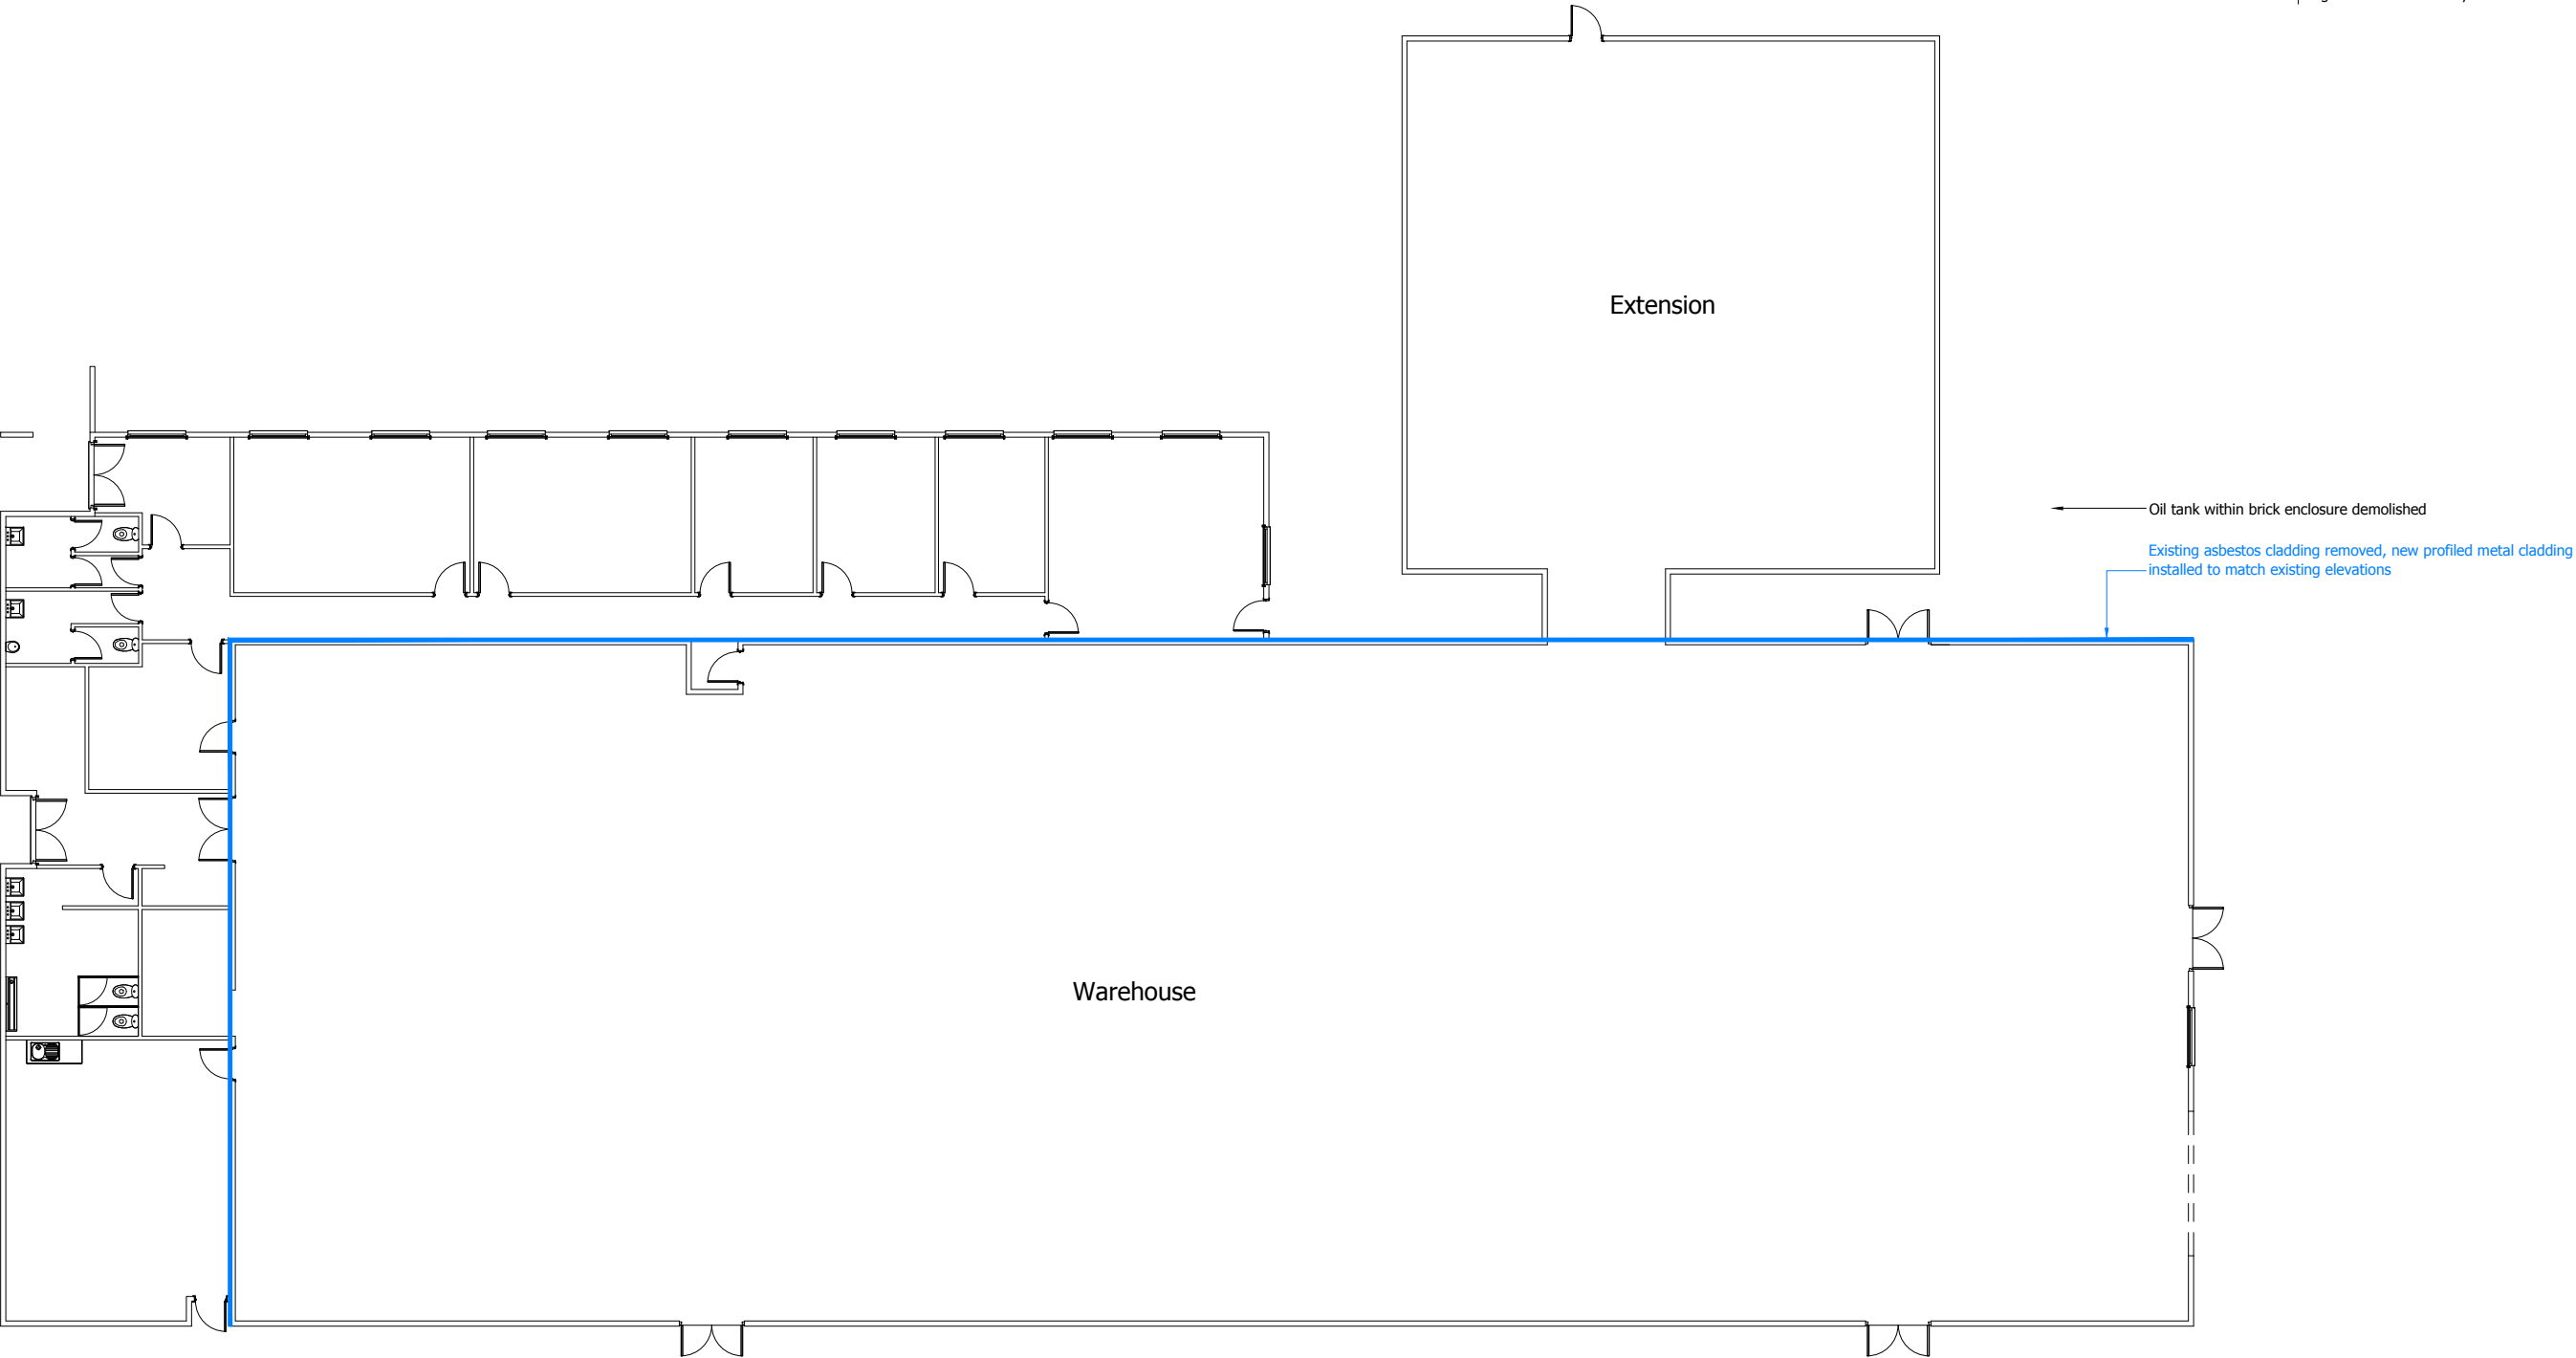

Rev	Description	By	Date
-----	-------------	----	------

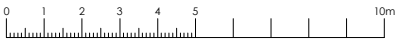

Project UNIT B10, BRIDGEND INDUSTRIAL ESTATE, BRIDGEND	Drawn by ACD	Surveyor DSW	Date JULY 2017
Client ZURICH ASSURANCE LTD PENSION	Scale 1:200 @ A3		
Title PROPOSED	Drawing Number B161921-A06-02		Revision

