


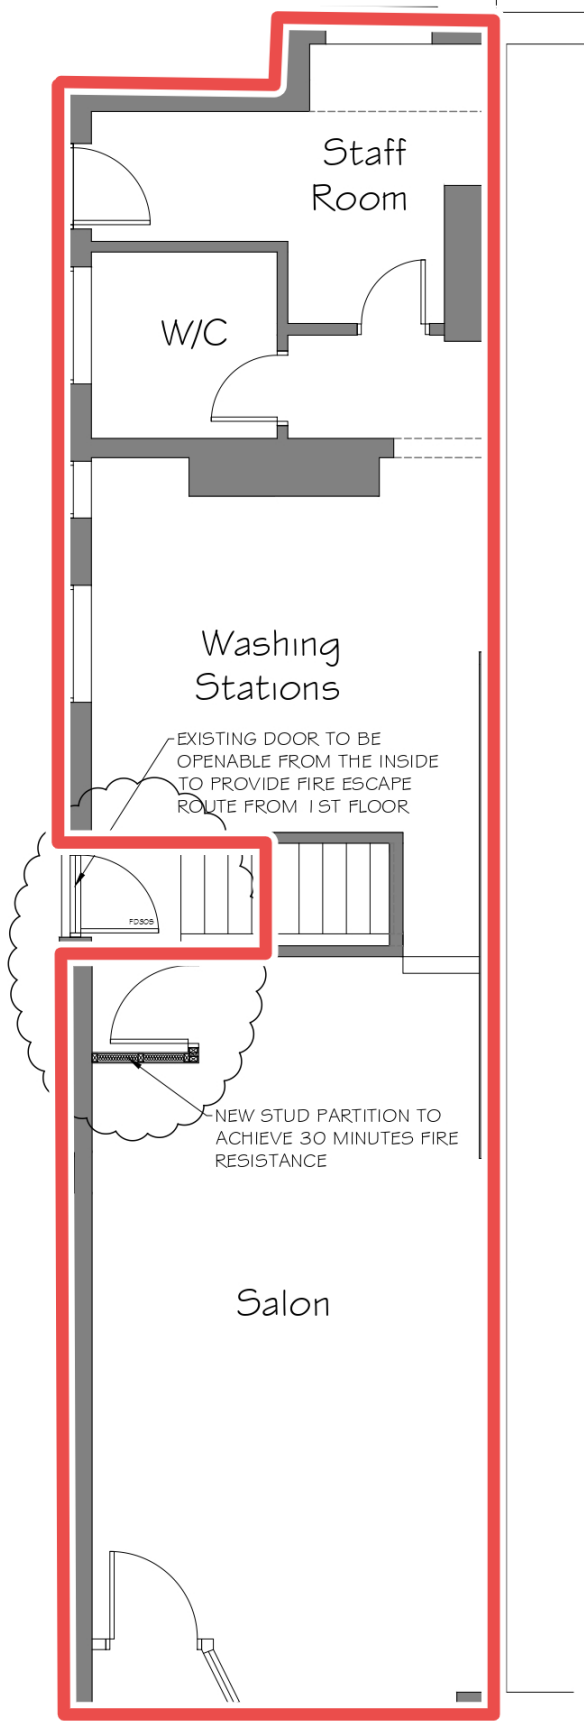


GROUND
FLOOR

NOTE



DENOTES EXTENT OF ALTERATIONS

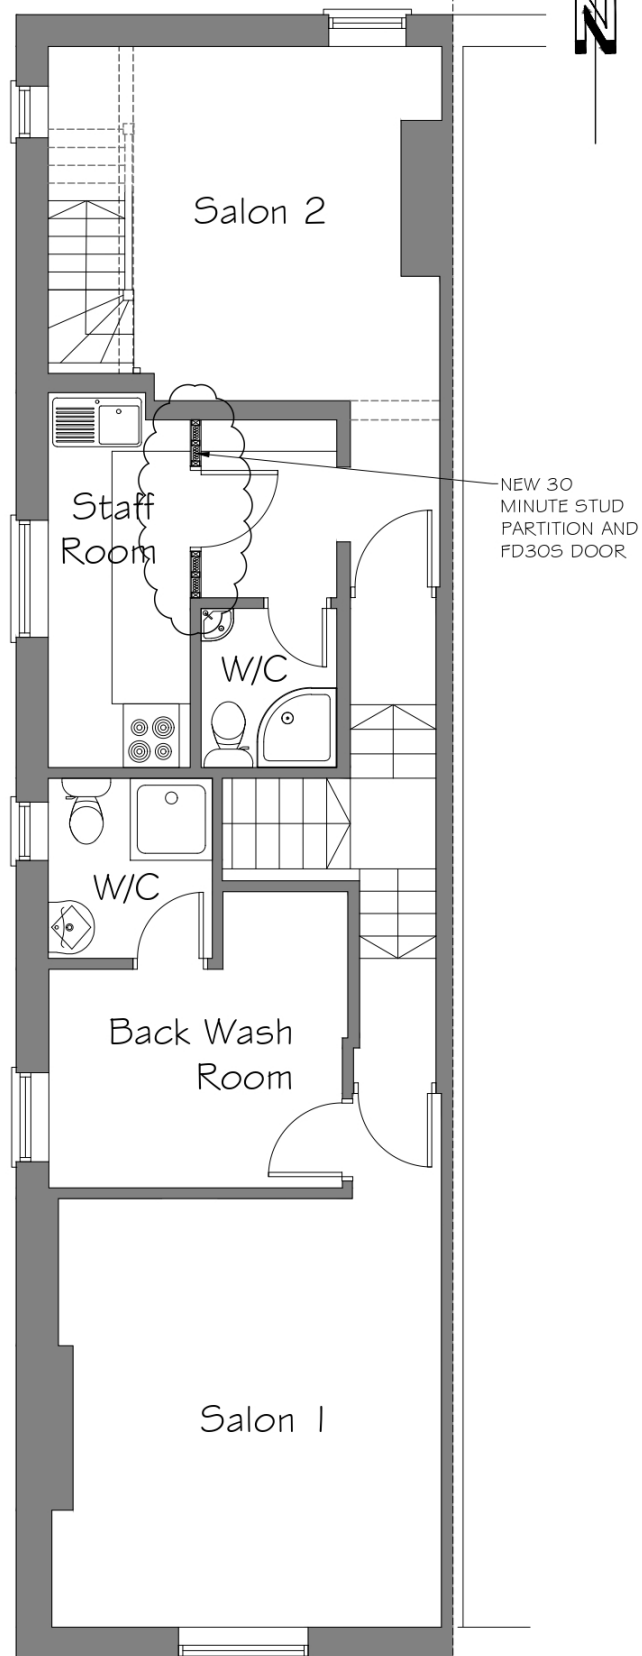

FIRST
FLOOR

PLANNING

PZ VI Architects & Planners		Project: 1ST/2ND FLOOR CHANGE OF USE 80 HEATON MOOR ROAD	
Drawing No: FP661-PL-203		Client: ASH HAIR SALON	
Drawing Title: PROPOSED GROUND AND FIRST FLOOR PLANS		Rev: 1	
Drawn By: B.M.	Checked: J. Albutt	Scale: 1:50 @ A3	Date: 17.09.2018