


**GROUND FLOOR PLAN**

1 : 50

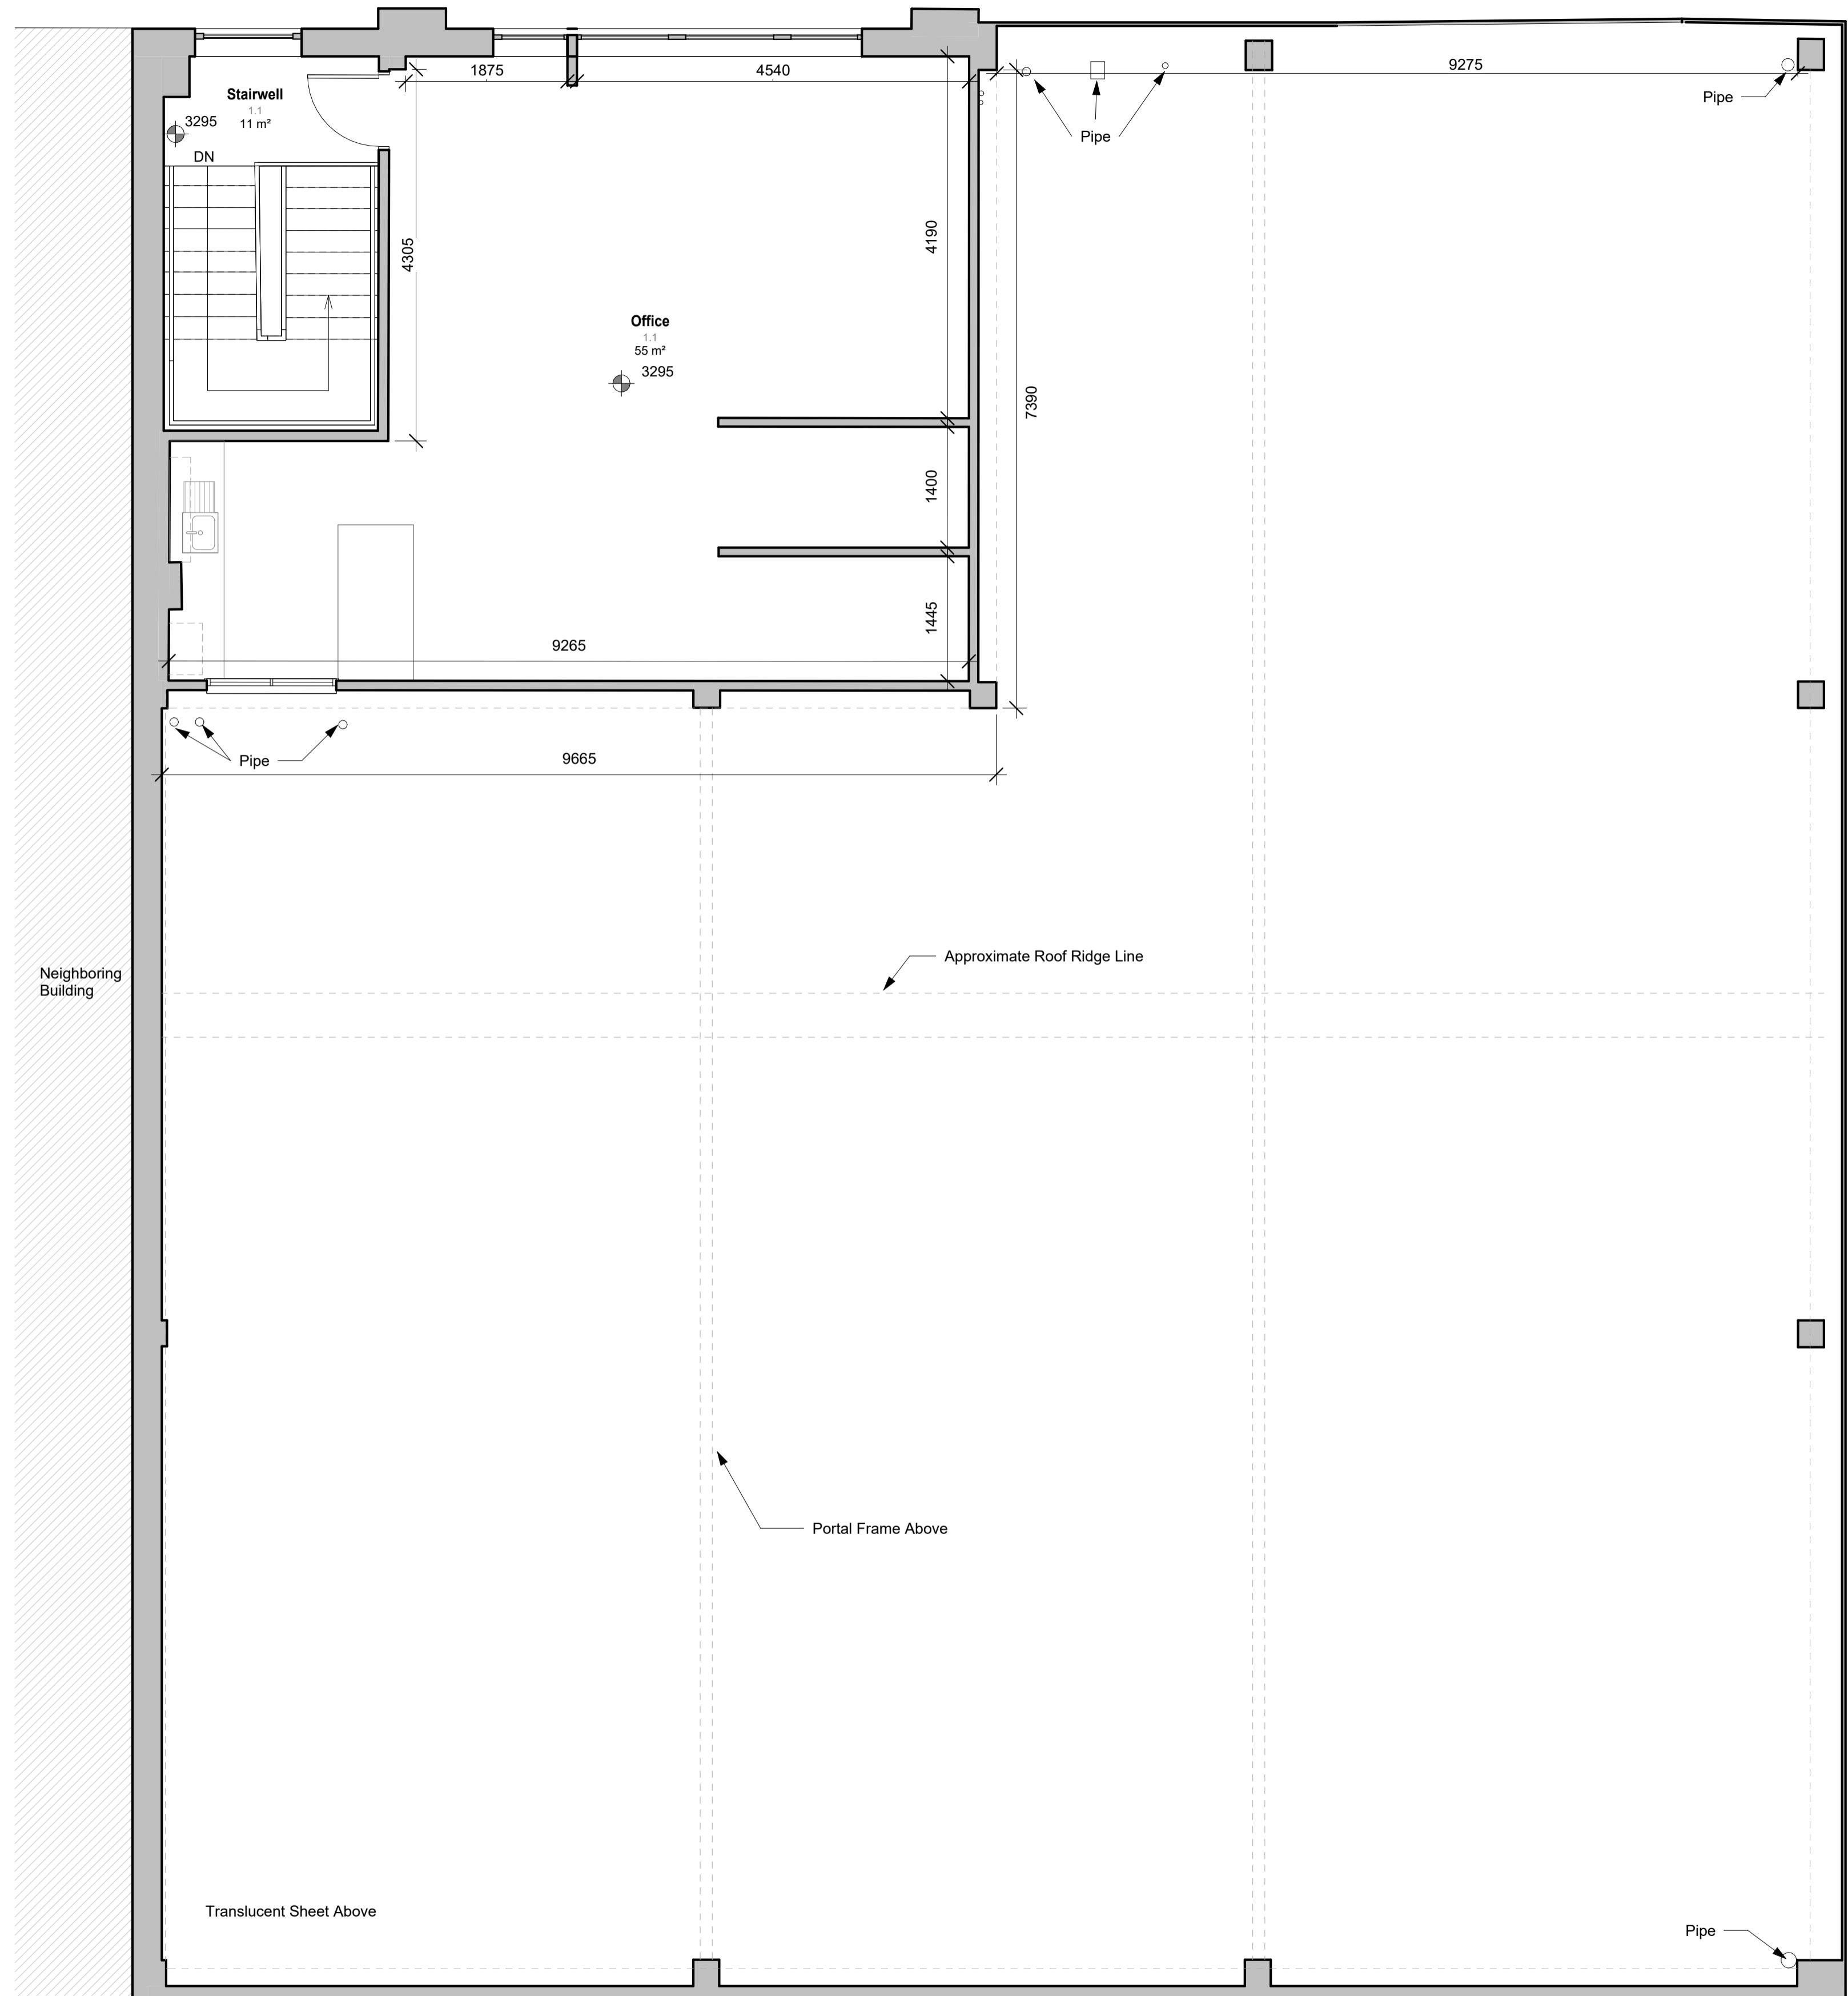

Orientation  
Scale  
1:50  
0 0.5 m 1 m 2 m 3 m 4 m 5 m



FOR INFORMATION	00	19/12/2025
Description	Rev	Date
STATUS	S2	SUITABLE FOR INFORMATION
06/12/2025	P02	
CAPTURE DATE	06/12/2025	CAPTURED BY
STAK ID	6941287c5d993f00019001010	ANDREA PINNA
OCCUPANCY	VACANT	
PRODUCTION DATE	19/12/2025	PRODUCED BY
CHECKED BY	A.ROKADE	A.ROKADE
APPROVED BY	O.MABVUU	O.MABVUU
BUILDING NAME	UNIT F	
ADDRESS	AIRPORT EXECUTIVE PARK, PRESIDENT WAY, LUTON, LU2 9NY	
DRAWING TITLE	ARCHITECTURE	PAGE SIZE
GENERAL ARRANGEMENT PLAN	FIRST FLOOR	A1
DRAWING NUMBER	03025-STAK-01-01-DR-A-1000	SCALE
		1 : 50
		REVISION
		00