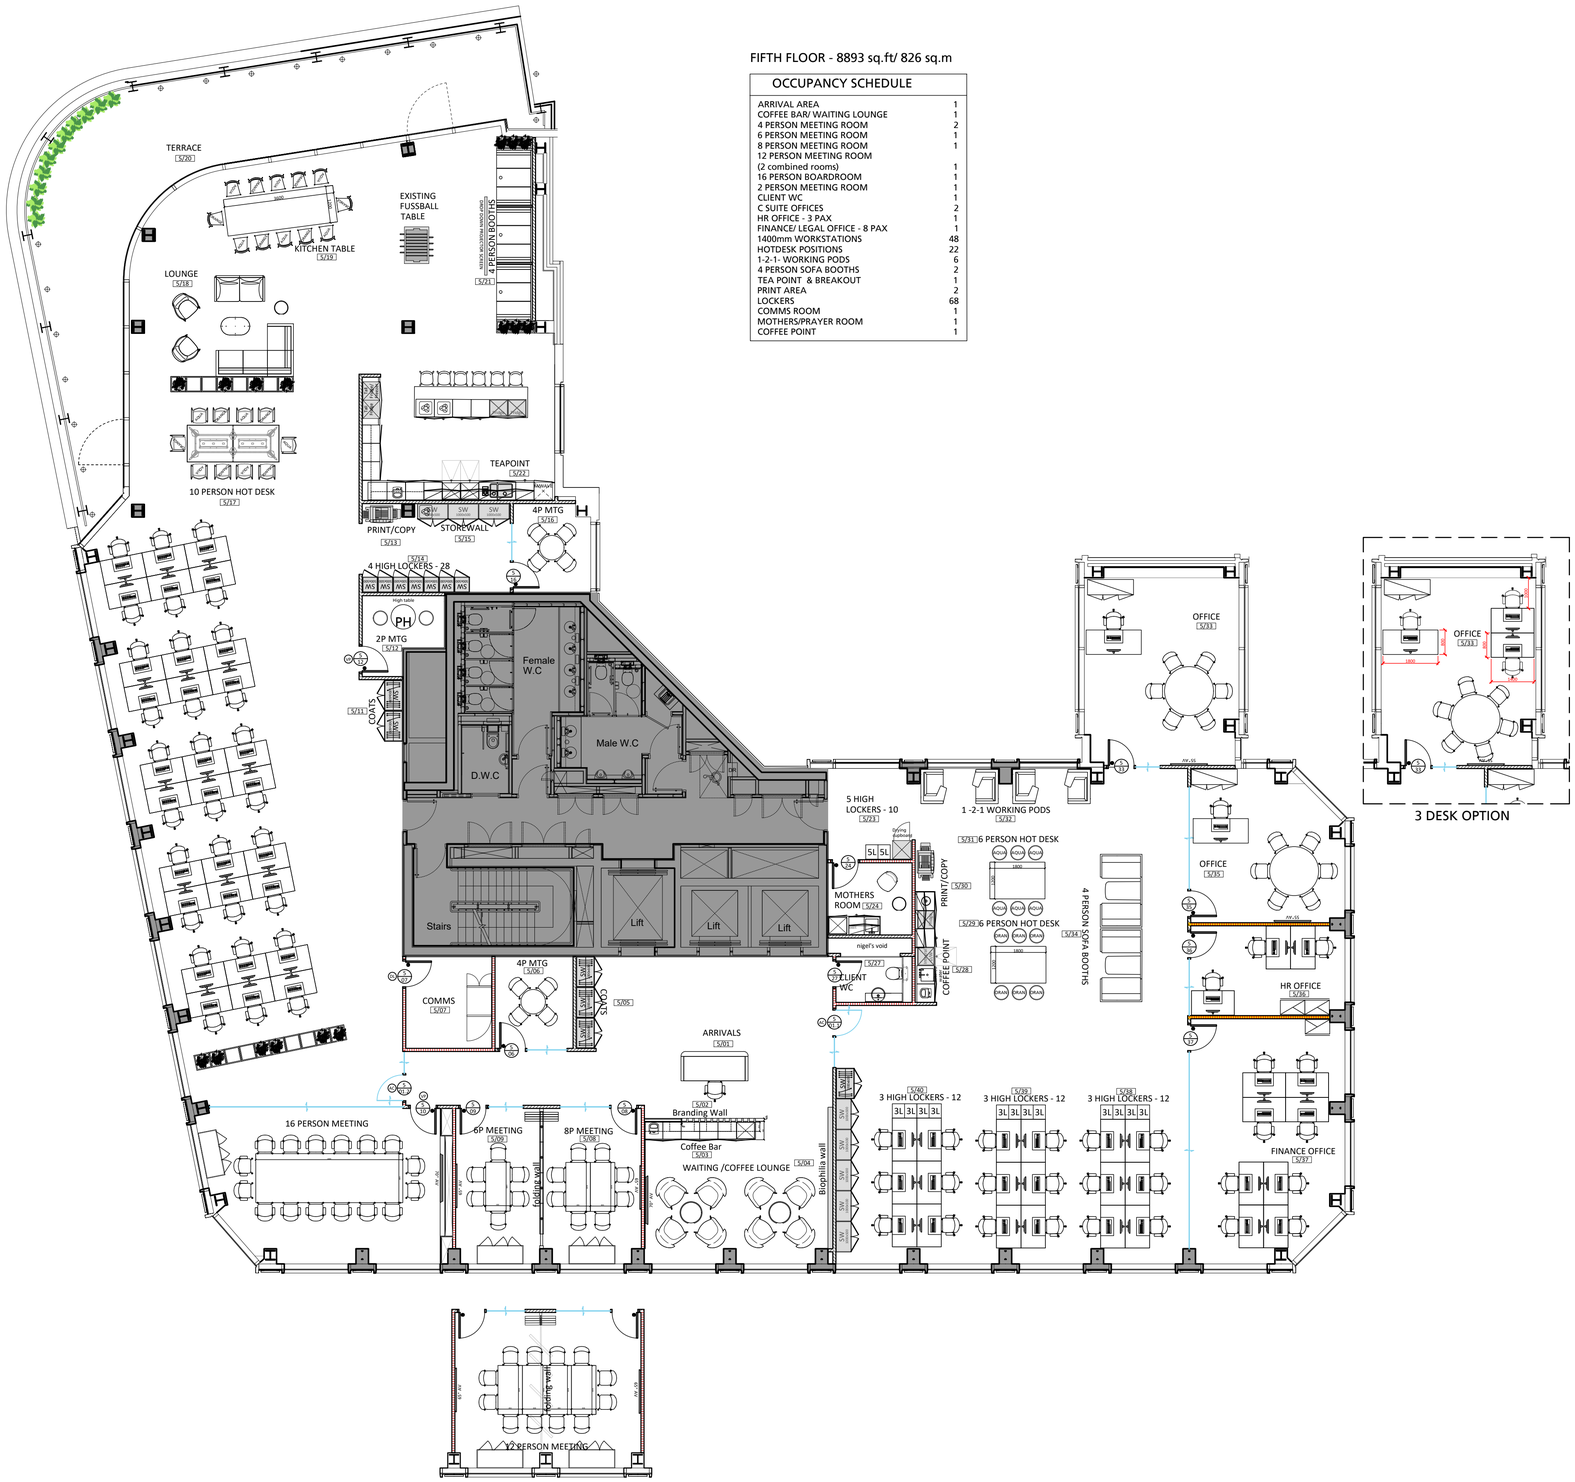

FIFTH FLOOR - 8893 sq.ft/ 826 sq.m

OCCUPANCY SCHEDULE

ARRIVAL AREA	1
COFFEE BAR/ WAITING LOUNGE	1
4 PERSON MEETING ROOM	2
6 PERSON MEETING ROOM	1
8 PERSON MEETING ROOM	1
12 PERSON MEETING ROOM (2 combined rooms)	1
16 PERSON BOARDROOM	1
2 PERSON MEETING ROOM	1
CLIENT WC	1
C SUITE OFFICES	2
HR OFFICE - 3 PAX	1
FINANCE/ LEGAL OFFICE - 8 PAX	1
1400mm WORKSTATIONS	48
HOTDESK POSITIONS	22
1-2-1- WORKING PODS	6
4 PERSON SOFA BOOTHS	2
TEA POINT & BREAKOUT	1
PRINT AREA	2
LOCKERS	68
COMMS ROOM	1
MOTHERS/PRAYER ROOM	1
COFFEE POINT	1

General Arrangement Legend

- Existing door to remain
- New single leaf door
- New double leaf door
- New leaf and a half door
- New frameless glass door
- New frameless double glass door
- New glass door with frame
- New glass double door with frame
- New sliding solid door
- New sliding glass door

- Existing partition to remain
- New 75mm solid partition constructed from FFL to 1200mm from FFL
- New 100mm solid partition constructed from FFL to suspended ceiling level
- New 100mm solid partition constructed from slab to slab
- New 100mm solid partition constructed from floor slab to suspended ceiling level with acoustic barrier above
- Existing Glazing to Remain
- New full height, single glazed partition
- New full height, double glazed partition

- Storage Wall Unit - 500mm deep
- Storage Wall Unit - 600mm deep
- Storage Wall Unit - 600mm deep with coat rail and hat shelf
- Room Label - Floor / Room No
- Door Label - Floor / Room No
- Vision Panel
- Self Closing Device
- Digital Keypad Lock
- Electronic Access Control
- 60 Minute Fire Rated Door
- 30 Minute Fire Rated Door

N

THIS DRAWING IS PROTECTED UNDER COPYRIGHT. THIS DRAWING IS NOT TO BE REPRODUCED IN WHOLE OR PART UNLESS AUTHORISED BY area © COPYRIGHT

THIS DRAWING IS NOT TO BE SCALED

THE GENERAL CONTRACTOR IS TO CHECK ALL DIMENSIONS AND NOTIFY THE DESIGNERS OF ANY DISCREPANCIES OR OMISSIONS.

DRAWING TO BE READ IN CONJUNCTION WITH SCOPE OF WORKS

CEILING HEIGHT	
BEAM HEIGHT	
WINDOW HEIGHT	
SILL HEIGHT	

DATE	REV	REVISIONS	SIGN	CHKD
31.05.22	G	AS BUILT ISSUE	PH	--
28.04.22	F	PARTITION BACKING ONTO FOLDING WALL UPDATED DUE TO FOLDING WALL WIDTH	PH	--
ON GOING	E	STORAGE UNITS TO HR AND FINANCE OFFICE UPDATED AS PER AL FEEDBACK	PH	AL
17.03.22	D	CONSTRUCTION ISSUE FRONT PARTITION AND DOOR TO CEO OFFICE 5/33 UPDATED TO ALLOW AV SCREEN TO BE ALIGNED WITH CENTRE OF CIRCULAR TABLE; QUANTITY OF LOCKERS UPDATED 5/14 + 5/23.	PH	AL
17.03.22	C	CONSTRUCTION ISSUE UPDATED TO LATEST AGREED SPACEPLAN; MOTHERS ROOM LOCATION UPDATED AND SHOWERS OMITED; PREVIOUS MOTHERS ROOM LOCATION CHANGED TO 2P MTG RM	PH	AL
25.02.22	B	CONTRACT ISSUE	PH	--
17.02.22	A	LANDLORD ISSUE UPDATED TO SP6_A	PH	AL
26.01.22	-	FIRST ISSUED	AL	

area

The Old Post Office
33 Station Road,
Egham,
Surrey TW20 9LA

T. 01784 274000

info@area.co.uk

3rd Floor,
Chapter House,
18-20 Crucifix Lane,
London SE1 3JW

T. 020 7089 6000

www.area.co.uk

DRAWING STATUS

AS BUILT

CLIENT

SITE IMPROVE
-

PROJECT

24 MONUMENT STREET
LONDON
EC3R 8AJ
-

TITLE

FIFTH FLOOR
GENERAL ARRANGEMENT
OPTION 6

SCALE 1:100 @ A1

DATE 02/11/21 | DRAWN AL | CHECKED -

PROJECT NO	BLDG.	FLOOR	DETAIL	REV.
AR30741	1	5	GA	G