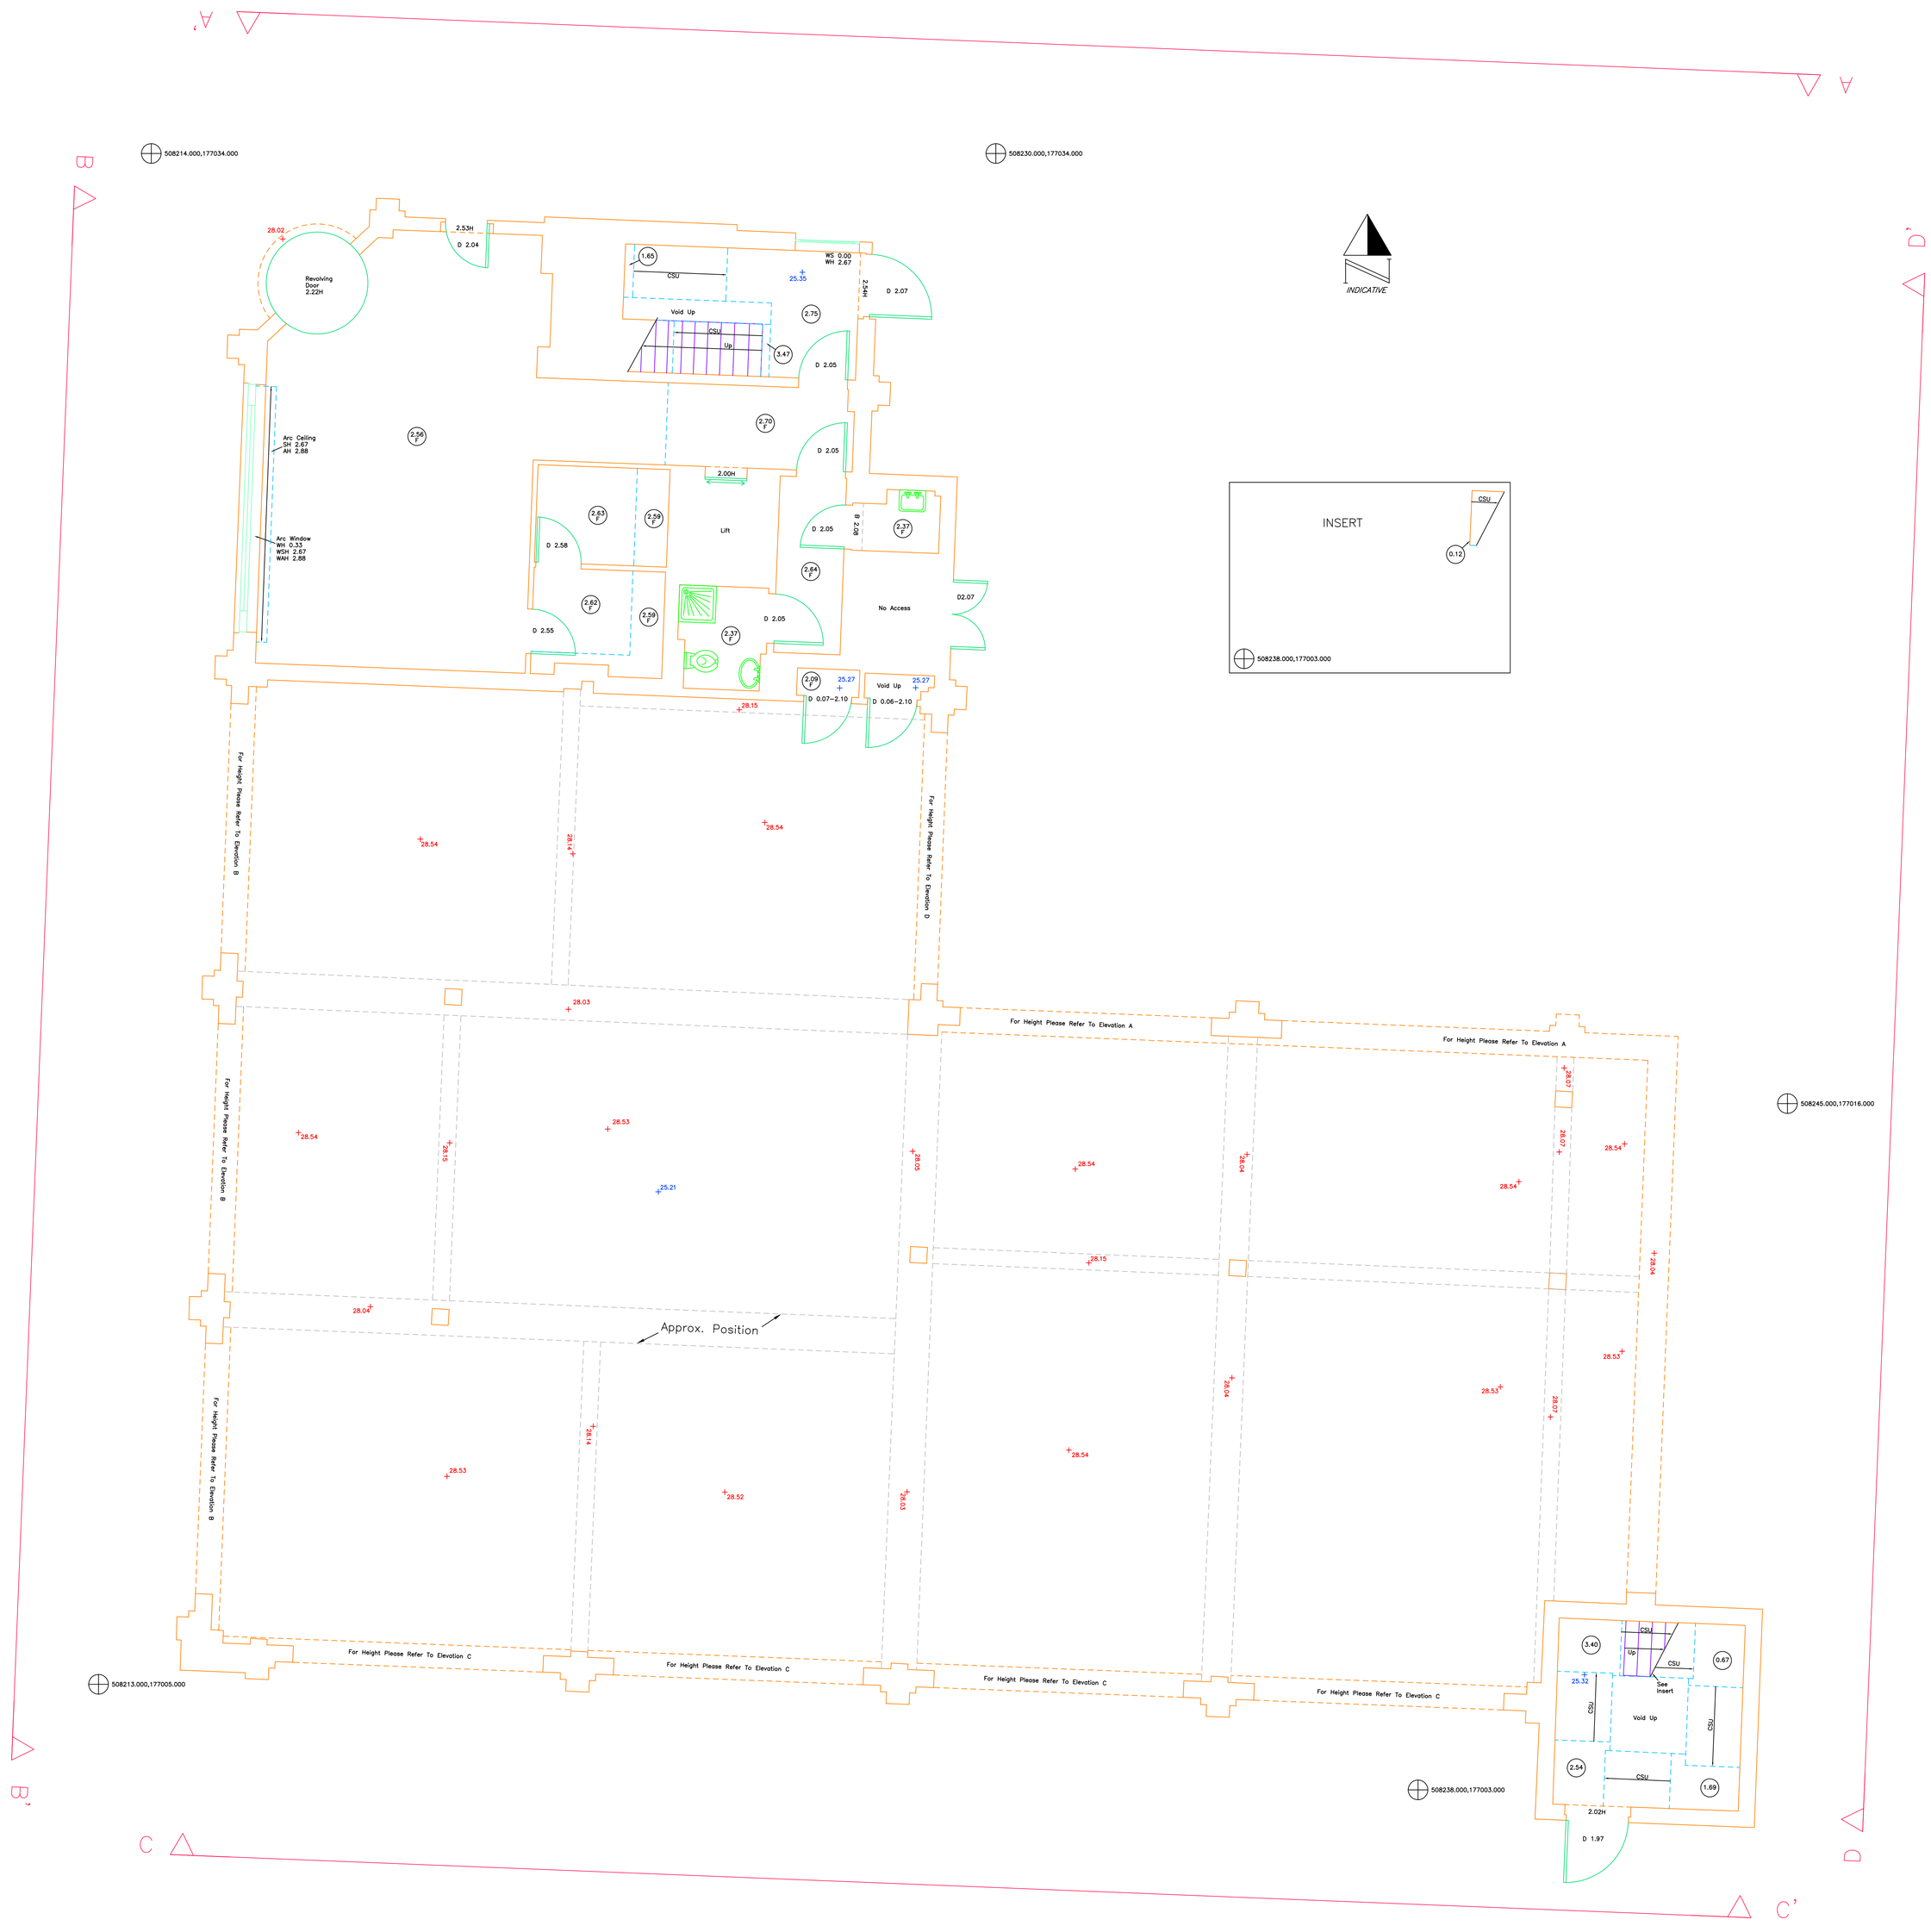

SURVEYED BY

PREMIER SURVEYS LIMITED

PREMIER SURVEYS LIMITED
FLOOR ONE UNIT 2
ELLESMERE BUSINESS PARK
HAYDN ROAD
NOTTINGHAM
NG5 1DX

Tel: 0115 9622876

OUR REF 6297

LEGEND

SURVEY STATION
BANK
CEILING HEIGHT
FLOOR BOARD DIRECTION
× 12.34 LEVEL POSITION
REGISTRATION MARK
SAPLING
BUSH
BUILDING
BUILDING CANOPY

W — FRESH WATER
E — O/H ELECTRICITY
E — U/G ELECTRICITY
T — O/H TELEPHONE
T — U/G TELEPHONE
G — GAS
CTV — CABLE TELEVISION
FOUL DRAINAGE
STORM DRAINAGE
HEDGE
FENCE
GATE

ABBREVIATIONS (Where Applicable)

AC	AIR CONDITIONING UNIT	IC	INSPECTION COVER
AH	ARCH HEIGHT	IL	INVERT LEVEL
ASS	ASSUMED CONNECTION	LP	LAMP POST
B	BEAM	LS	LIGHT SWITCH
BH	BEAM HEIGHT	MKR	MARKER
BGP	BREAK GLASS POINT	NB	NOTICE BOARD
BOL	BOLLARD	NI	NOTICE INFORMATION
BSP	BUS STOP POST	NP	STREET NAME PLATE
BW	BRICK WALL	O/H	OVERHEAD
CAB	CABINET	P	PIPE
CDU	CABLE DUCT	PL	PAVEMENT LIGHT
CE	CLEANING EYE	RAD	RADIATOR
CL	COVER LEVEL	RG	ROAD GULLEY
CLR	CLEAR WINDOW	RL	RAIL LEVEL
CONC	CONCRETE	RSJ	ROLLED STEEL JOIST
CPG	CONC. PAVING SLABS	RW	RETAINING WALL
CTV	CABLE TELEVISION	SAP	SANITARY APP. PIPE
CTV	CABLE TELEVISION	SC	STOP COCK
D	DOOR HEIGHT	SH	SPRING HEIGHT
DP	DOWN PIPE	SL	SOFFIT LEVEL
ECP	ELEC. CABLE PIT	SL	SUMP LEVEL
EO	ELECTRODE 'O'	SV	SLUICE VALVE
ECB	ELECTRICITY BOX	TCP	TELEPHONE PIPE
EP	ELECTRICITY POLE	TCB	TELEPHONE CALL BOX
FR	EARTHING ROD	TC	TELECOMMUNICATIONS IC
FH	FIRE HOSE	TP	TELEPHONE POLE
FH	FIRE HYDRANT	TS	TELEPHONE POLE
FTG	FEEDS INTO GROUND	TS	TRAFFIC SIGNAL
FP	FENCE PALIS	TSG1	TRAFFIC SIGNAL 1C
FP	FEEDER PILLAR	TSC	TRAFFIC SIGNAL 4C
G	GULLEY	UTL	UNABLE TO LIFT
GV	GAS VALVE	VP	VENT PIPE
H	HEIGHT	WH	WINDOW HEAD HEIGHT
HB	HAND BASIN	WM	WATER METER
HD	HEATING DUCT	WSH	WINDOW SILL HEIGHT
HYD	HYDRANT	WV	WATER VALVE

FENCE TYPES AND DETAILS

BWF	BARBED WIRE	OBF	OPEN BOARD FENCE
CBF	CLOSED BOARDED	PBF	POST & RAIL
CLF	CHAIN LINK	PWF	POST & WIRE
CPF	CHESTNUT PALING	RF	PANEL
GDR	GUARD RAIL	RL	RAILINGS
IRF	IRON RAILINGS	(SEC)	SECURITY

LEVEL DATUM

DATUM USED : OS GPS ACTIVE NETWORK

REVISION

No.	DATE	REVISION

CORSTORPHINE + WRIGHT
ONE MORTIMER STREET
LONDON
W1T 3JA

JOB TITLE
5 MONDIAL WAY
BATH ROAD
HEATHROW
MIDDLESEX
UB3 5AR

DRAWING TITLE
GROUND FLOOR

SURVEYOR: OH	DRAWN: OH	CHECKED: AW
SCALE 1/50		SHEET No: SHEET 1 OF 1
DATE FEB 2017	SHEET SIZE A0	DRAWING No: 6297_GROUND_R0