


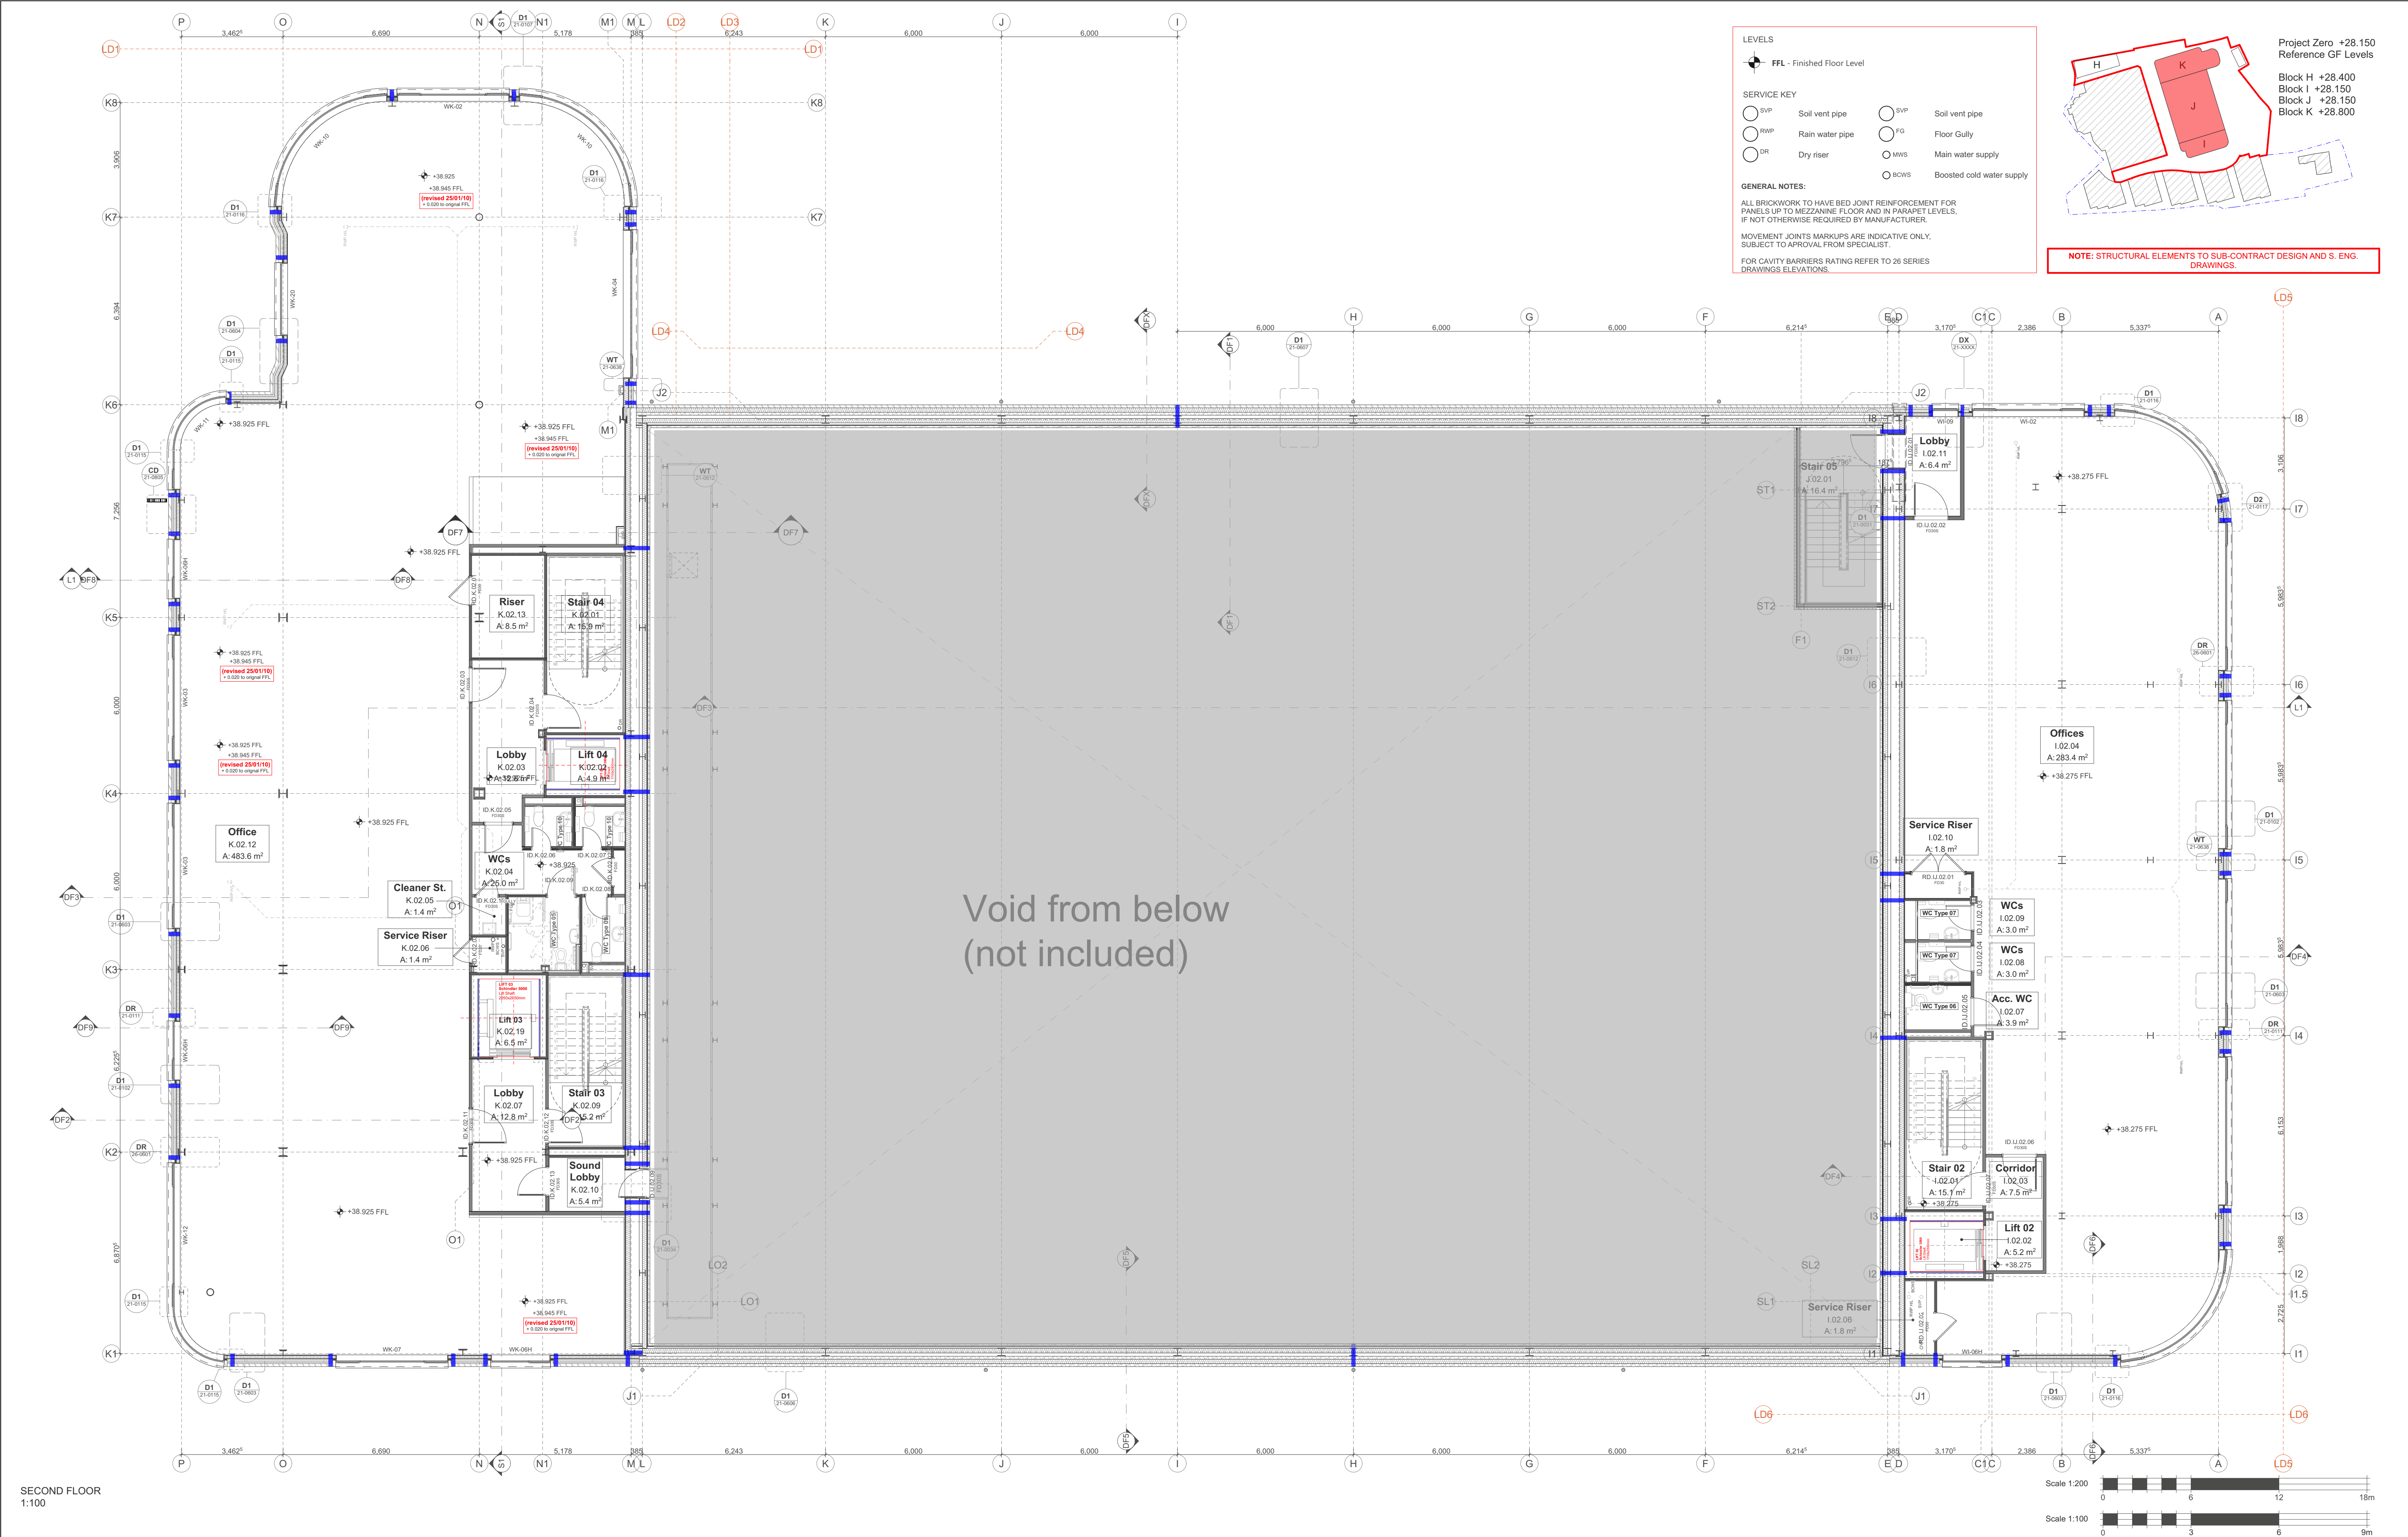

SECOND FLOOR
1:100

												CDA Ref 686				Drawing Number			
												Scale(s) (1:100 A1) 1:200 @ A3				Project Originator Volume Level Type Role Class Number G1151 CDA IJK 02 DR A 20 0103			
																Revision Suitability Revision Description CR01 CR Constructed Record			