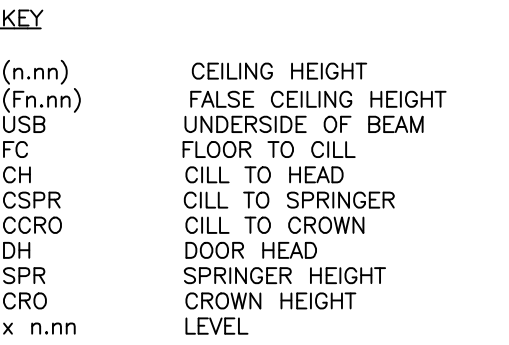


[illegible]

2nd floor

2.65

2.60

3.06

3.05

2.9 L

2nd floor

[illegible]

Signature	Amendment	Date	Rev.
 GRYPHON SURVEYS Unit 5, Copfold Hall Farm, Writtle Road, Margarettin, Essex, CM4 0EL Telephone: 01277 212794 e-mail: admin@gryphonsurveys.co.uk			
Job Title: 39/41 GREAT PORTLAND STREET LONDON W1		Drawn: SG	
		Checked:	
Description FLOOR PLANS		Scale: 1:100@A1	
		Date: 08/25	
		Ref: G8242-1	