


Proposed Ground Floor Plan

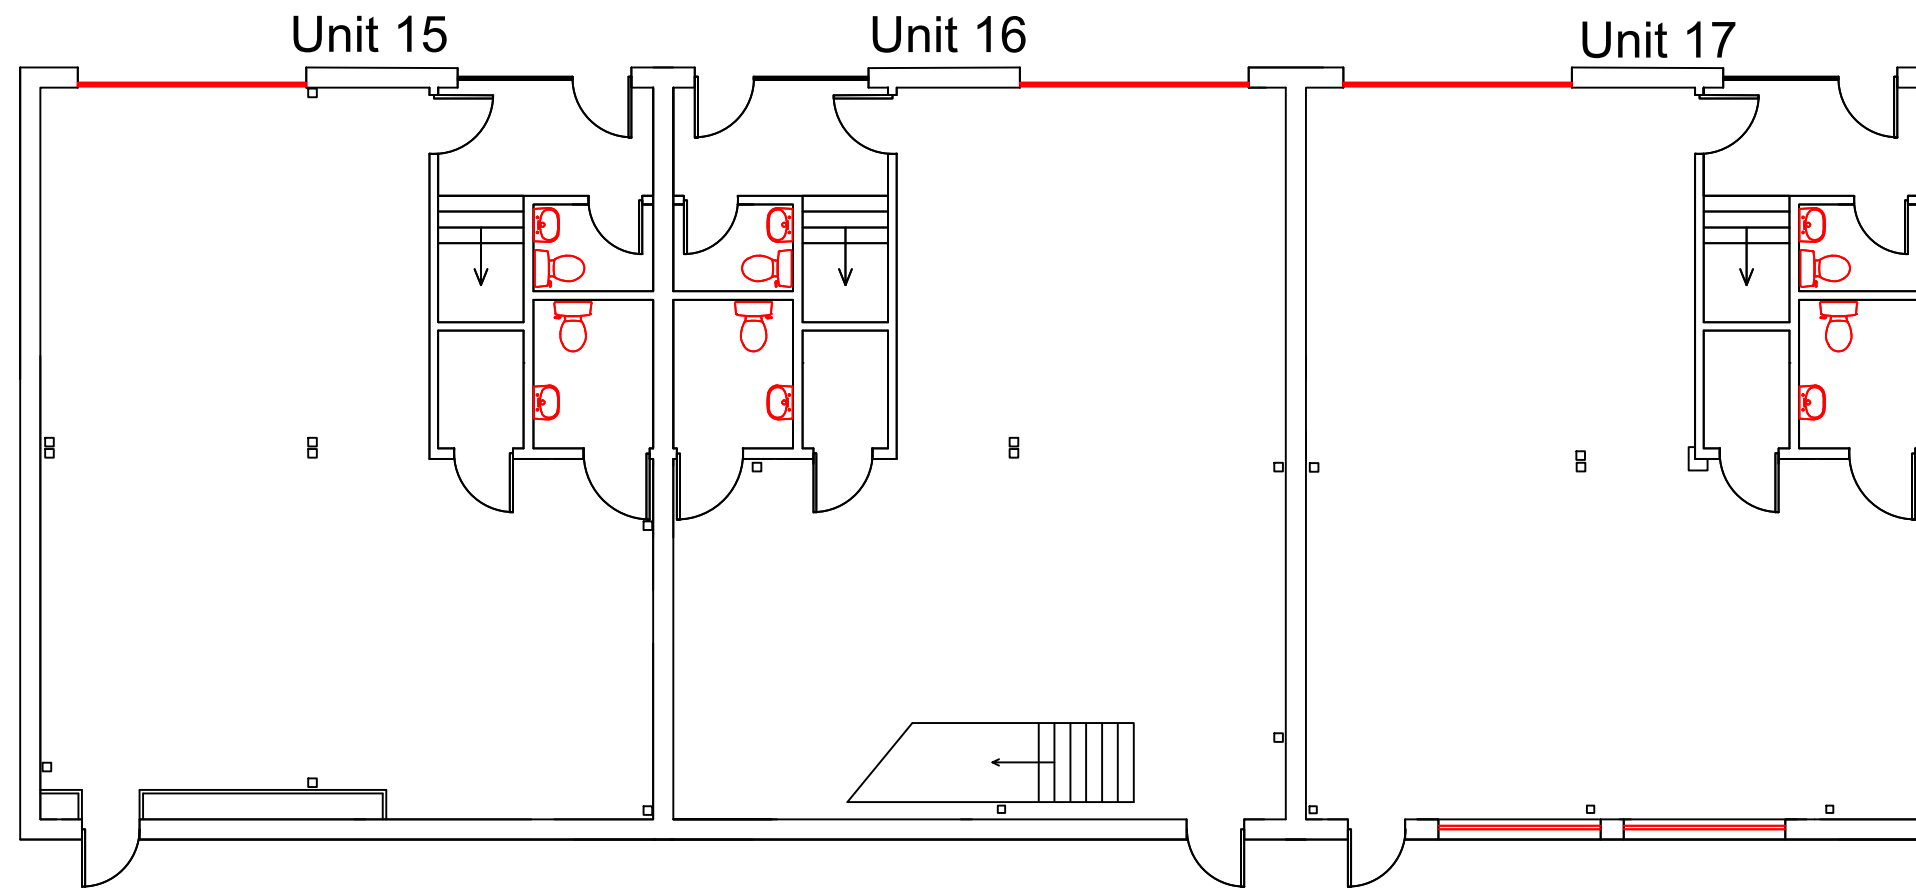

Proposed First Floor Plan

