



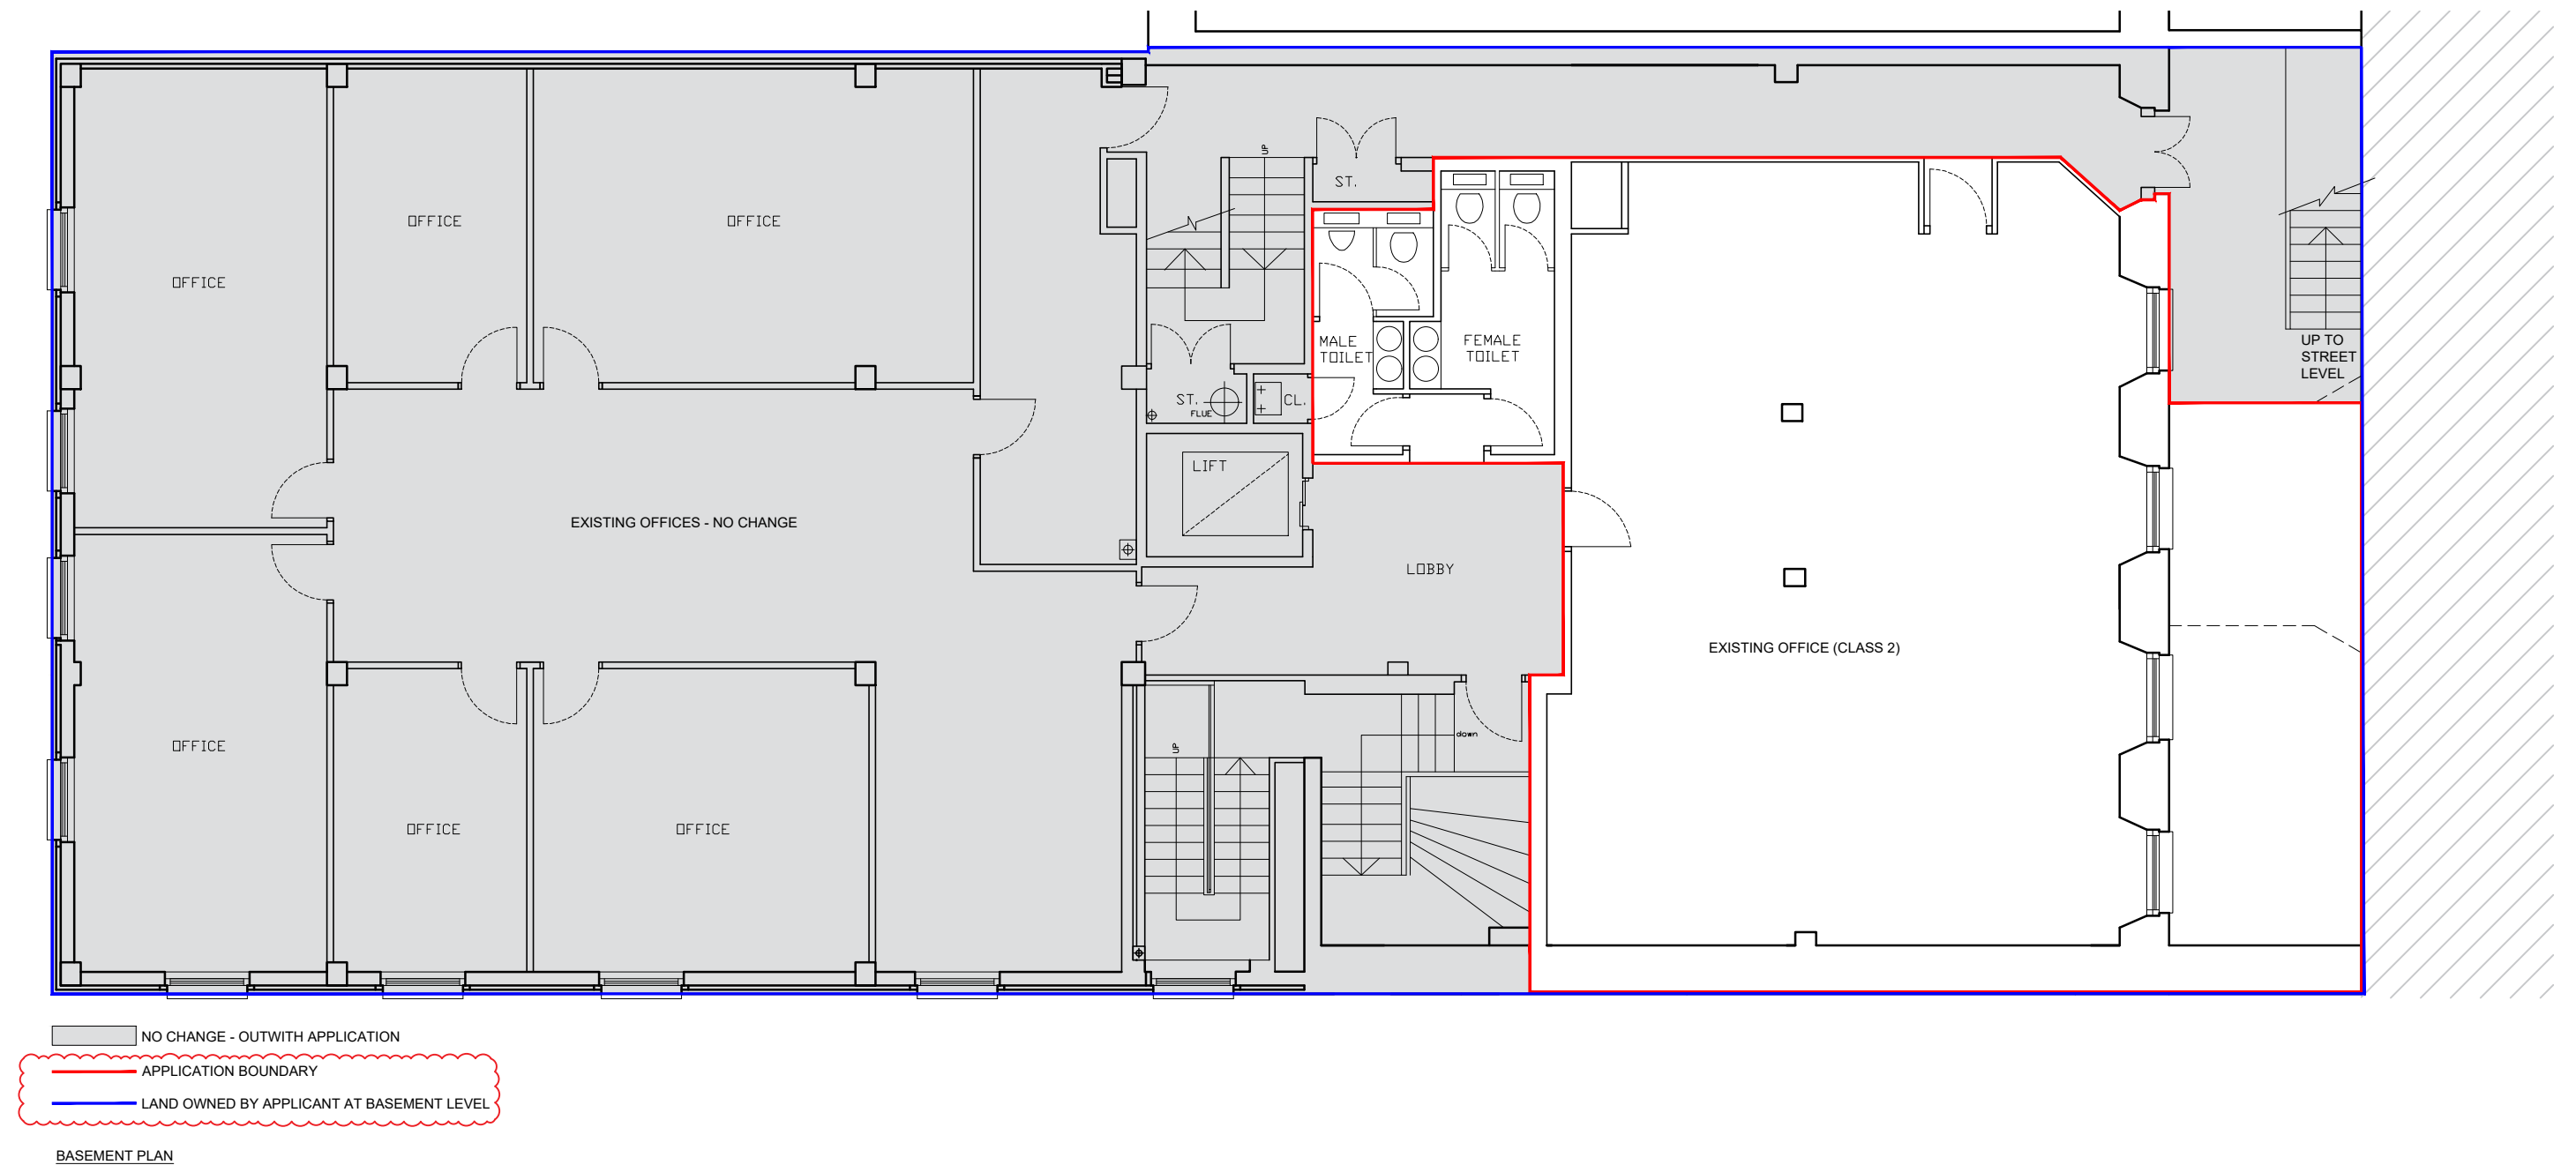

SCALE BAR 1:100

0.2m 2m 4m 6m 8m 10m

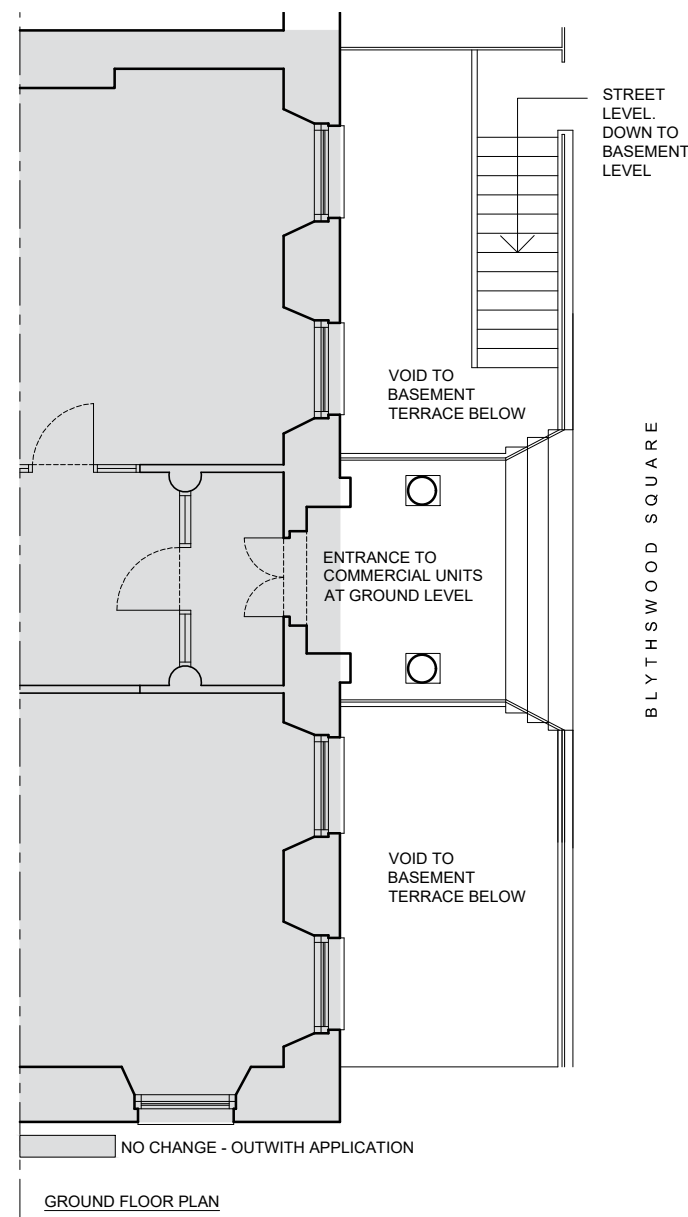

A ELEVATION ADDED INLINE WITH BCO COMMENTS RM 03.05.22

ALL SIZES TO BE TAKEN AND CHECKED ON SITE BY THE CONTRACTOR PRIOR TO PREPARATION OF SHOP DRAWINGS OR FABRICATION OF PARTS THIS DRAWING SHOULD NOT BE SCALED. ANY DISCREPANCIES TO BE BROUGHT TO THE IMMEDIATE ATTENTION OF THE ARCHITECT COPYRIGHT OF DESIGN AND DRAWING RESERVED REV DESCRIPTION

BY DATE