




-  = Proposed stud wall
-  = Proposed glazing
-  = New vinyl flooring

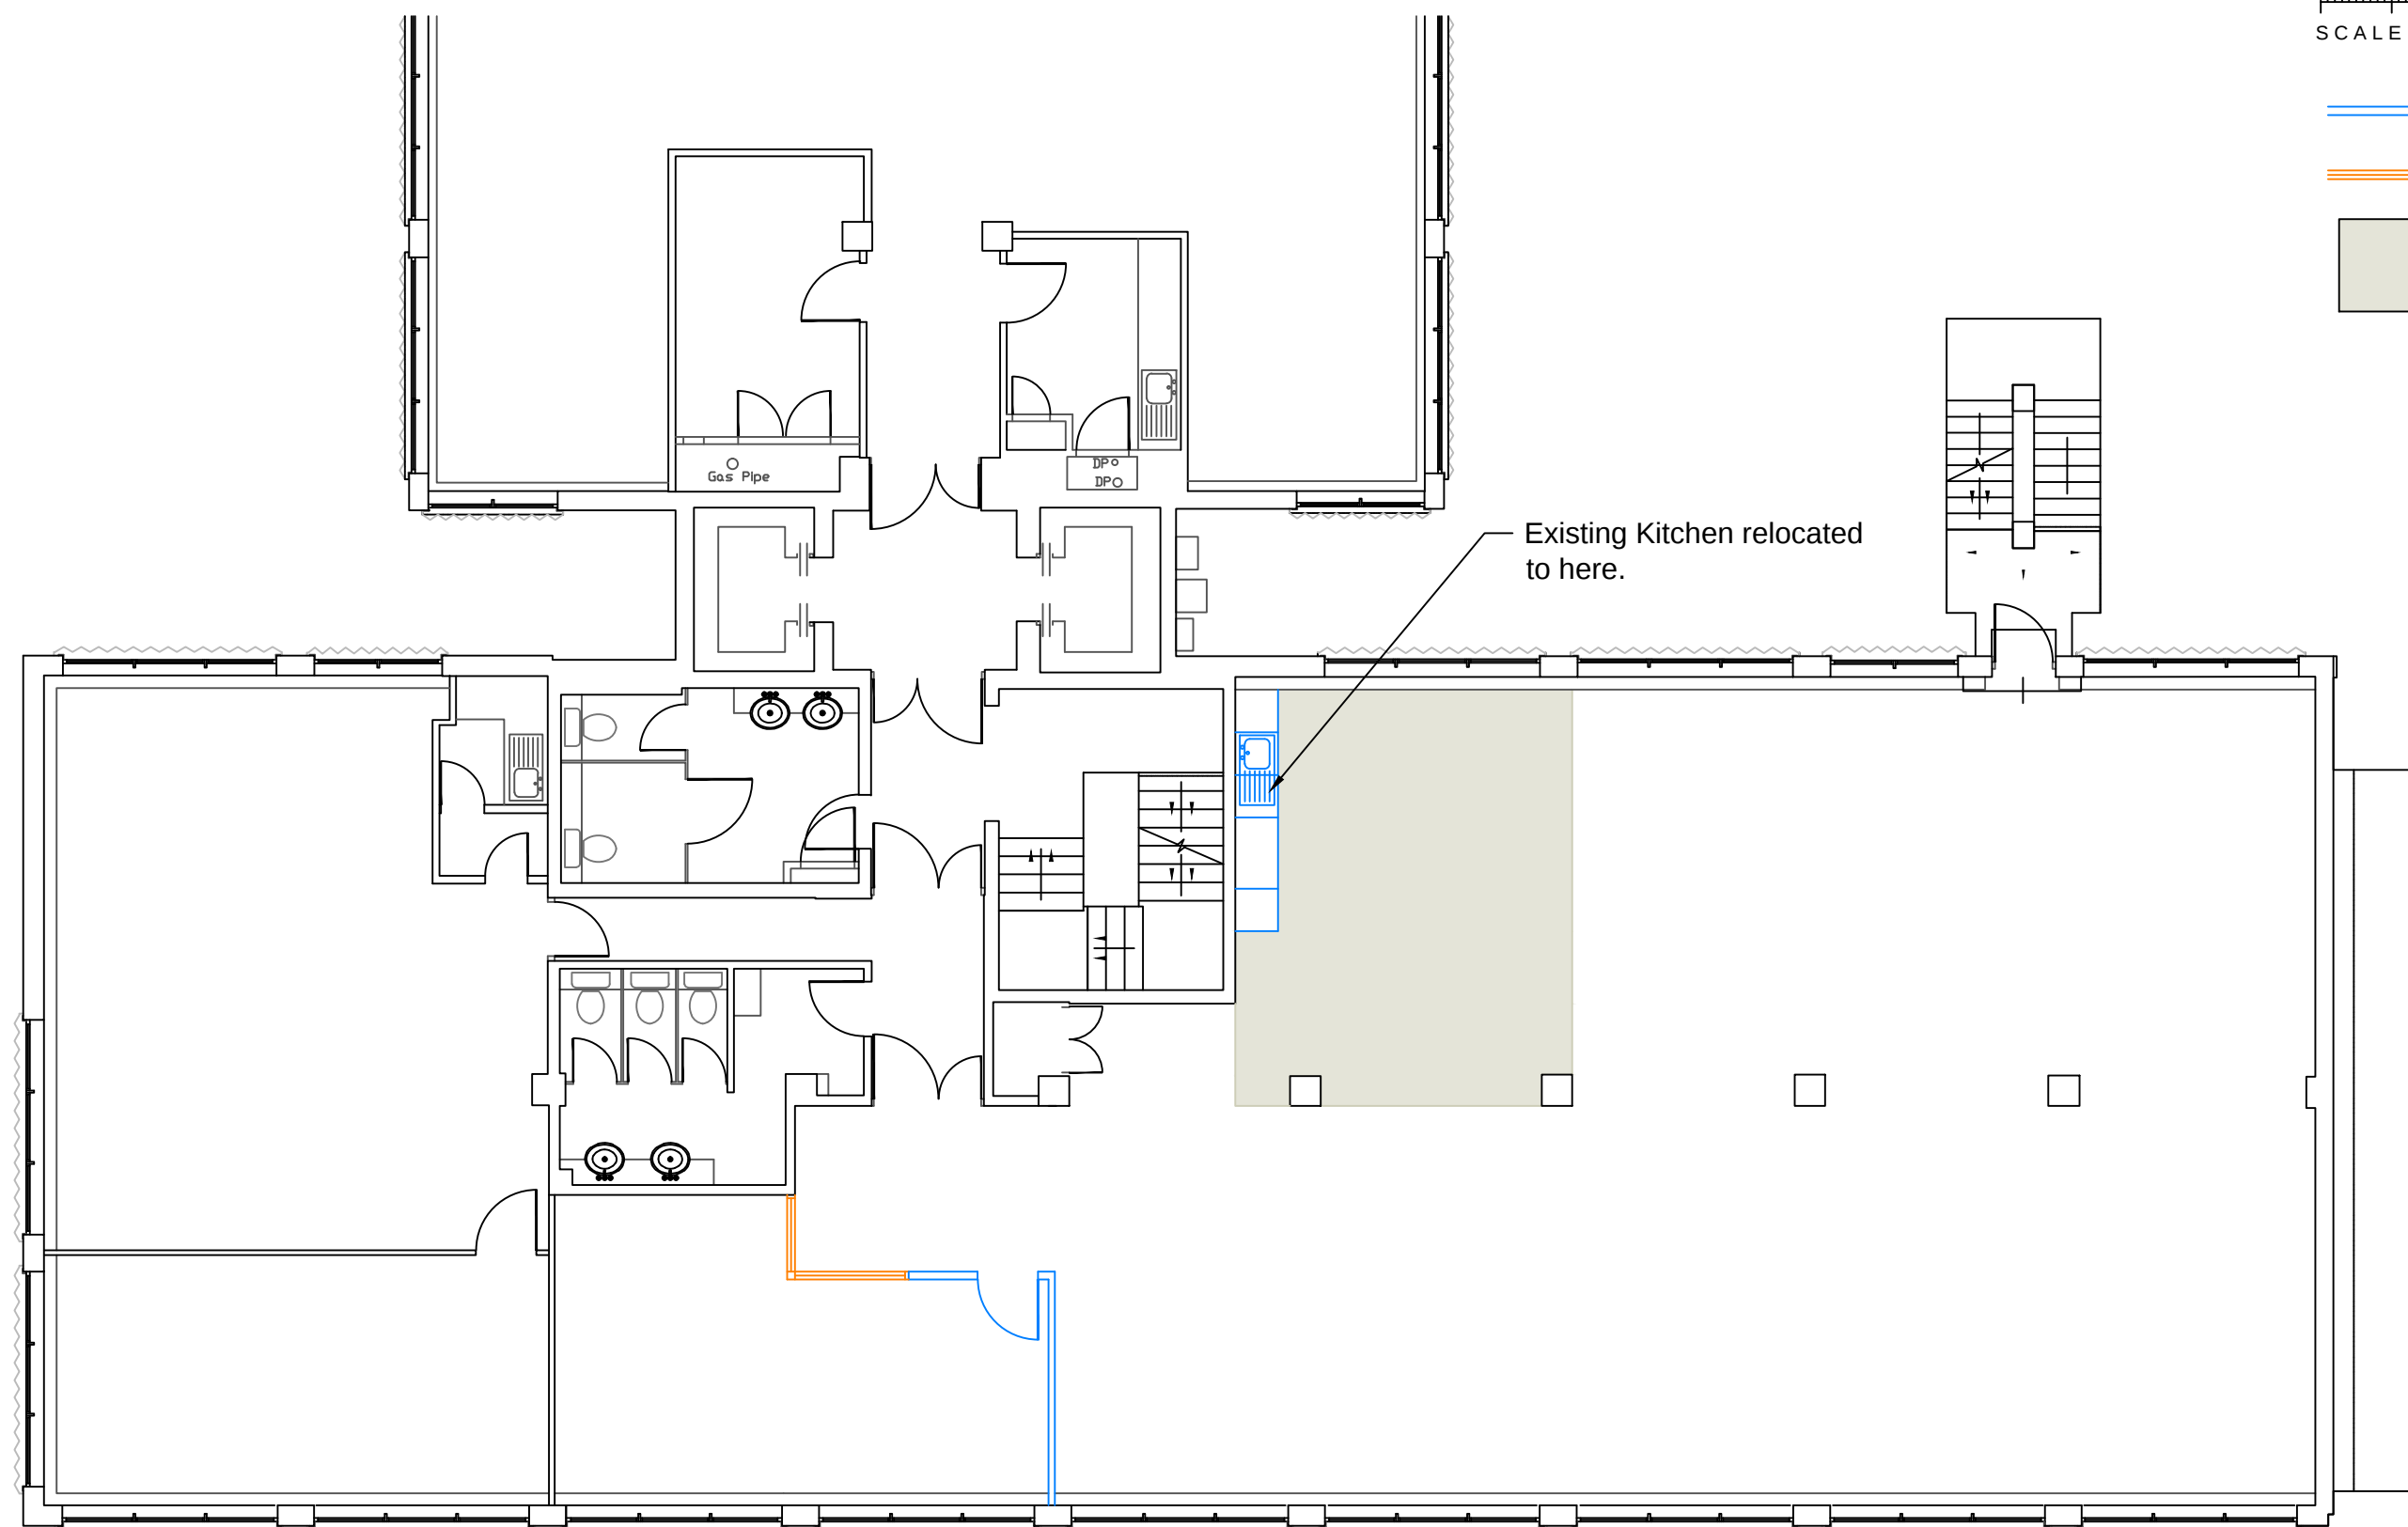

Second Floor Plan
As Proposed



White Building
Queens Keep
1-4 Cumberland Place
Southampton

Second Floor Plan
As Proposed

Drawing No JHP RS467 - 003

Scale A3@1:100 Revision

Date Dec 2025