


This drawing is the property of Woodalls Design LLP and may not be copied or reproduced without consent. All dimensions must be checked on site before commencing work. No dimensions to be scaled from drawing. Woodalls Design LLP asserts full Intellectual Property Rights in connection with designs, layouts and information contained within this drawing. Rights are transferred to the named client only upon receipt of full agreed payment in connection with services provided.

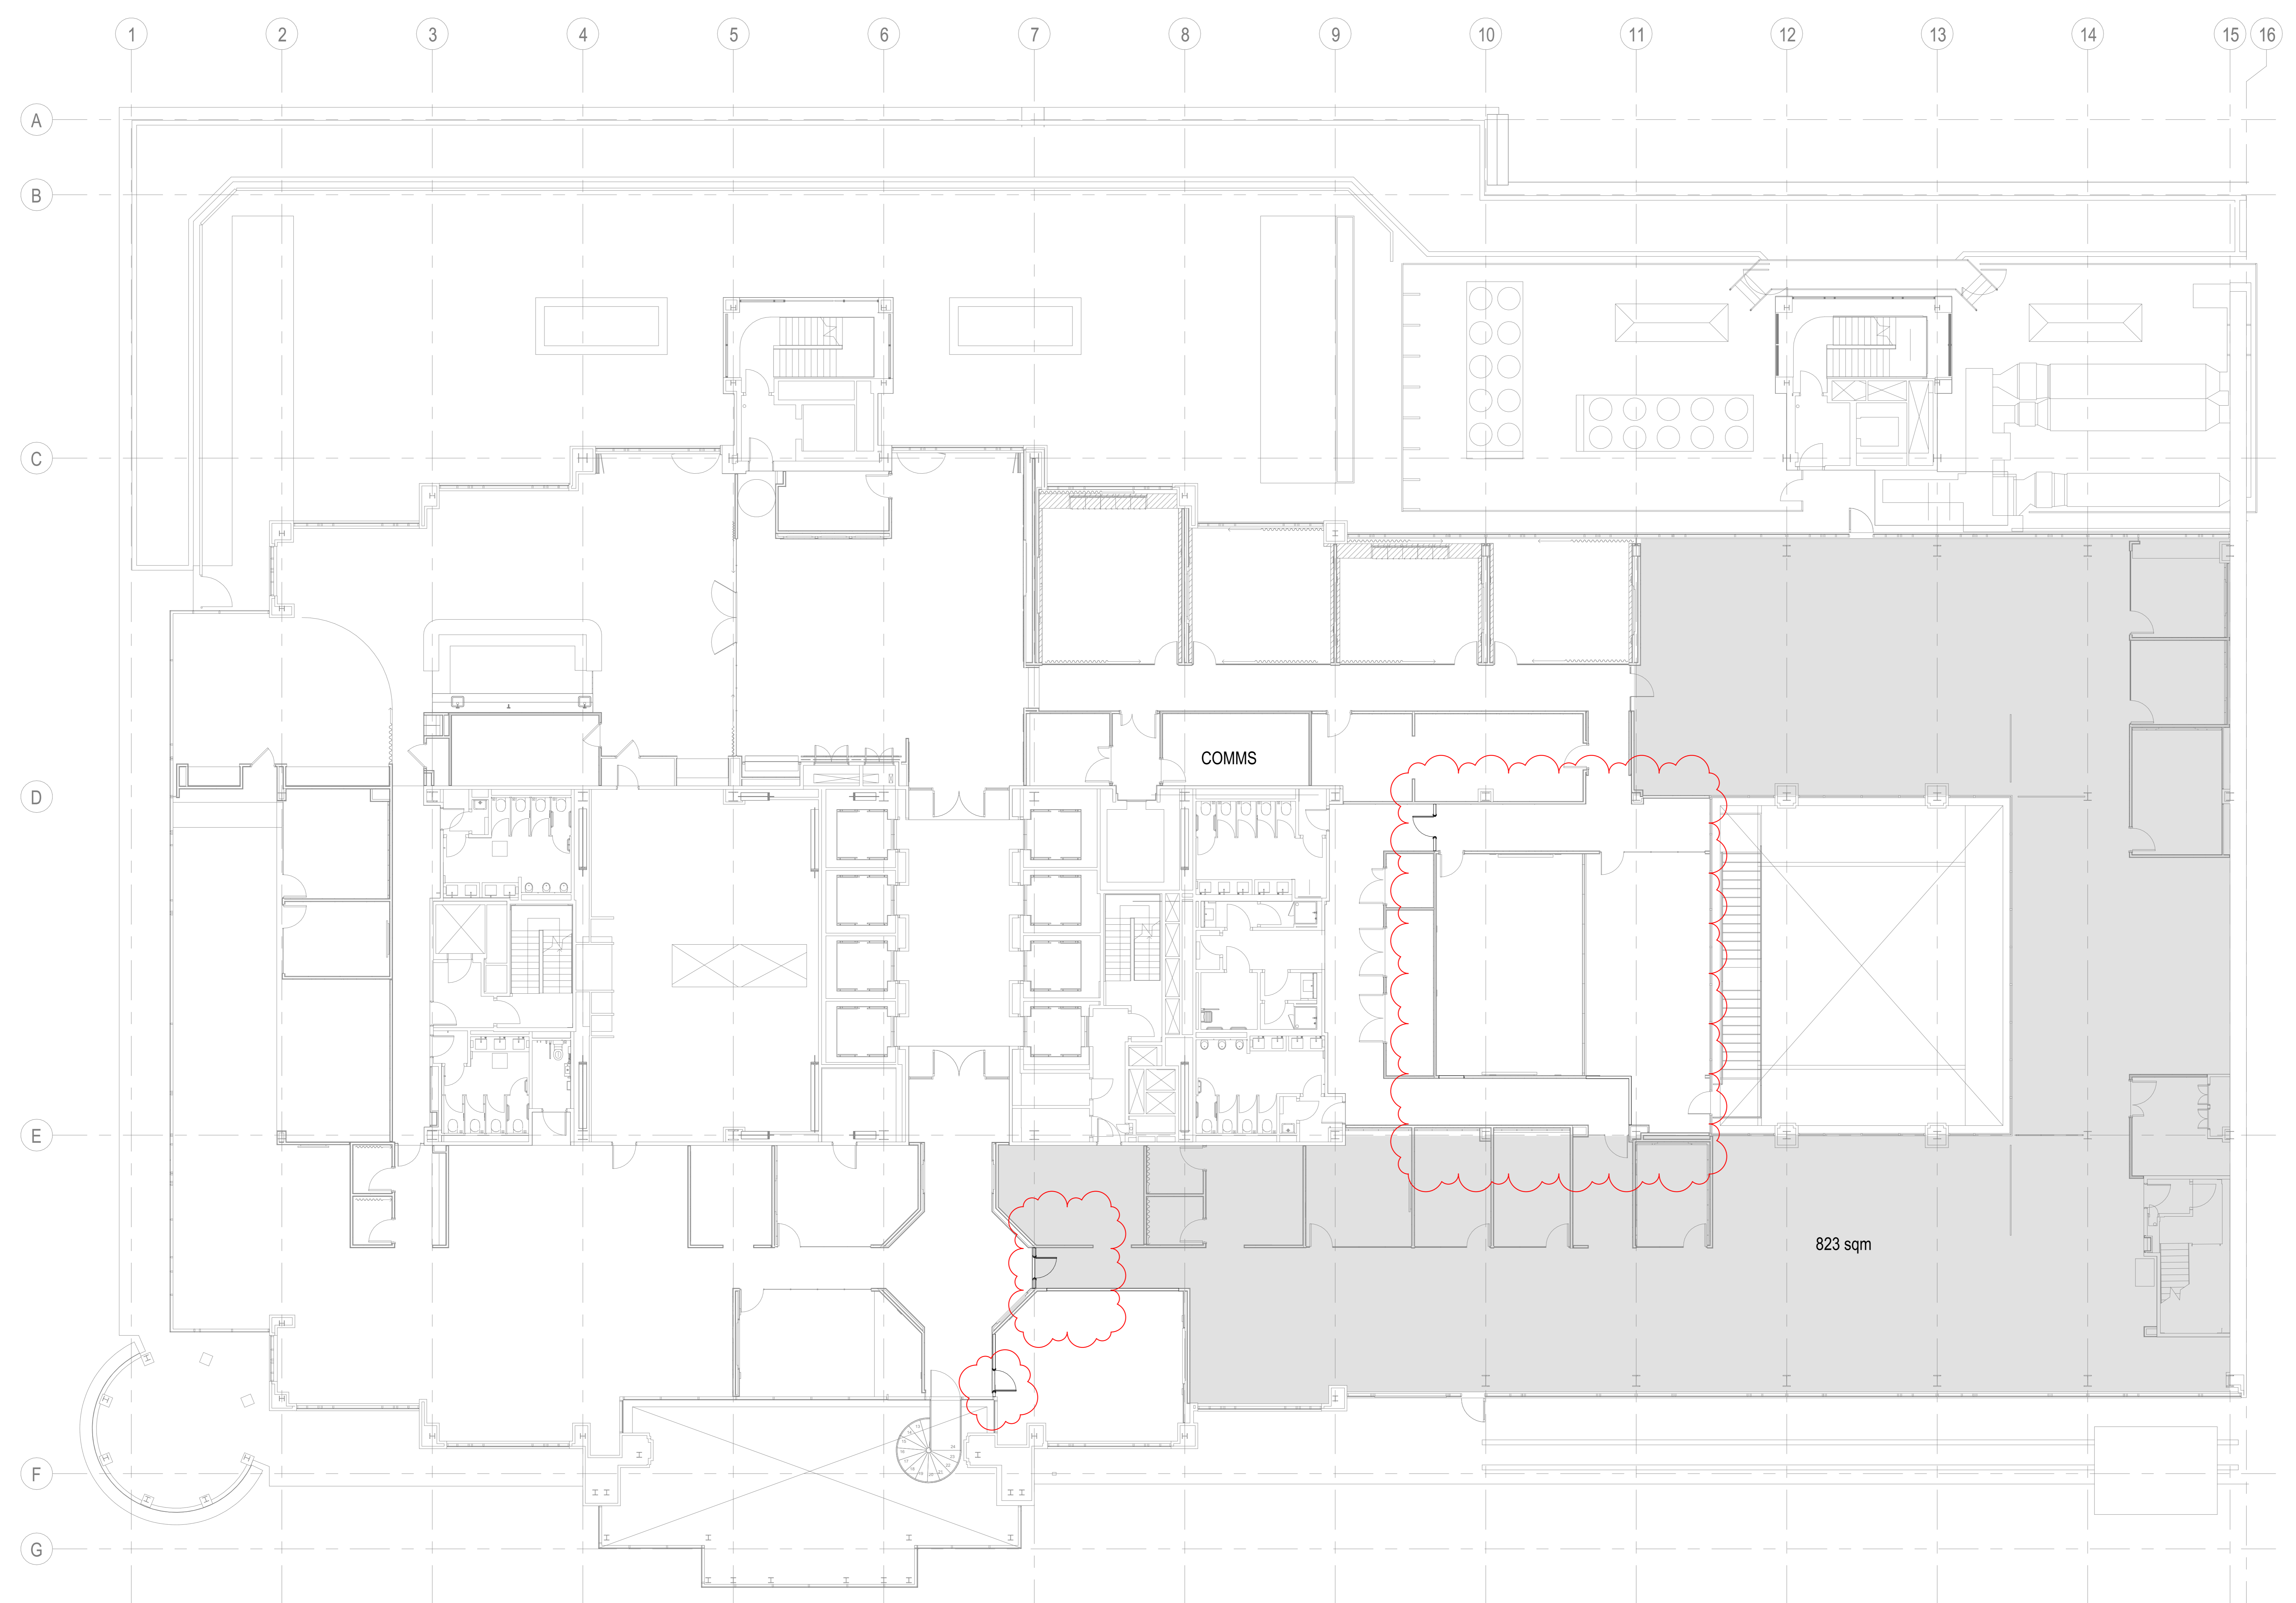

All dimensions must be verified on site prior to construction. Any discrepancies to report immediately to project manager.
 All drawings to be read in conjunction with mechanical, hydraulic, electrical, structural engineers and security consultants detail drawings and specifications.
 For finishes details refer to detailed drawings and finishes schedule for further details.
 All work to be carried out in accordance with the UK Building Regulations, BS British Standards, Local Water, Electricity regulations and all other relevant Authorities requirement concerned.
 All work to be carried out in a professional & workmanship like manner according to the plans & specification.
 Do not scale off the drawings unless otherwise stated and use figured dimensions in preference.
 All dimensions are to be checked & verified on site before the commencement of any work, all dimensions & levels are subject to final survey and set out.
 This drawing & design is the property of the design group nominated on this sheet and should not be reproduced either in part or whole without the written consent of this firm.
 Any structural works are subject structural engineer surveys and calculations.

01	Updated Plans	06/03/25	JS	JH
00	FOR DISCUSSION	06/01/25	JS	JH
Rev	Description	Date	By	Clk

FOR INFORMATION

Project Name:
McCANN LONDON

Client:
McCANN

Project Address:
135 Bishopsgate

Drawing Title:
General Arrangement Plan - Level 08

Drawn: Author	Scale: @A0 1 : 100
Checked: Checker	Date Created: 14/07/23

Woodalls Victoria House
1-3 College Hill
London EC4R 2RA
+44 (0)20 7489 7669

Project No: 11479	Drawing Number: A203	Floor: 01	Stage: CT	Rev: 01
----------------------	-------------------------	--------------	--------------	------------

