




3RD FLOOR PLAN
(NIA AREA)





NOTES:

ALL INFORMATION CONTAINED IN THIS DRAWING (INCLUDING DIGITAL DATA) SHOULD BE CHECKED AND VERIFIED PRIOR TO ANY FABRICATION OR CONSTRUCTION.THIS SURVEY WAS CONDUCTED USING LASER SCANNING.

ALL SCAN DATA IS HELD BY DG&S AFTER THE COMPLETION OF OUR WORK AND IF ADDITIONAL SURVEY DATA IS REQUIRED, PLEASE CONTACT DG&S FOR FURTHER DETAILS.

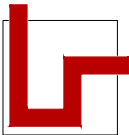 OFFICE
NIA AREA =

 AHU AREA
(EXCLUSIONS) =

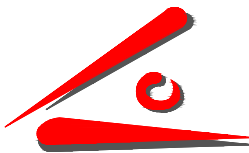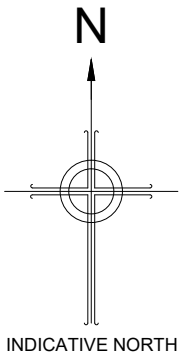

Daydon Griffiths & Surry
LU.105, 1 Filament Walk
London
SW18 4GQ

Tel: +44 (0)207- 498 9940
E-mail: post@dgsurry.com
Website: www.dgsurry.com

Drawing.	NIA AREA		
Client Name.	COGENT BC		
Project.	2-3 Golden Square London W1F 9HR		
Title.	3RD FLOOR (NIA AREA)		

DWG REF: Golden Square (2-3) - Existing Survey (2024 UPDATE) (Rev B)			
DWG NO:	019	REVISION NO:	B
SCALE:	1:100 @ A1	DATE CREATED:	MAR 2024
DRAWN BY:	D G & S	CHECKED BY:	D G & S