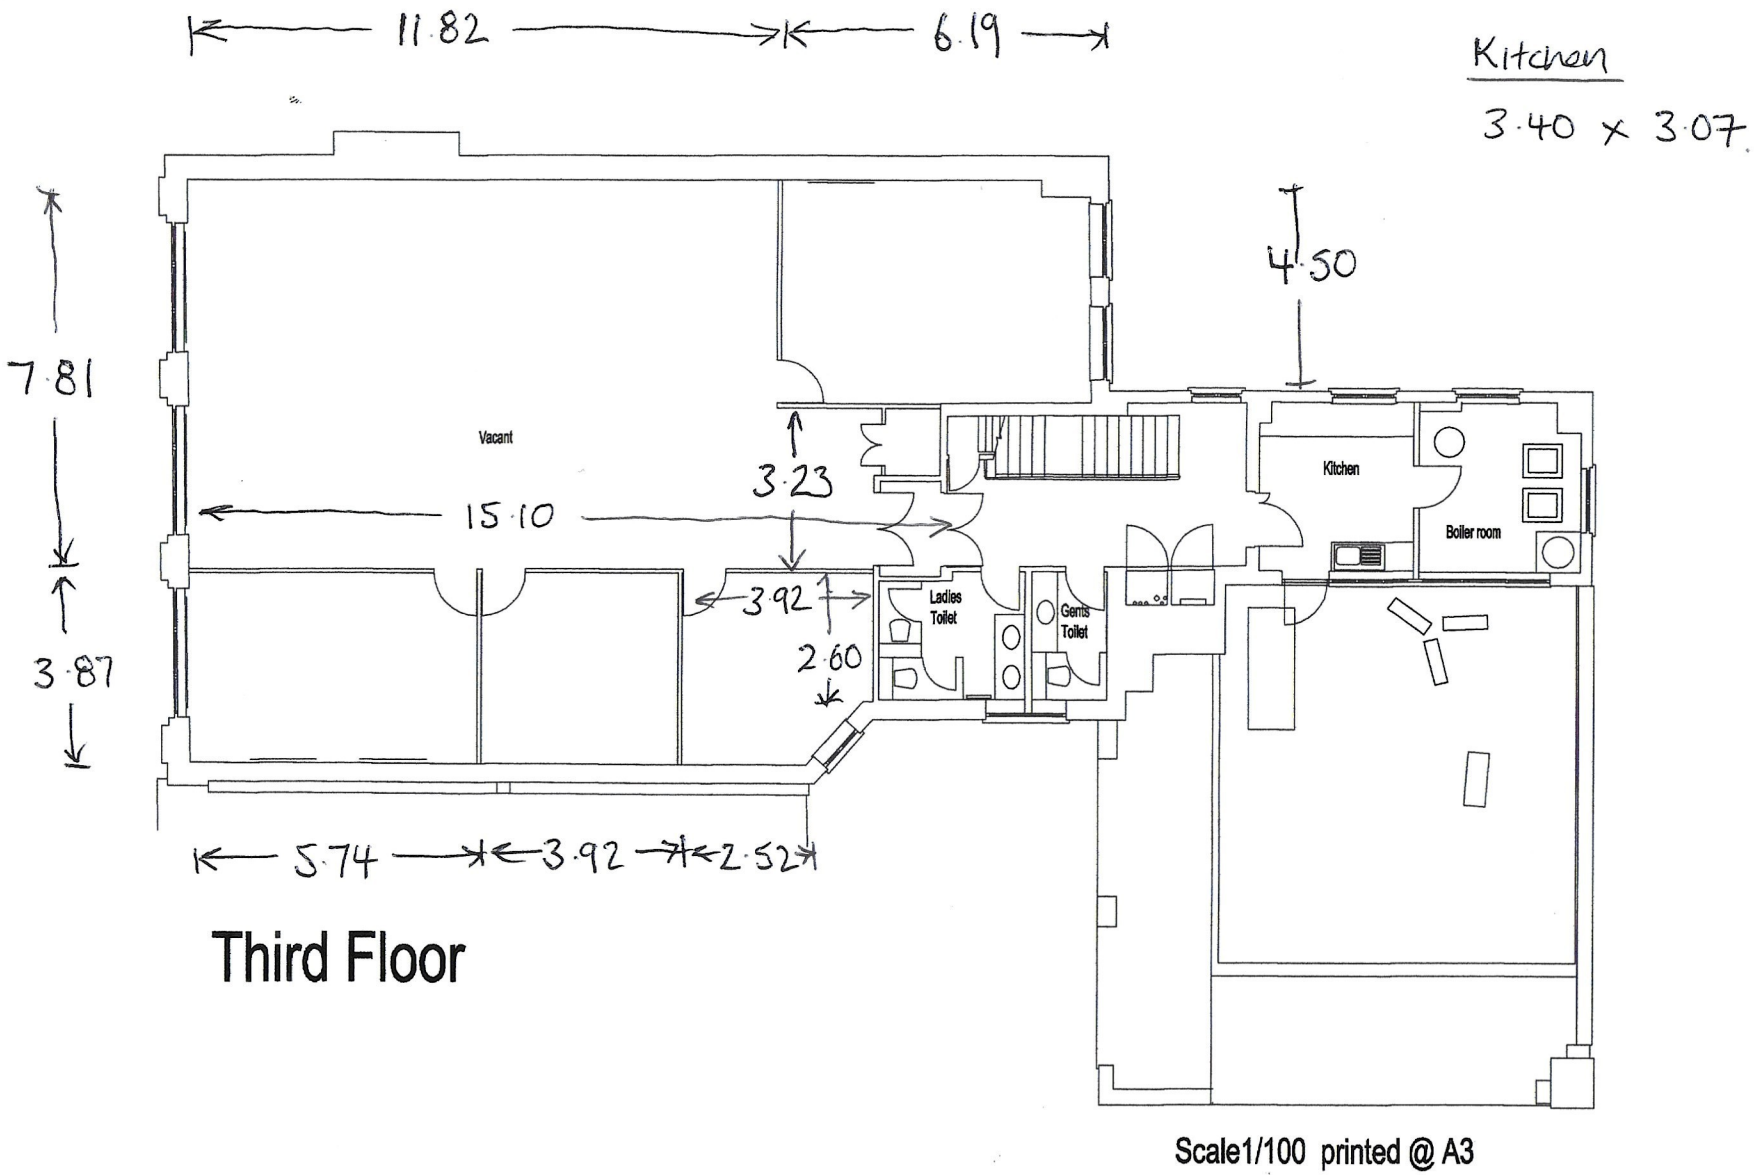


Third Floor

Scale1/100 printed @ A3