

LEVEL 00

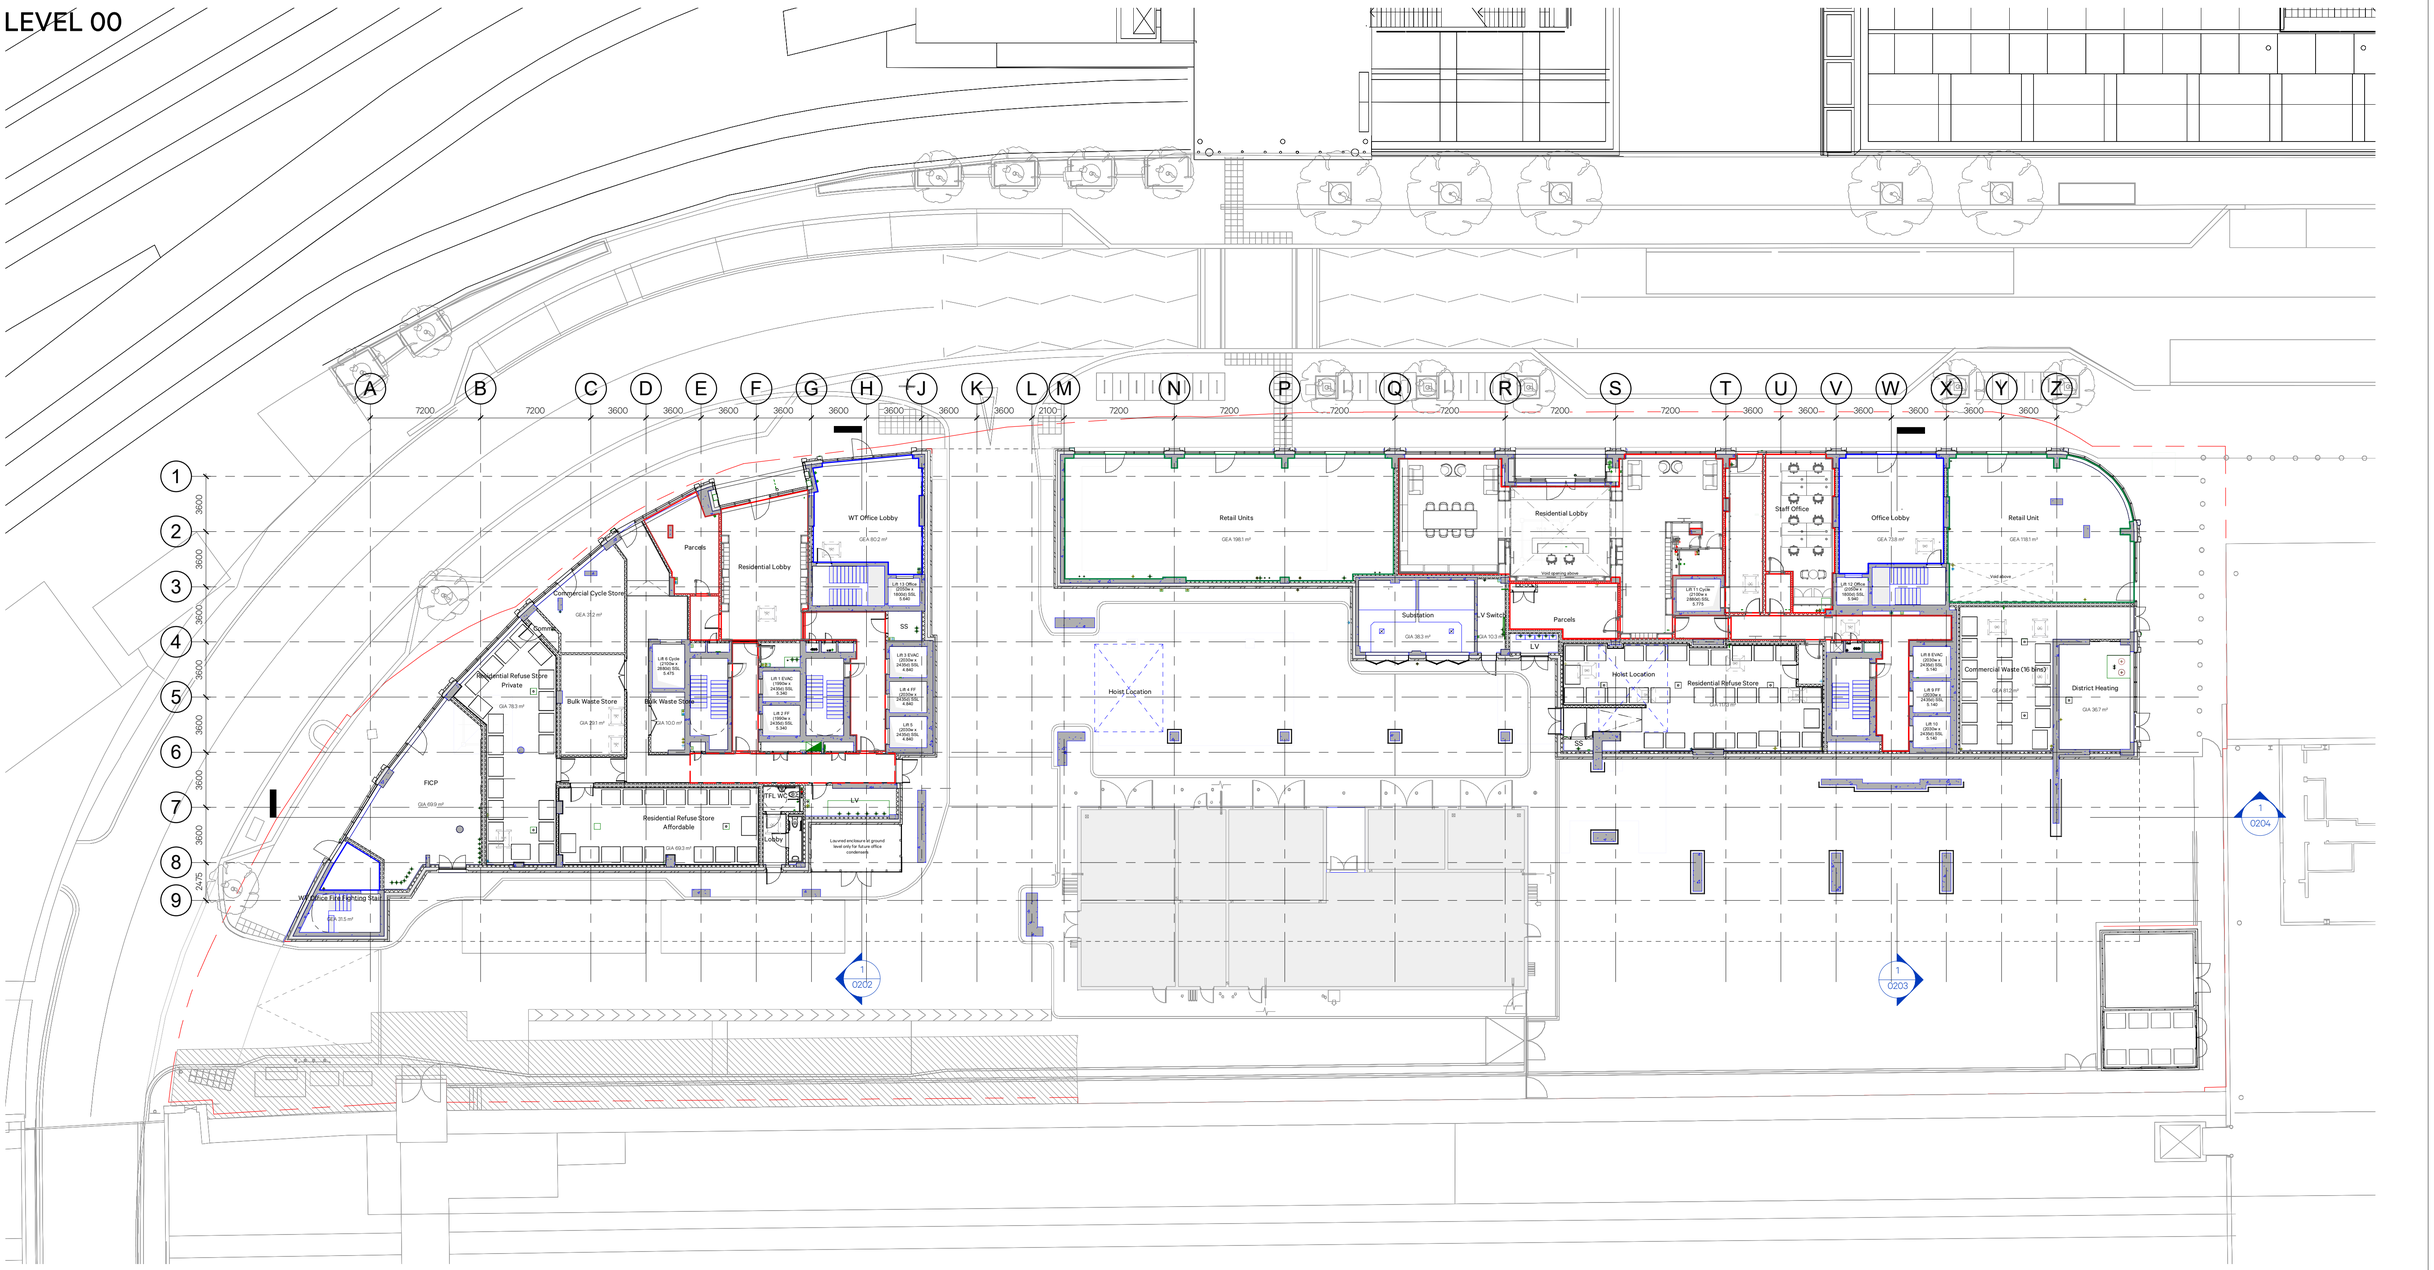

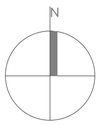

1:200

0 2 4 8 12 16 20m

Rev	Description	Date
C9	REVISED TO CURRENT ARCHITECTURAL LAYOUTS	05.09.23
C10	KEY UPDATED	16.11.23
C11	GRAPHIC AMENDED	21.11.23
C12	L+L LAYOUTS ADDED TO DRAWINGS	20.12.23
C13	UPDATED TO CURRENT ARCHITECTURAL LAYOUTS	19.01.24
C14	UPDATED TO CURRENT ARCHITECTURAL LAYOUTS	13.02.24
C15	UPDATED TO CURRENT ARCHITECTURAL LAYOUT	20.03.24

Notes

FIT OUT WORKS

Office fit out works

Retail fit out works

Fit out by others
- Part of Amenity scope of works

Coordination with services installed above ceiling level as part of amentiy scope of works required

WHEELCHAIR FLAT

Part M4(3)(2)(a) - Wheelchair adaptable

Part M4(3)(2)(b) - Wheelchair accessible

CDM

For CDM information relating to the plans, please refer to the 1100 series: Setting Out Plans.

LINKED MODEL NOTES

WALSH LATEST STRUCTURAL REVIT MODEL SHOWN IN BLUE -
5256-WAL-SW-ZZ-M3-S-XX-0001_W09 ISSUED 15.11.23

SWECO LATEST MEPH REVIT MODEL SHOWN IN GREEN -
201778-MLM-ZZ-ZZ-M3-A-0001 ISSUED 06.02.24


L+L INTERIOR DESIGNER STAGE 4 PACK LINKED DWGS SHOWN IN GREY FOR AMENITY AREAS, ISSUED 17.11.23


NO DIMENSIONS ARE TO BE SCALED FROM THIS DRAWING. THE CONTRACTOR/MANUFACTURER IS REPSONSIBLE FOR CHECKING ALL DIMENSIONS AND QUERYING ANY DISCREPANCIES. THIS DRAWING IS THE PROPERTY OF BURWELL ARCHITECTS LTD. COPYRIGHT IS RESERVED BY THEM AND THE DRAWING IS ISSUED ON CONDITION THAT IT IS NOT COPIED, REPRODUCED, RETAINED OR DISCLOSED TO ANY UNAUTHORISED PERSON, EITHER WHOLLY OR IN PART, WITHOUT WRITTEN CONSENT

Client	TELFORD HOMES
Project	INTERNATIONAL WAY
Drawing	LEVEL 00 OVERALL
Scale (@A1)	1: 200
Date	10/03/21
Drawn	MP
Proj. Lead	SP
Project & Drawing No.	0894-BUR-ZZ-00-DR-A-0101
Revision	C15

Burwell Architects
info@burwellarchitects.com
www.burwellarchitects.com
Unit 0.01
California Building
London SE13 7SB
020 8305 6010

LEVEL 01

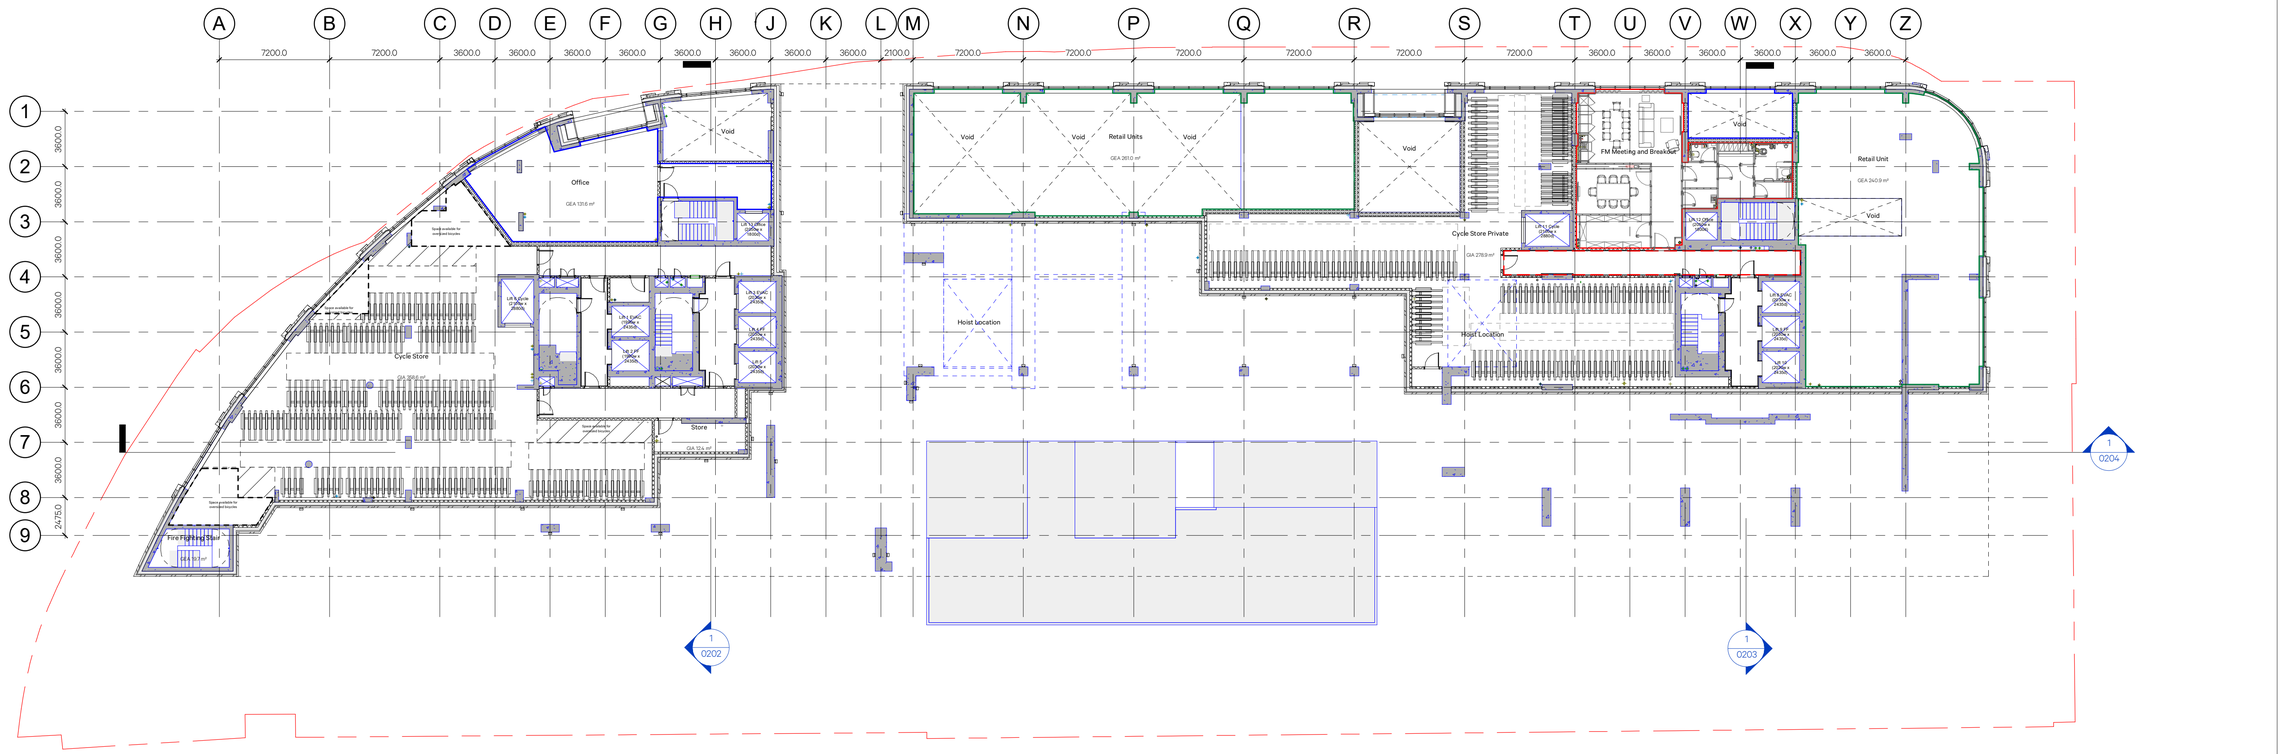

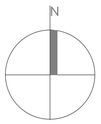

1:200

0 2 4 8 12 16 20m

Rev	Description	Date
C4	GENERAL COORDINATION UPDATES ISSUE	05.06.23
C5	REVISED TO CURRENT ARCHITECTURAL LAYOUTS	05.09.23
C6	KEY UPDATED	16.11.23
C7	L+L LAYOUTS ADDED TO DRAWINGS	20.12.23
C8	UPDATED TO CURRENT ARCHITECTURAL LAYOUTS	19.01.24
C9	UPDATED TO CURRENT ARCHITECTURAL LAYOUTS	13.02.24

Notes

FIT OUT WORKS

Office fit out works

Retail fit out works

Fit out by others
- Part of Amenity scope of works
Coordination with services installed above ceiling level as part of amentiy scope of works required

WHEELCHAIR FLAT

As per Building Regulations: Approved Document Part M4(3)(2)(a) - Wheelchair adaptable

CDM

For CDM information relating to the plans, please refer to the 1100 series: Setting Out Plans.

LINKED MODEL NOTES

WALSH LATEST STRUCTURAL REVIT MODEL SHOWN IN BLUE -
5256-WAL-SW-ZZ-M3-S-XX-0001_W09 ISSUED 15.11.23

SWECO LATEST MEPH REVIT MODEL SHOWN IN GREEN -
201778-MLM-ZZ-ZZ-M3-A-0001 ISSUED 06.02.24

L+L INTERIOR DESIGNER STAGE 4 PACK LINKED DWGS SHOWN IN GREY FOR AMENITY AREAS, ISSUED 17.11.23

NO DIMENSIONS ARE TO BE SCALED FROM THIS DRAWING. THE CONTRACTOR/MANUFACTURER IS REPSONSIBLE FOR CHECKING ALL DIMENSIONS AND QUERYING ANY DISCREPANCIES. THIS DRAWING IS THE PROPERTY OF BURWELL ARCHITECTS LTD. COPYRIGHT IS RESERVED BY THEM AND THE DRAWING IS ISSUED ON CONDITION THAT IT IS NOT COPIED, REPRODUCED, RETAINED OR DISCLOSED TO ANY UNAUTHORISED PERSON, EITHER WHOLLY OR IN PART, WITHOUT WRITTEN CONSENT


Client	TELFORD HOMES
Project	INTERNATIONAL WAY
Drawing	LEVEL 01 OVERALL
Scale (@A1)	1: 200
Date	10/03/21
Drawn	MP
Proj. Lead	SP
Project & Drawing No.	0894-BUR-ZZ-01-DR-A-0101
Revision	C9


Burwell Architects

info@burwellarchitects.com
www.burwellarchitects.com

Unit 0.01
California Building
London SE13 7SB
020 8305 6010

LEVEL 02

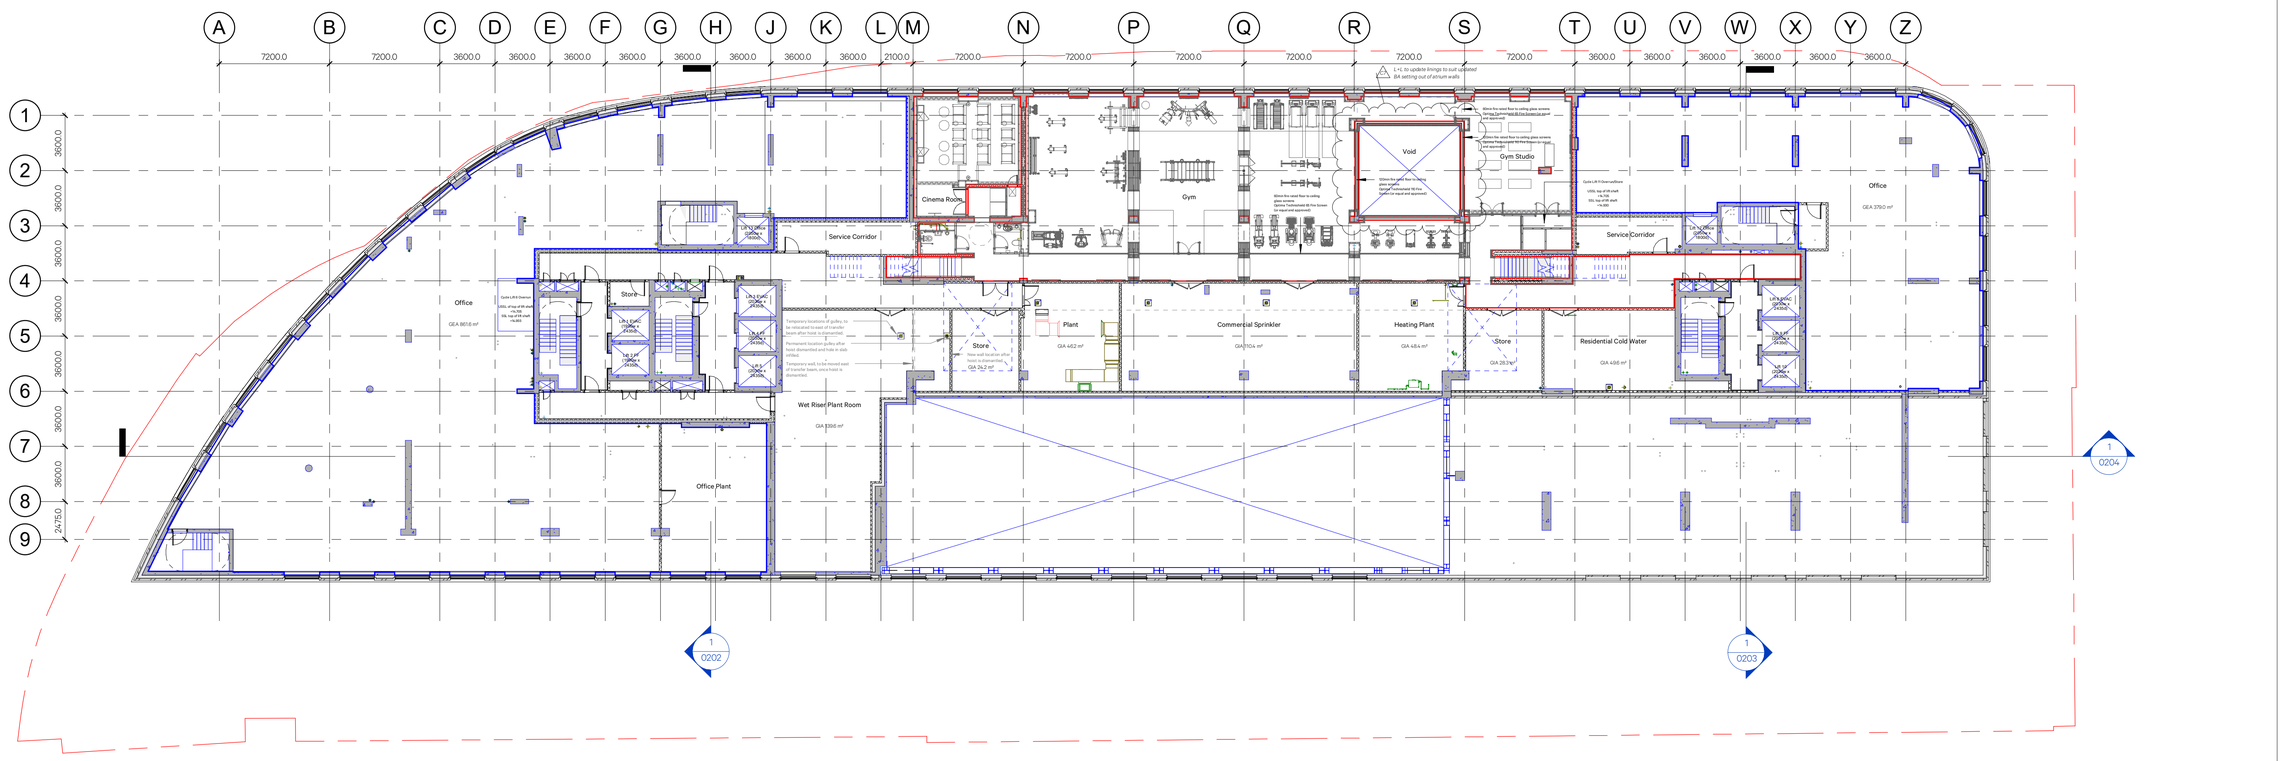

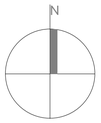

1:200

0 2 4 8 12 16 20m

Rev	Description	Date
C6	KEY UPDATED	16.11.23
C7	L+L LAYOUTS ADDED TO DRAWINGS	20.12.23
C8	PARTY WALLS TO L02 OFFICES UPDATED, SERVICE CORRIDOR ADDED.	11.01.24
C9	UPDATED TO CURRENT ARCHITECTURAL LAYOUTS	19.01.24
C10	UPDATED TO CURRENT ARCHITECTURAL LAYOUTS	13.02.24
C11	UPDATED TO CURRENT ARCHITECTURAL LAYOUT	20.03.24

Notes

FIT OUT WORKS

Office fit out works

Retail fit out works

Fit out by others
- Part of Amenity scope of works

Coordination with services installed above ceiling level as part of amentiy scope of works required

WHEELCHAIR FLAT

Part M4(3)(2)(a) - Wheelchair adaptable

Part M4(3)(2)(b) - Wheelchair accessible

CDM

For CDM information relating to the plans, please refer to the 1100 series: Setting Out Plans.

LINKED MODEL NOTES

WALSH LATEST STRUCTURAL REVIT MODEL SHOWN IN BLUE -
5256-WAL-SW-ZZ-M3-S-XX-0001_W09 ISSUED 15.11.23

SWECO LATEST MEPH REVIT MODEL SHOWN IN GREEN -
201778-MLM-ZZ-ZZ-M3-A-0001 ISSUED 06.02.24


L+L INTERIOR DESIGNER STAGE 4 PACK LINKED DWGS SHOWN IN GREY FOR AMENITY AREAS, ISSUED 17.11.23

NO DIMENSIONS ARE TO BE SCALED FROM THIS DRAWING. THE CONTRACTOR/MANUFACTURER IS REPSONSIBLE FOR CHECKING ALL DIMENSIONS AND QUERYING ANY DISCREPANCIES. THIS DRAWING IS THE PROPERTY OF BURWELL ARCHITECTS LTD. COPYRIGHT IS RESERVED BY THEM AND THE DRAWING IS ISSUED ON CONDITION THAT IT IS NOT COPIED, REPRODUCED, RETAINED OR DISCLOSED TO ANY UNAUTHORISED PERSON, EITHER WHOLLY OR IN PART, WITHOUT WRITTEN CONSENT

Client	TELFORD HOMES
Project	INTERNATIONAL WAY
Drawing	LEVEL 02 OVERALL
Scale (@A1)	1 : 200
Date	10/03/21
Drawn	MP
Proj. Lead	SP
Project & Drawing No.	0894-BUR-ZZ-02-DR-A-0101
Revision	C11

Burwell Architects
info@burwellarchitects.com
www.burwellarchitects.com
Unit 0.01
California Building
London SE13 7SB
020 8305 6010

LEVEL 03

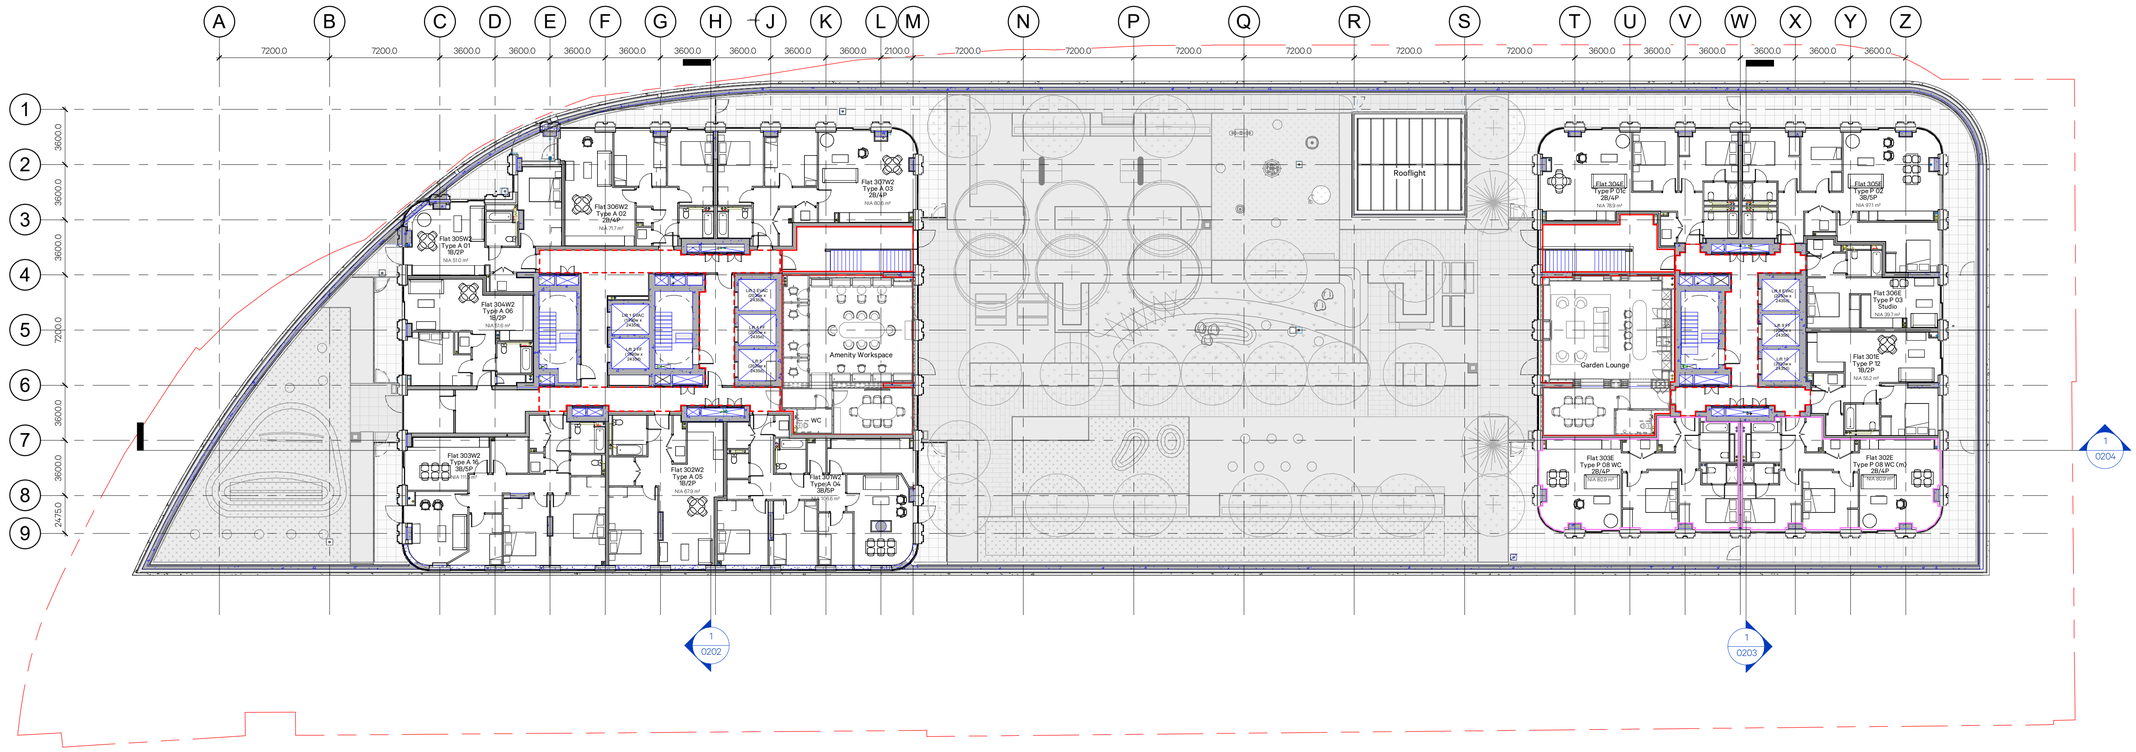

N

1:200

0 2 4 8 12 16 20m

Rev	Description	Date
C1	DOORS UPDATED TO IMPERIAL SIZES, BLOCKWORK SETTING OUT UPDATED TO SUIT.	12.04.23
C2	GENERAL COORDINATION UPDATES ISSUE	05.06.23
C3	REVISED TO UPDATED ARCHITECTURAL LAYOUTS	13.09.23
C4	KEY UPDATED	16.11.23
C5	L+L LAYOUTS ADDED TO DRAWINGS	20.12.23
C6	UPDATED TO CURRENT ARCHITECTURAL LAYOUTS	13.02.24

Notes

FIT OUT WORKS

Office fit out works

Retail fit out works

Fit out by others
– Part of Amenity scope of works
Coordination with services installed above ceiling level as part of amentiy scope of works required

WHEELCHAIR FLAT

As per Building Regulations: Approved Document Part M4(3)(2)(a) - Wheelchair adaptable

CDM

For CDM information relating to the plans, please refer to the 1100 series: Setting Out Plans.

LINKED MODEL NOTES

WALSH LATEST STRUCTURAL REVIT MODEL SHOWN IN BLUE -
5256-WAL-SW-ZZ-M3-S-XX-0001_W09 ISSUED 15.11.23


SWECO LATEST MEPH REVIT MODEL SHOWN IN GREEN -
201778-MLM-ZZ-ZZ-M3-A-0001 ISSUED 06.02.24

L+L INTERIOR DESIGNER STAGE 4 PACK LINKED DWGS SHOWN IN GREY FOR AMENITY AREAS, ISSUED 17.11.23

NO DIMENSIONS ARE TO BE SCALED FROM THIS DRAWING. THE CONTRACTOR/MANUFACTURER IS RESPONSIBLE FOR CHECKING ALL DIMENSIONS AND QUERYING ANY DISCREPANCIES. THIS DRAWING IS THE PROPERTY OF BURWELL ARCHITECTS LTD. COPYRIGHT IS RESERVED BY THEM AND THE DRAWING IS ISSUED ON CONDITION THAT IT IS NOT COPIED, REPRODUCED, RETAINED OR DISCLOSED TO ANY UNAUTHORISED PERSON, EITHER WHOLLY OR IN PART, WITHOUT WRITTEN CONSENT

Client	TELFORD HOMES
Project	INTERNATIONAL WAY
Drawing	LEVEL 03 OVERALL
Scale (@A1)	1 : 200
Date	01/07/21
Drawn	MP
Proj. Lead	SP
Project & Drawing No.	0894-BUR-ZZ-03-DR-A-0101
Revision	C6

Burwell Architects
info@burwellarchitects.com
www.burwellarchitects.com
Unit 0.01
California Building
London SE13 7SB
020 8305 6010

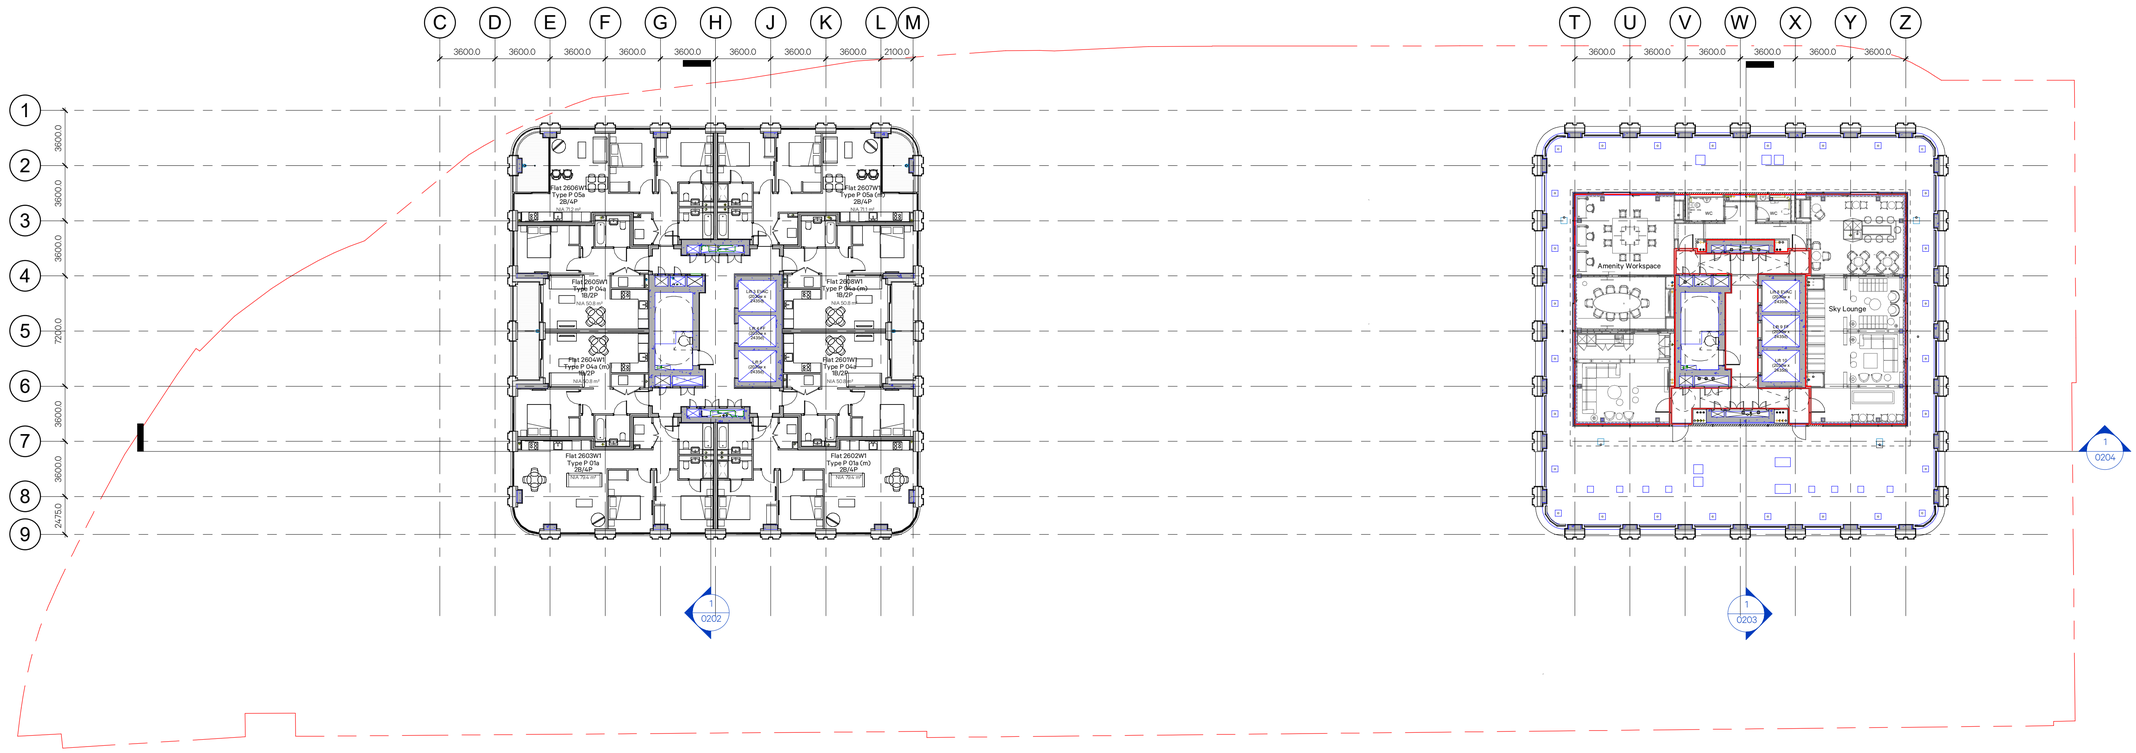

N

L26

1:200

0 2 4 8 12 16 20m

Rev	Description	Date
P10	GA WIP ISSUE FOR COORDINATION	18.08.22
P11	POD BATHROOMS UPDATED TO IN-SITU, SETTING OUT UPDATED	11.10.22
T1	GENERAL COORDINATION UPDATES ISSUE	28.06.23
C1	KEY UPDATED	16.11.23
C2	L+L LAYOUTS ADDED TO DRAWINGS	20.12.23

Notes

FIT OUT WORKS

Office fit out works

Retail fit out works

Fit out by others
- Part of Amenity scope of works

Coordination with services installed above ceiling level as part of amentiy scope of works required

WHEELCHAIR FLAT

As per Building Regulations: Approved Document Part M4(3)(2)(a) - Wheelchair adaptable

CDM

For CDM information relating to the plans, please refer to the 1100 series: Setting Out Plans.

NO DIMENSIONS ARE TO BE SCALED FROM THIS DRAWING. THE CONTRACTOR/MANUFACTURER IS REPSONSIBLE FOR CHECKING ALL DIMENSIONS AND QUERYING ANY DISCREPANCIES. THIS DRAWING IS THE PROPERTY OF BURWELL ARCHITECTS LTD. COPYRIGHT IS RESERVED BY THEM AND THE DRAWING IS ISSUED ON CONDITION THAT IT IS NOT COPIED, REPRODUCED, RETAINED OR DISCLOSED TO ANY UNAUTHORISED PERSON, EITHER WHOLLY OR IN PART, WITHOUT WRITTEN CONSENT

Client	TELFORD HOMES
Project	INTERNATIONAL WAY
Drawing	LEVEL 26 OVERALL
Scale (@A1)	1:200
Date	01/07/21
Drawn	BA
Proj. Lead	SP
Project & Drawing No.	0894-BUR-ZZ-26-DR-A-0101
Revision	C2

Burwell Architects

info@burwellarchitects.com
www.burwellarchitects.com

Unit 0.01
California Building
London SE13 7SB

020 8305 6010