


Windsor Bridge Court Windsor & Eton Bridge SL4 6BT

Floor Plan : For General Guidance Only

The commercial property element is shown as "A3 Unit"

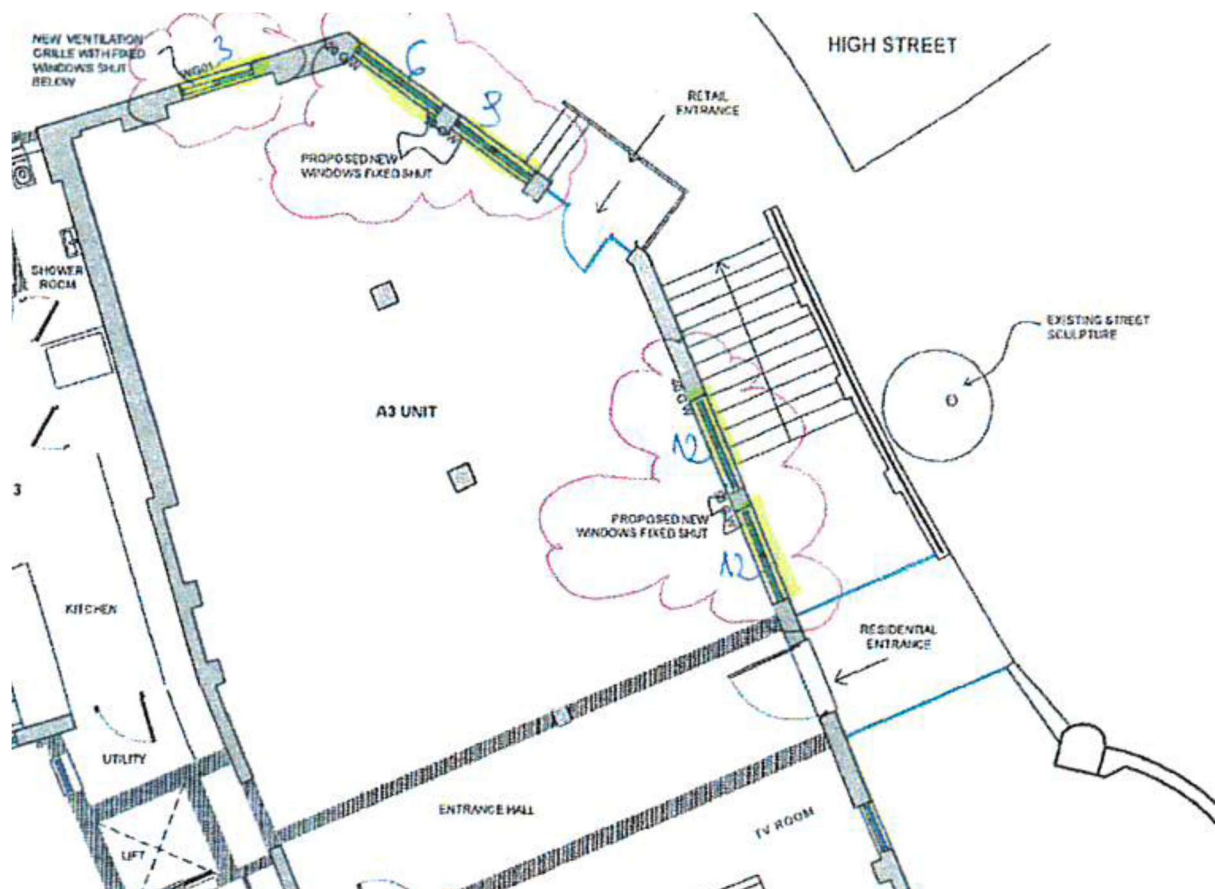

Not to Scale – For General Guidance – Steps Are External.