



Birmingham

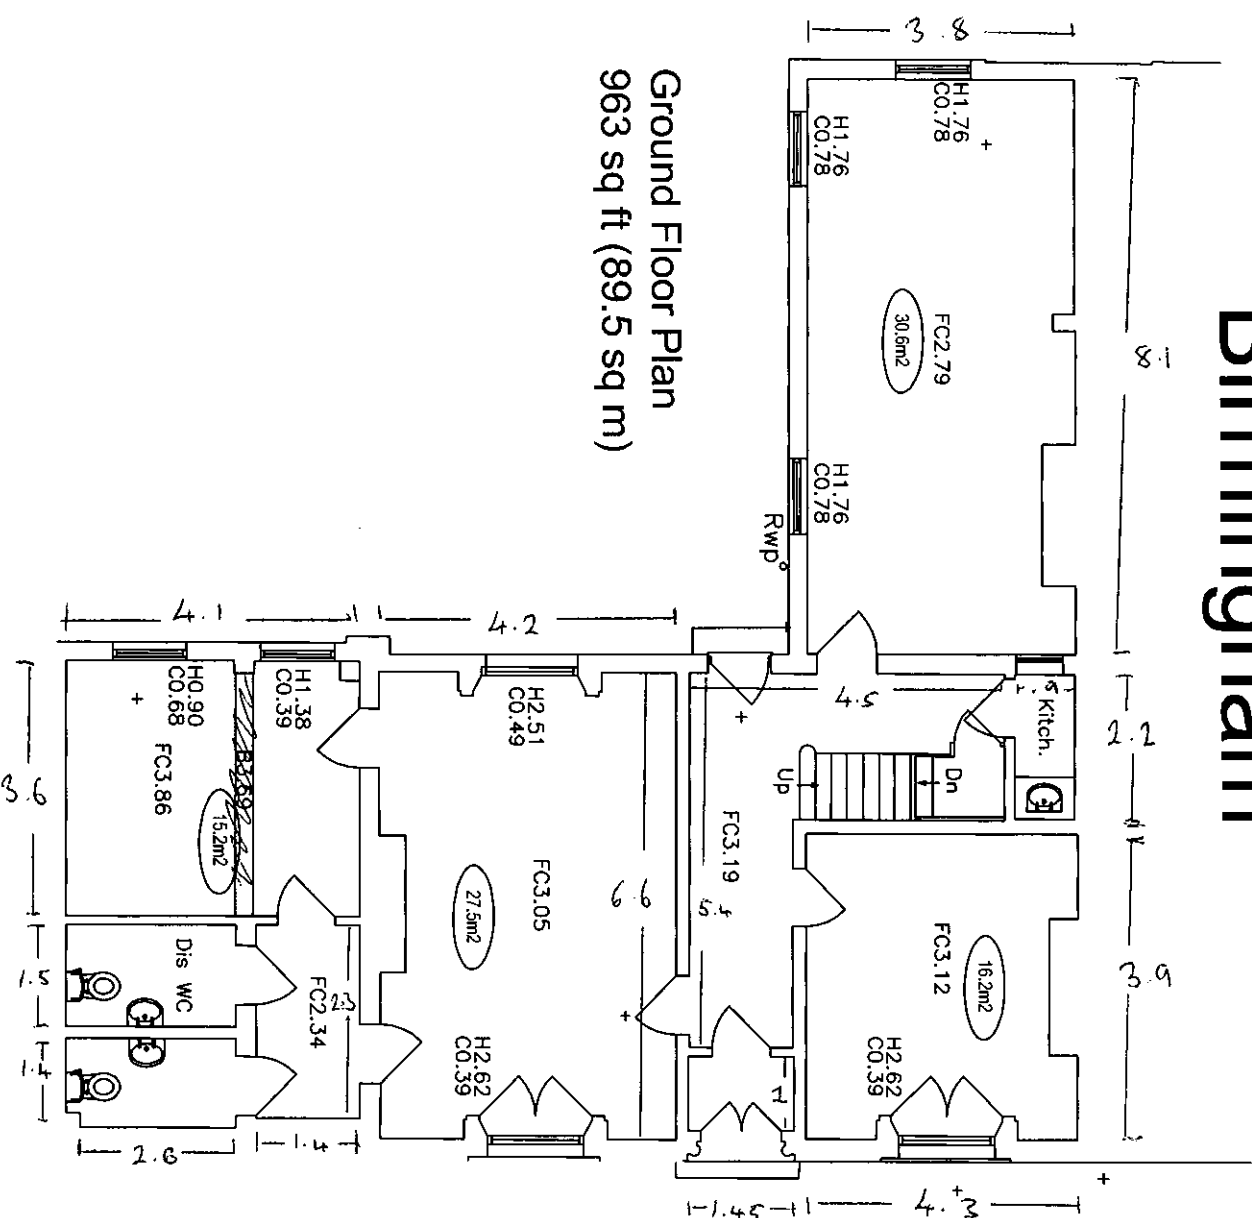

Ground Floor Plan
963 sq ft (89.5 sq m)

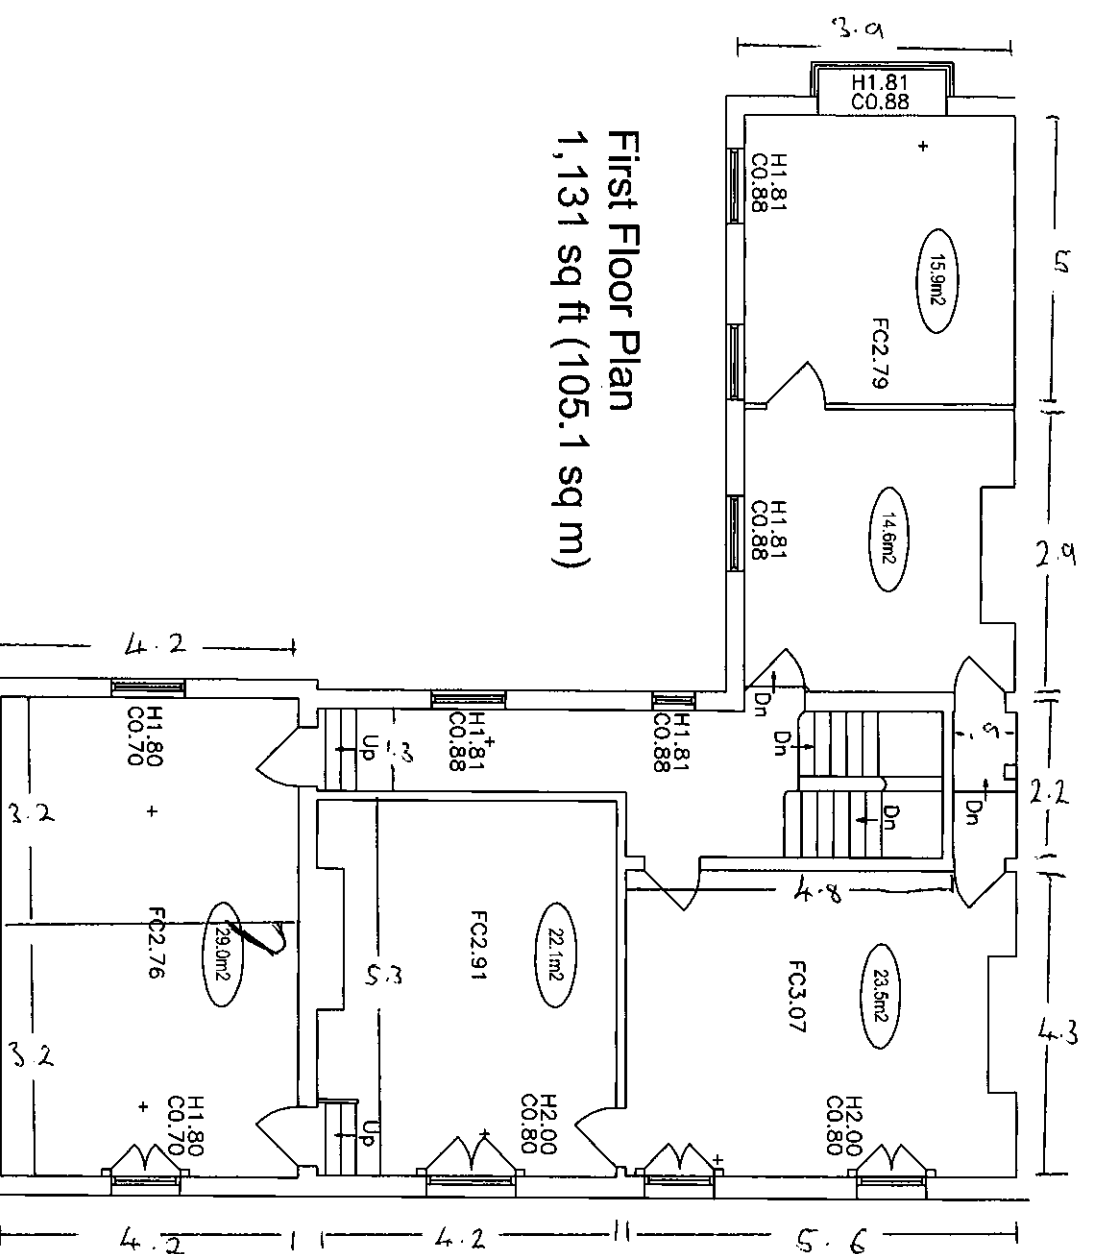

First Floor Plan
1,131 sq ft (105.1 sq m)

Total useable internal floor area = 2,094 sq ft (194.6 sq m)