

Notes :
1. This drawing should not be scaled, figured dimensions only to be taken
2. Should any discrepancies be found with this drawing, please inform this office
3. Copyright of this drawing is owned by jmarchitects

Structural information indicative only. To be confirmed by Structural Engineer.


North

Scale
1:100
2m 0m 2m 4m 6m 8m 10m

Plot
KLM

Block
K2

Location Plan

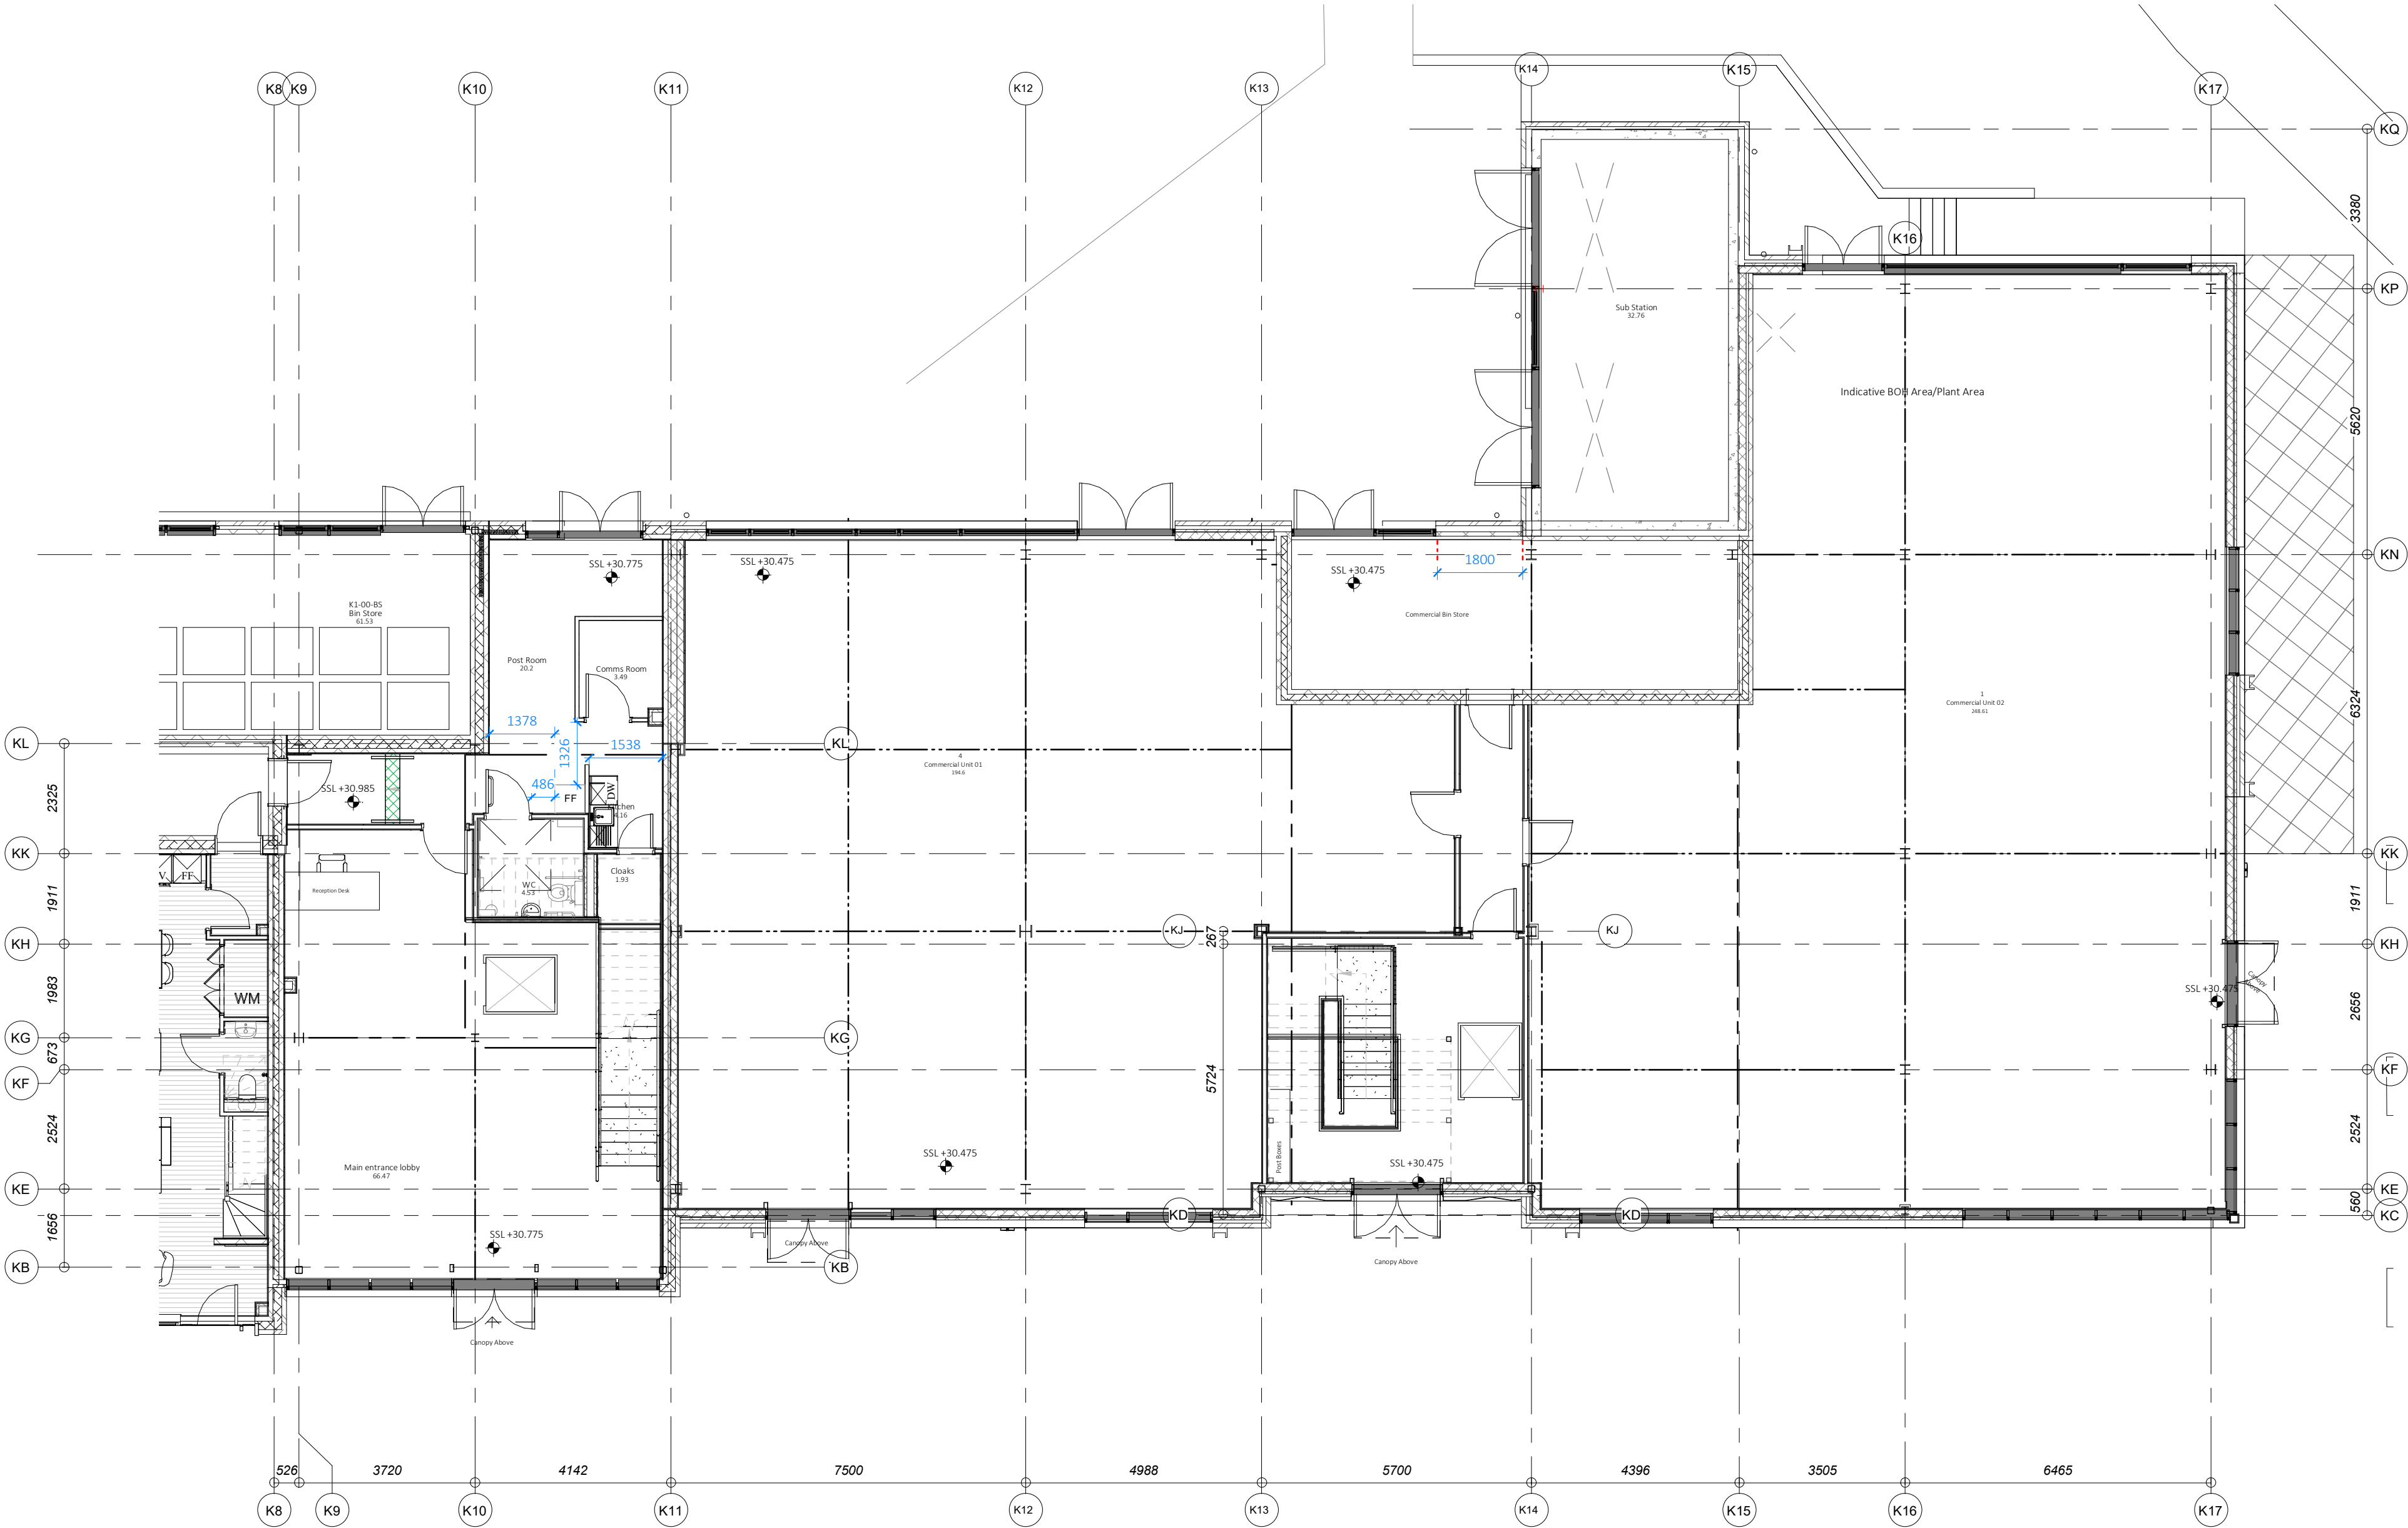

C8	Issued as final construction record	October 2024	VH	DS
C7	Door type updated to reflect manufacturer's specification. Swing flipped back	14.08.2024	DJC	VH
C6	Door swing flipped and schedule updated to reflect manufacturer's proposal	02.08.2024	DJC	VH
C5	Minor amendment to setting out	14.02.2024	VH	DS
C4	Revised door location to avoid clashing with SVP	18.12.2023	VH	DS
C3	Revised fire line position due to detailing reasons	30.11.2023	VH	DS
C2	Updated K1 atrium layout	14.11.2023	VH	DS
C1	Issued for construction purposes	28.03.2023	VH	DS
P05	Steel co-ordination to ground floor revised following Edge feedback	26.09.2022	DS	DC
P04	Drawing amended following A-Site comments	13.06.2022	TW	DS
P03	Lift arrangement amended to reflect contractor derogation VE 18	26.05.2022	DJC	DS
P02	Layout revised to reflect requirements of fire strategy	12.05.2022	DJC	DS
P01	First issue for review & comment	10.05.2022	TW	DJC
Rev	Description	Date	Drawn By	Check By

Project

Middlewood Locks phase 3

Title

Block K2 - Ground Floor Layout

Client

BCEGI

Purpose :

Scale @ A1:

1:100

3A 54 Princess Street
Manchester
M1 6HS

T : 0161 200 6300

man@jmarchitects.net
www.jmarchitects.net

Drawing Number

Project - Originator - Volume - Level - Type - Role - Class - Number

MWL3 -JMA- K2 -00 -DR- A- 03 -0001

Status

Revision

JMA Project Number

AM C8 6952