


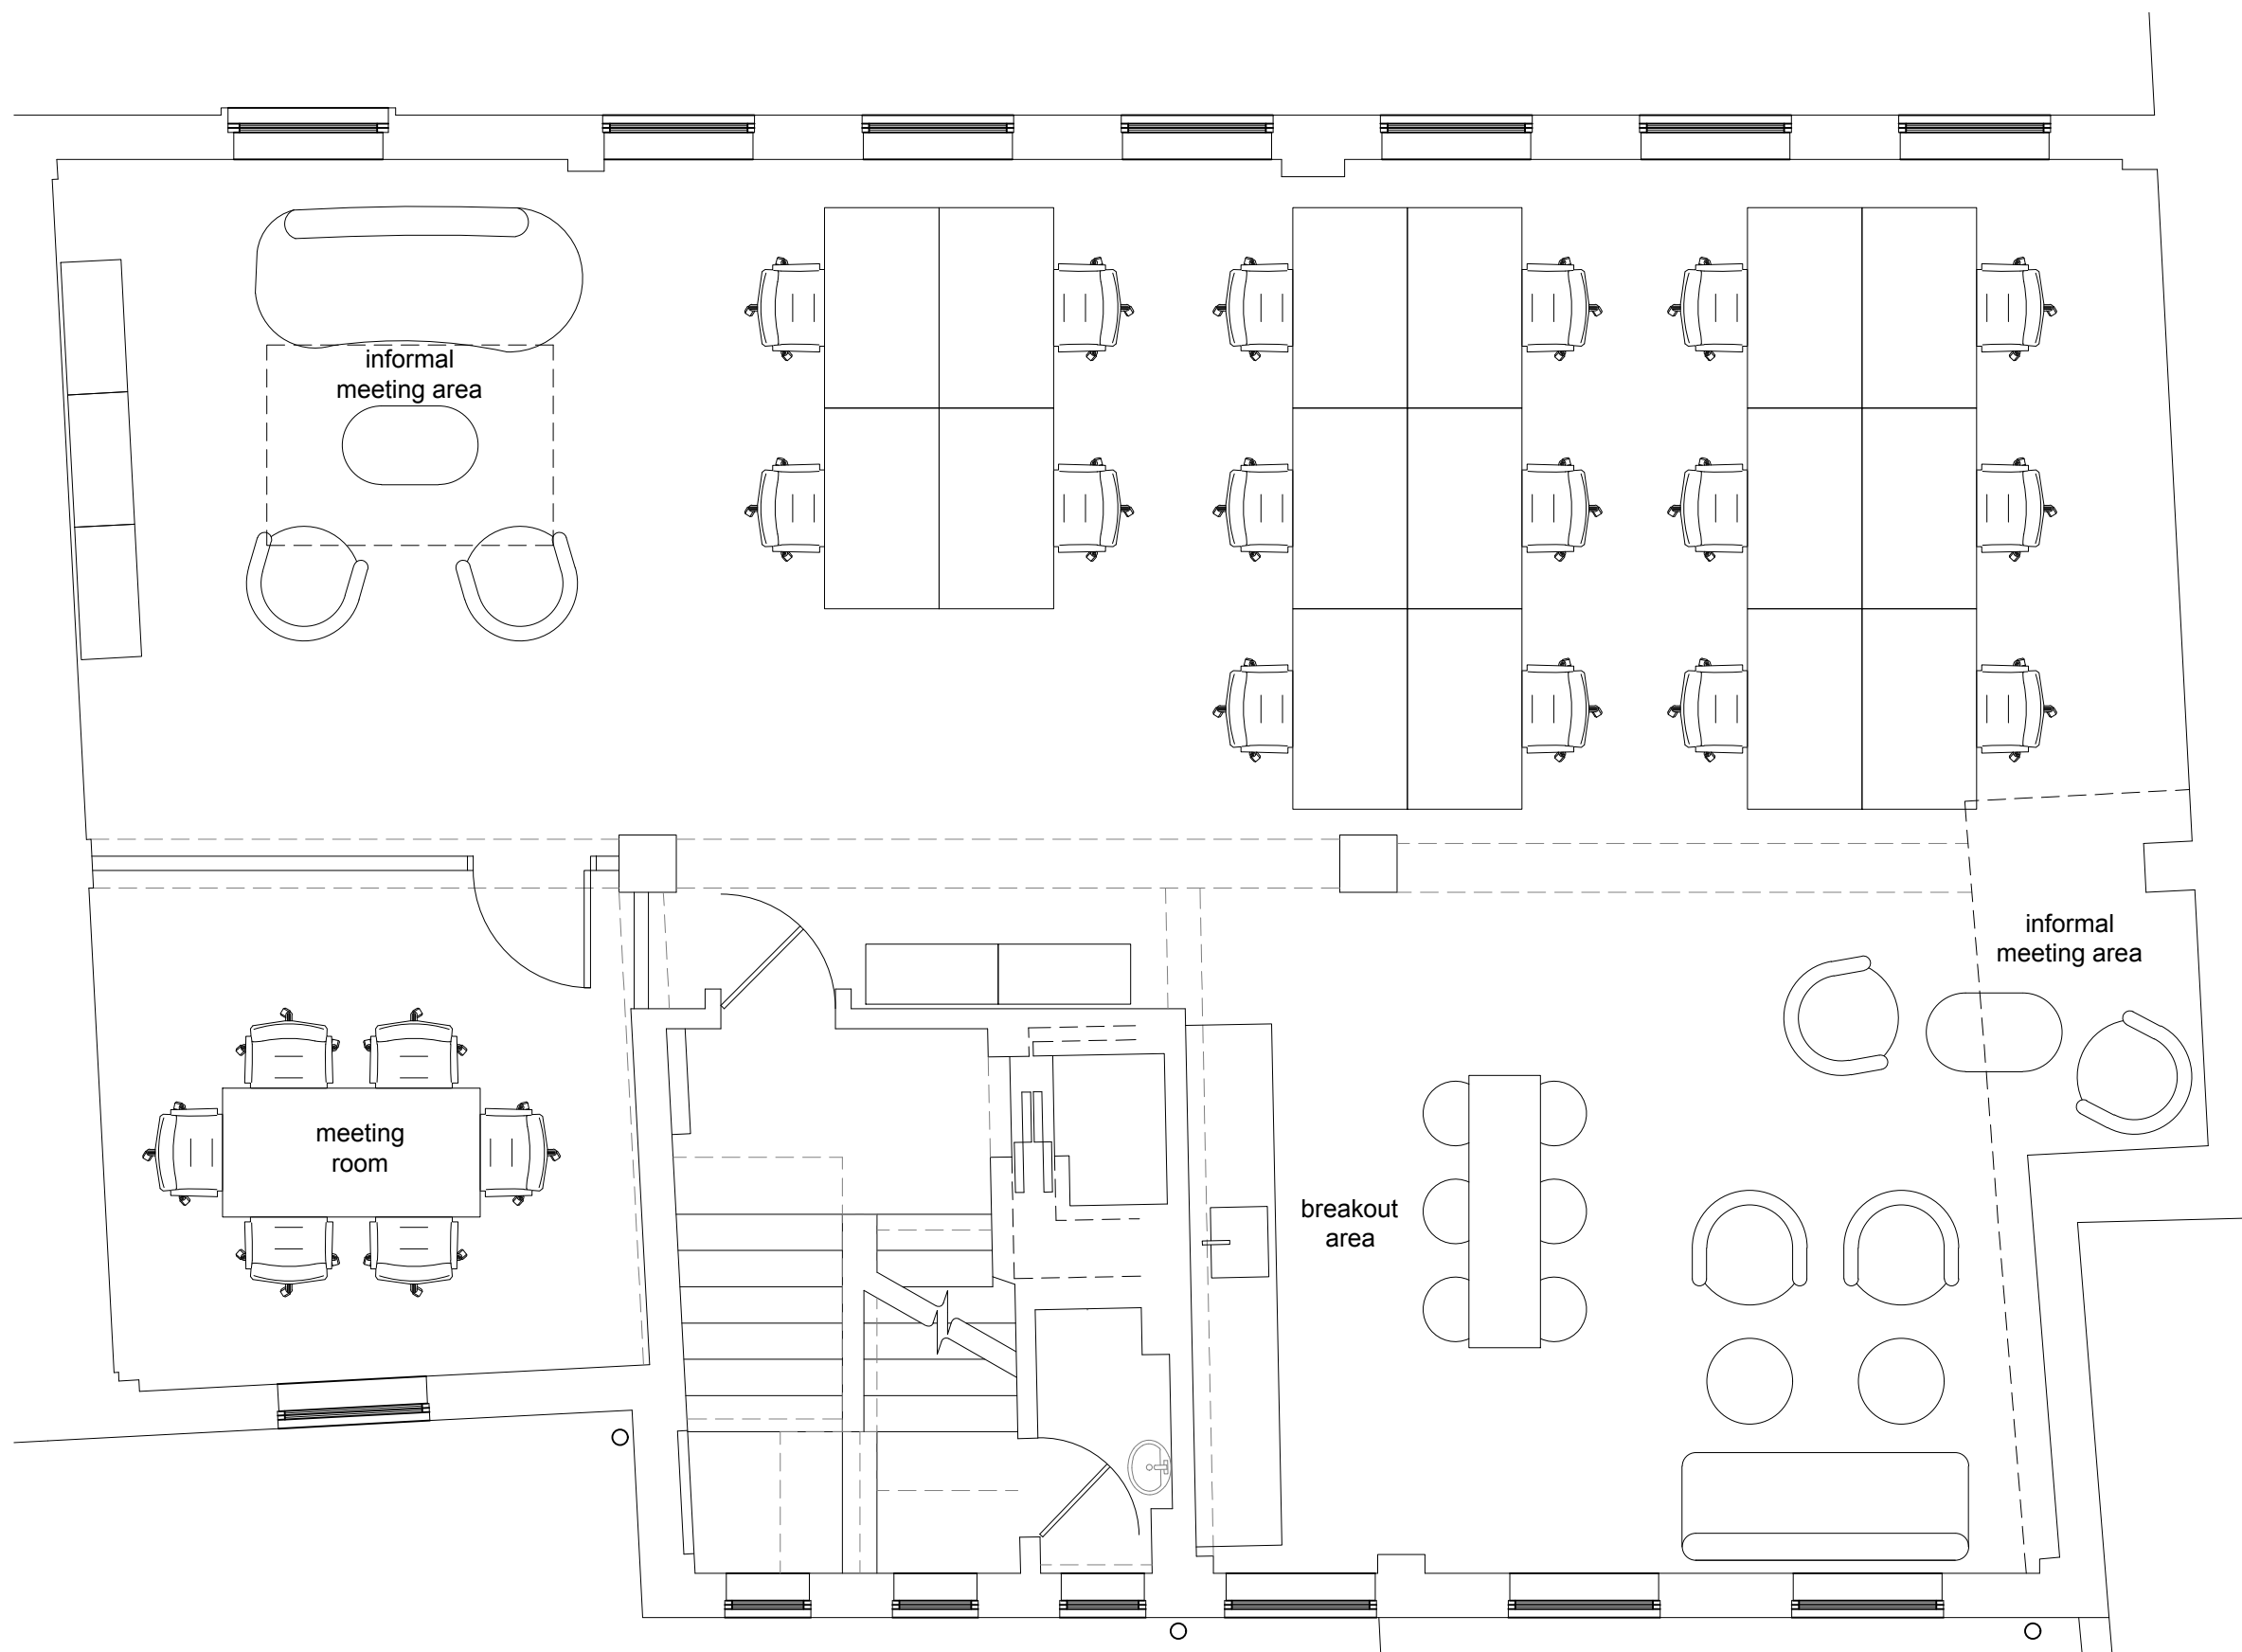

NOTE :
WHEN PRINTING PDF PLANS, ALWAYS ENSURE THAT :
1. "SIZE OPTION" IS SET TO ACTUAL SIZE OR "PAGE SCALING" IS SET TO NONE.
2. "CHOOSE PAPER SOURCE BY PDF PAGE SIZE" IS TICKED - BOTH SETTINGS ARE FOUND IN THE PRINTER DIALOGUE BOX.

address 45-49 LEATHER LANE LONDON EC1N 7NJ	location FIRST FLOOR FURNITURE LAYOUT (AS FITTED)	date APR. 2022	scale 1:50	sheet A3	RAYCAD CREATIVE SOLUTIONS
		dwg no. 1.02	revision -		