A1 Original - Do not scale - If in doubt ask

This drawing is copyright and reserved by McLaughlin & Harvey Construction Limited. This drawing may not be reproduced in any form without prior permission of McLaughlin & Harvey Construction Limited.
© McLaughlin & Harvey Construction Limited.

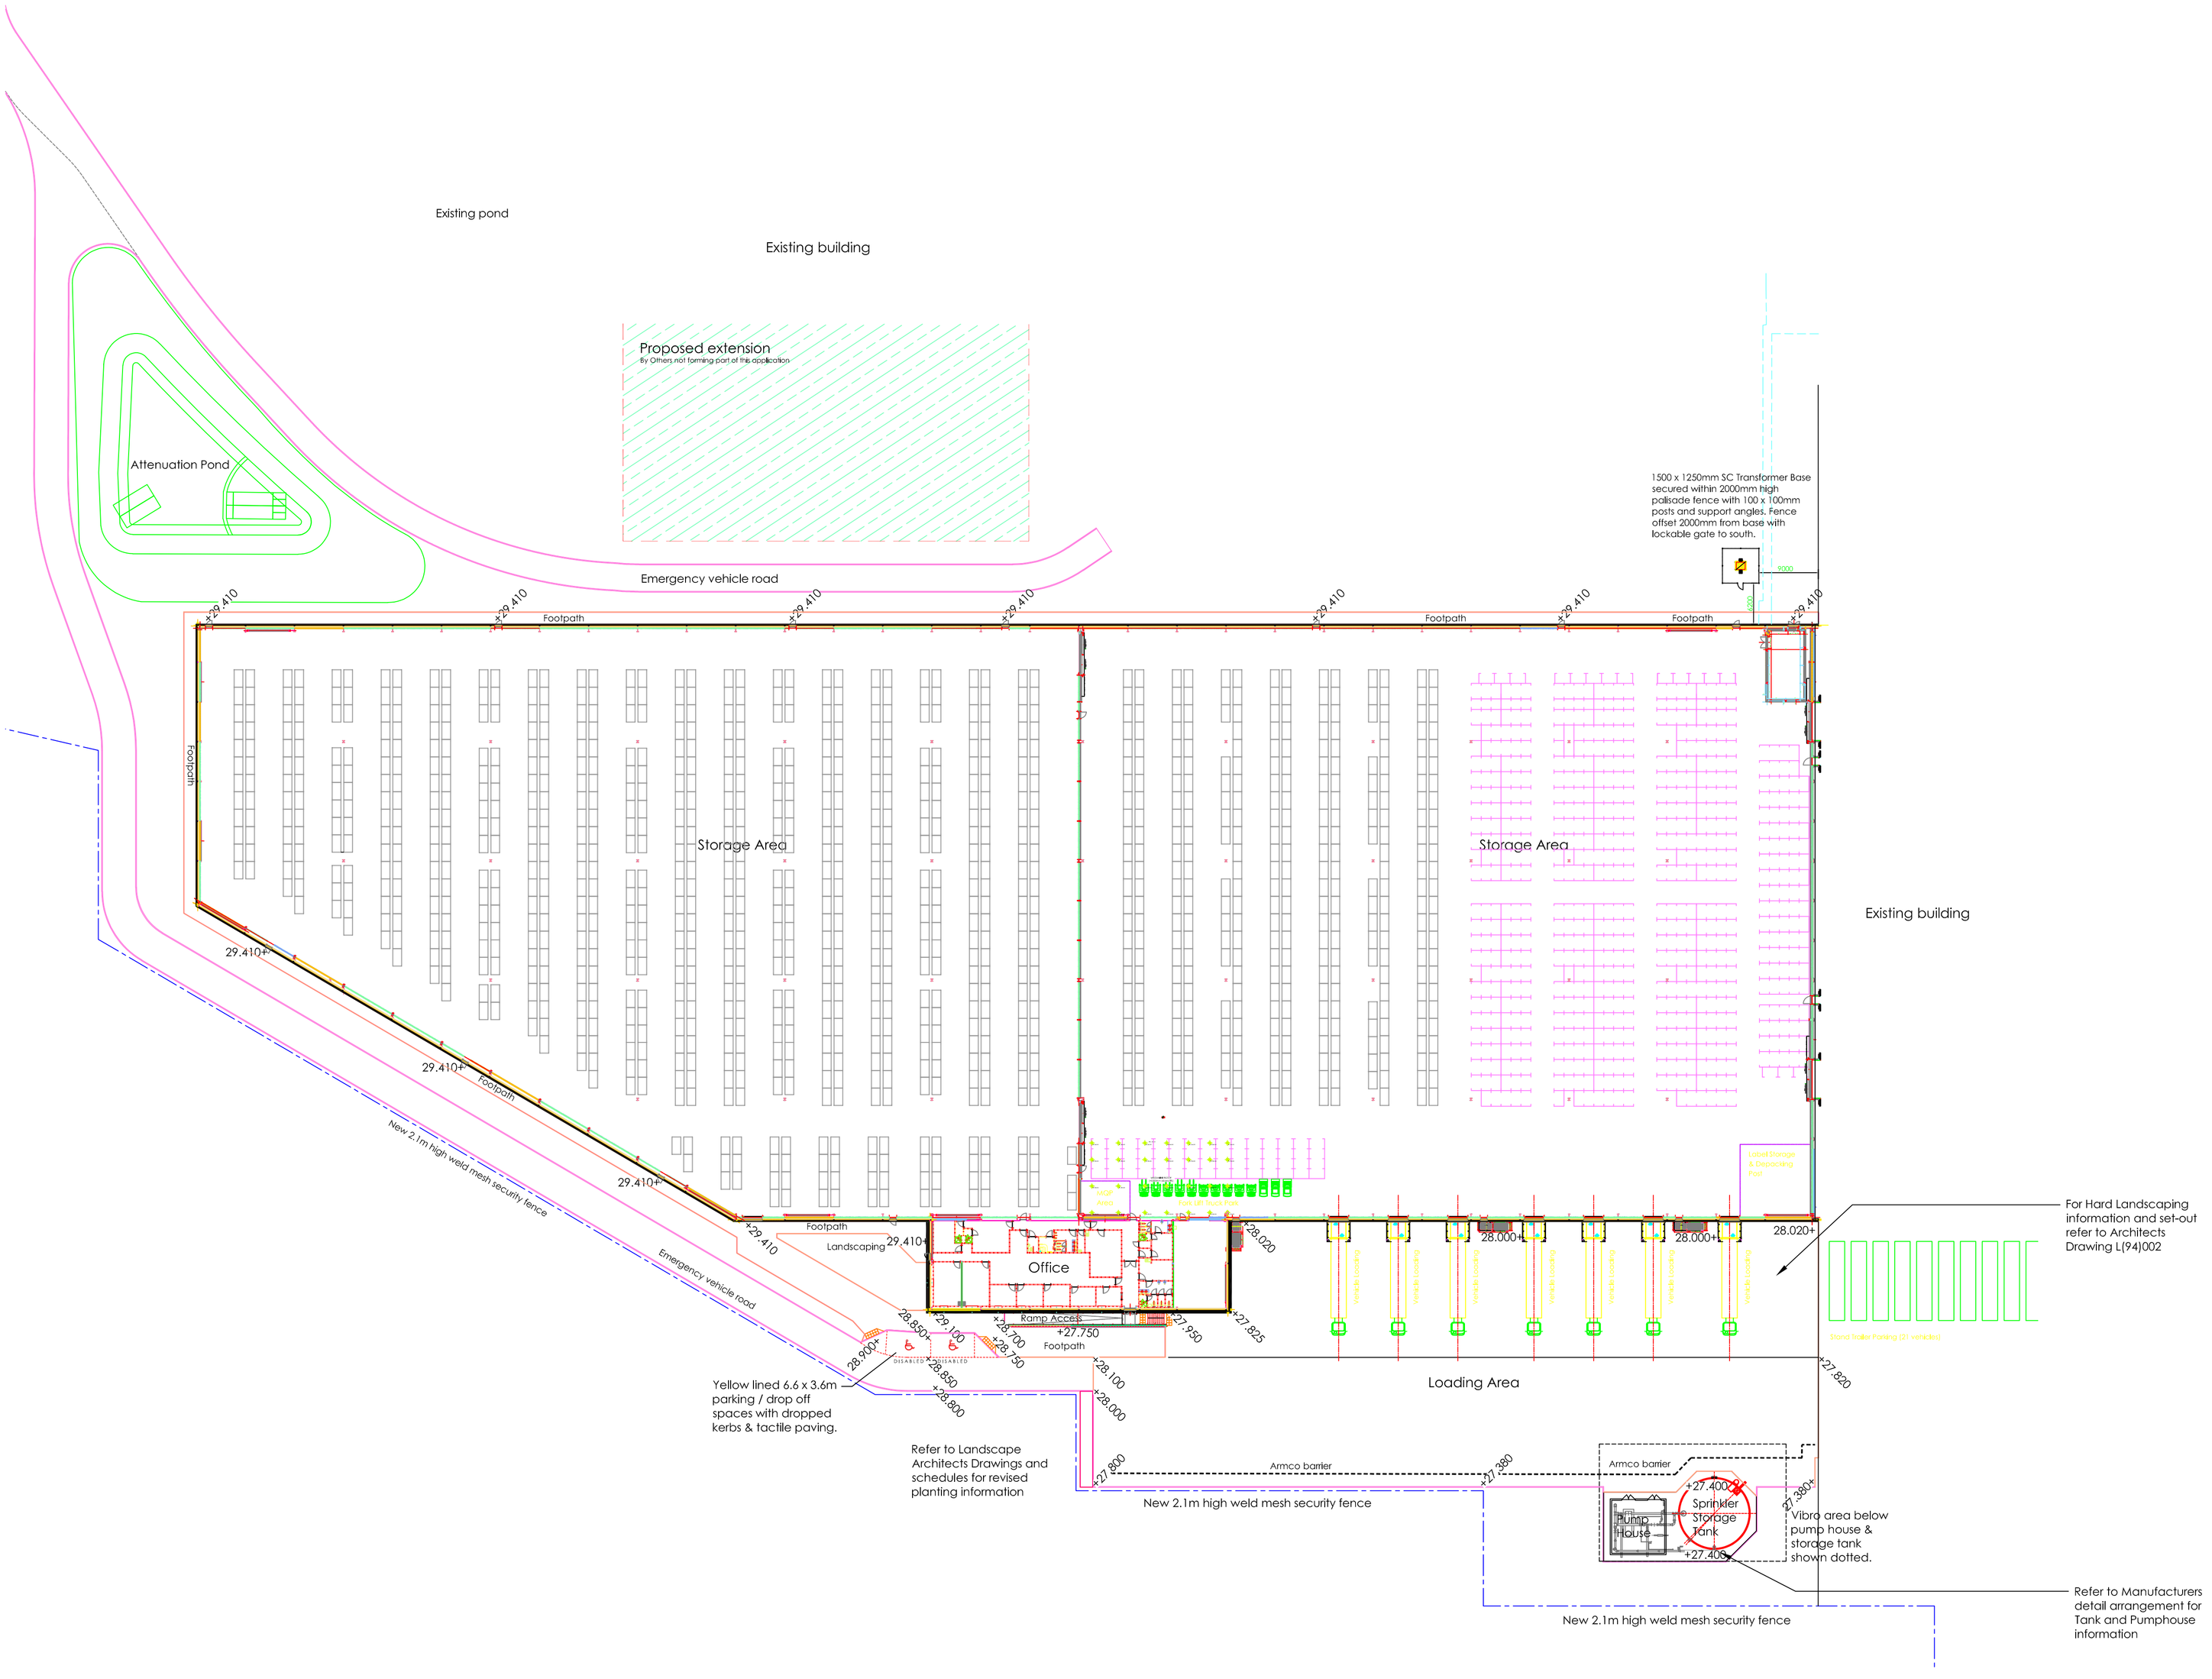

Note:

Landscaping layout is currently unavailable. Information will be added on receipt from Landscape Architect.

GENERAL NOTES:

Read this drawing in conjunction with the following series of drawings:
L(0-) Series: General Arrangement Dwgs

L(94) Series External Works

L(62)001 PV Transformer Base Layout

And in conjunction with:
- Structural Engineers Spec. & Details

- Mechanical & Electrical Services Spec. & Details

Rev	Description	Date	By
E	Updated to As Built	22/03/2016	LC
D	DDA parking / drop off spsces added.	02/03/2016	RT
C	Transformer Base location added	05/02/2016	LC
B	Sprinkler tank relocated to sit on existing vibro area. Levels added to sprinkler base.	16/10/2015	RT
A	Sprinkler tank / pump housing / slab & Armco barrier revised. Status revised to Construction.	14/10/2015	RT

McLaughlin & Harvey
technical services
100 INCHINNAN ROAD
PAISLEY
PA3 2RE
T: 0141 848 8000 F: 0141 848 8001

Status: AS BUILT

Client: Michelin Tyres Plc

Project Title: RLF2 New Extension
Baldovie Road, Dundee

Drawing Title: Proposed Site Plan

Scale	Date
1:500 @ A1	01/10/2015

Drawn by	Checked by	Approved by
AJ	RT	KJD

Job Code.	Drawing No.	Rev.
50009	L(0-)012	E

GENERAL ARRANGEMENT - Proposed Site Plan

Scale 1:500