



**OPTION 1
AS EXISTING**

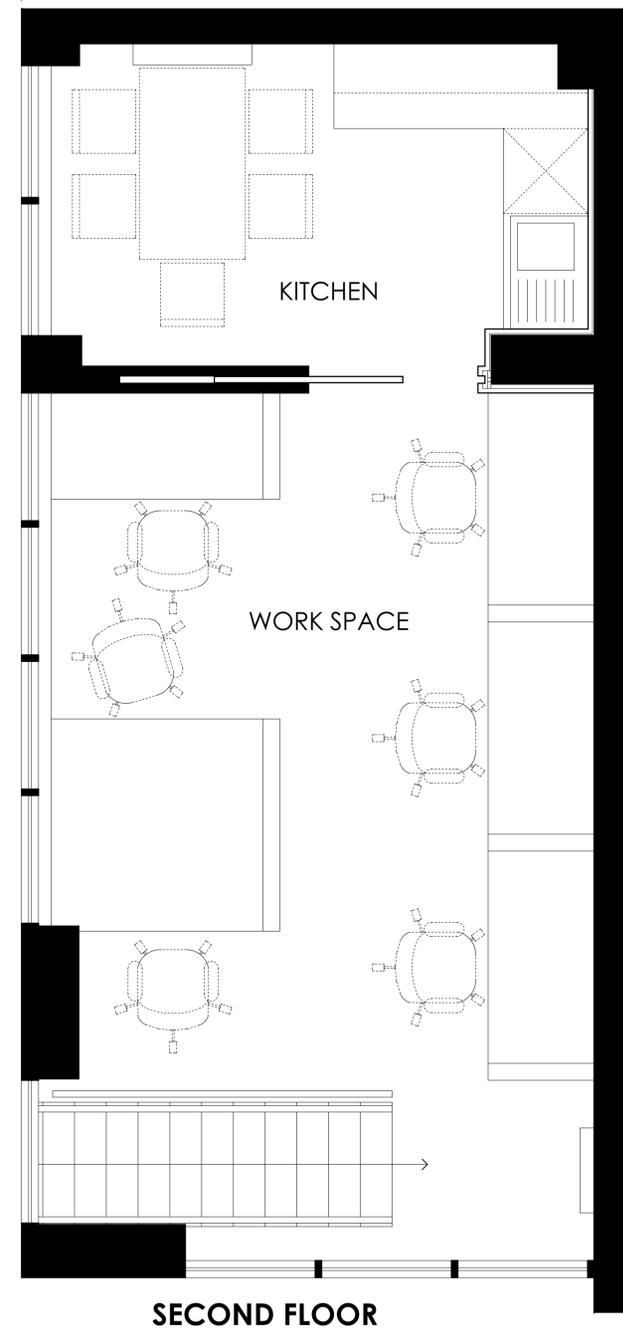

UNIT 6 WALMER COURTYARD
225 WALMER ROAD
HOLLAND PARK
W11 4EY

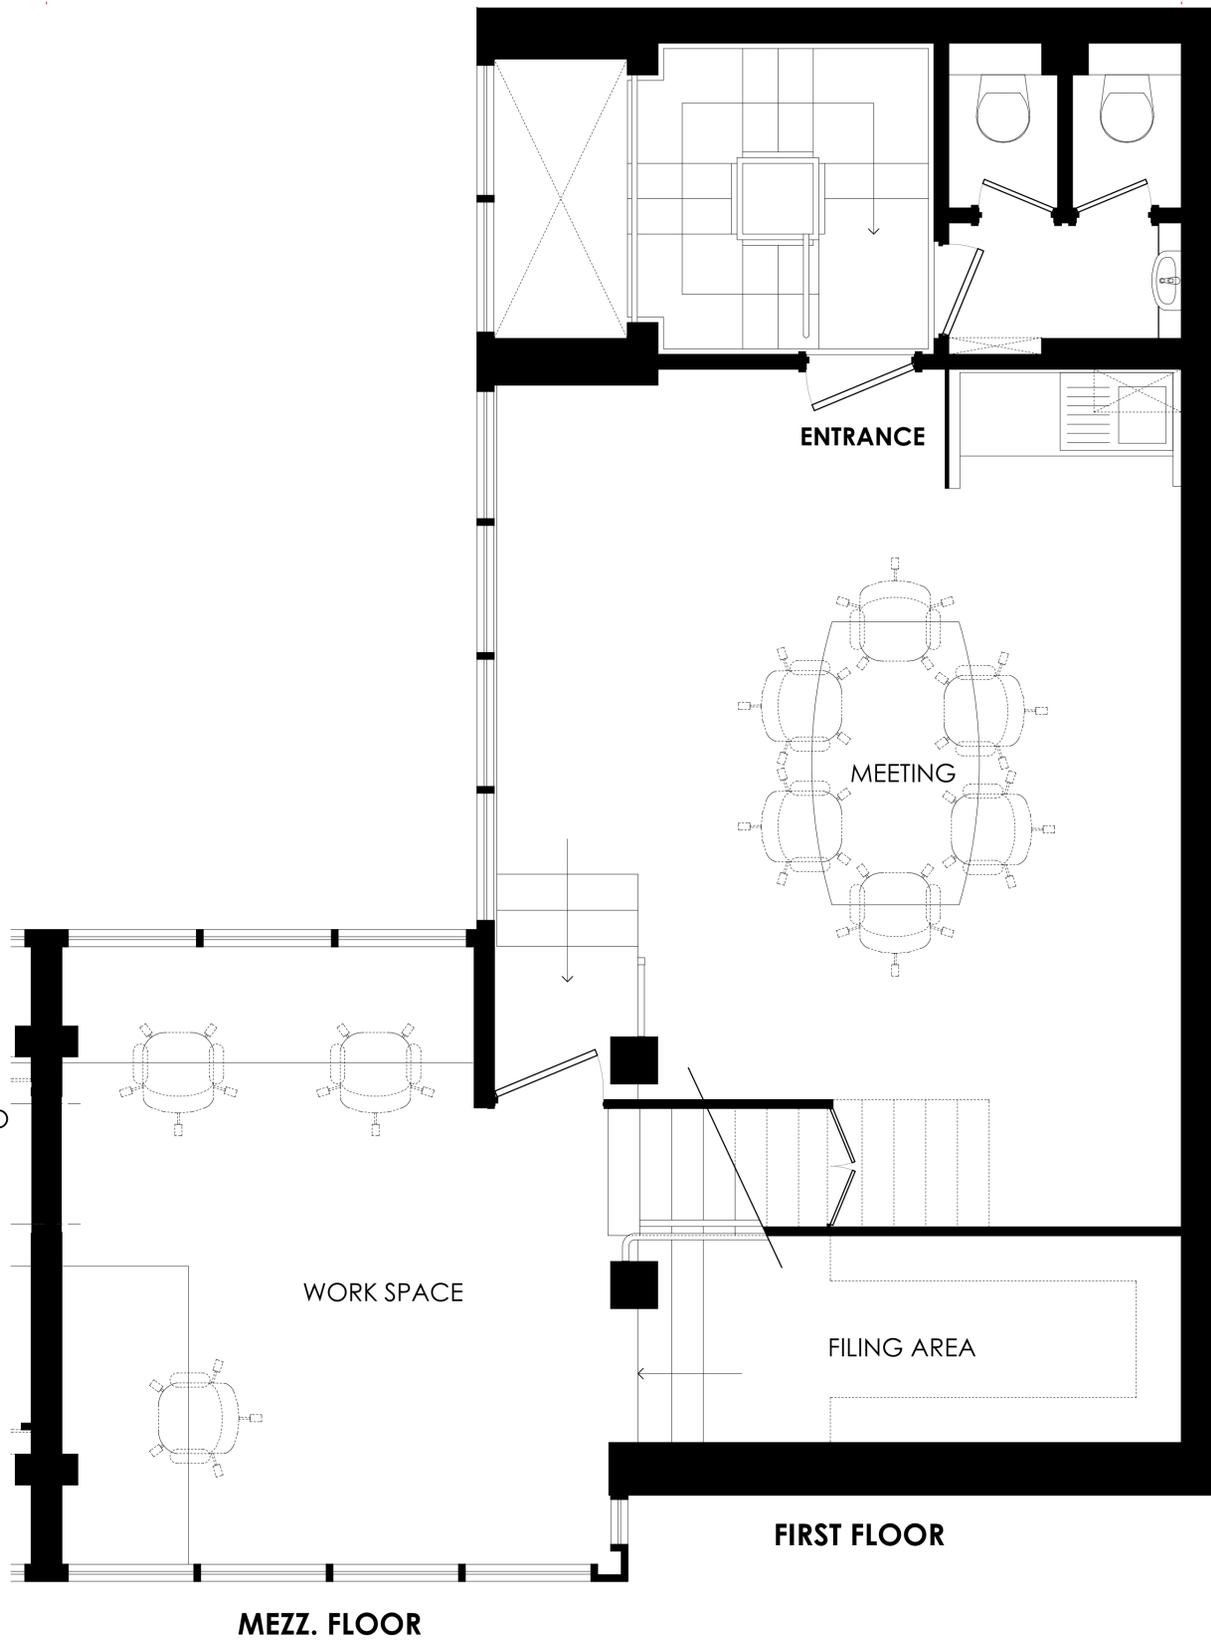

1:50 @ A3

1:50 SCALE BAR



Do not scale this from drawing:
All dimensions to be checked on site.
Any layouts are approximate.

31st August 2019