



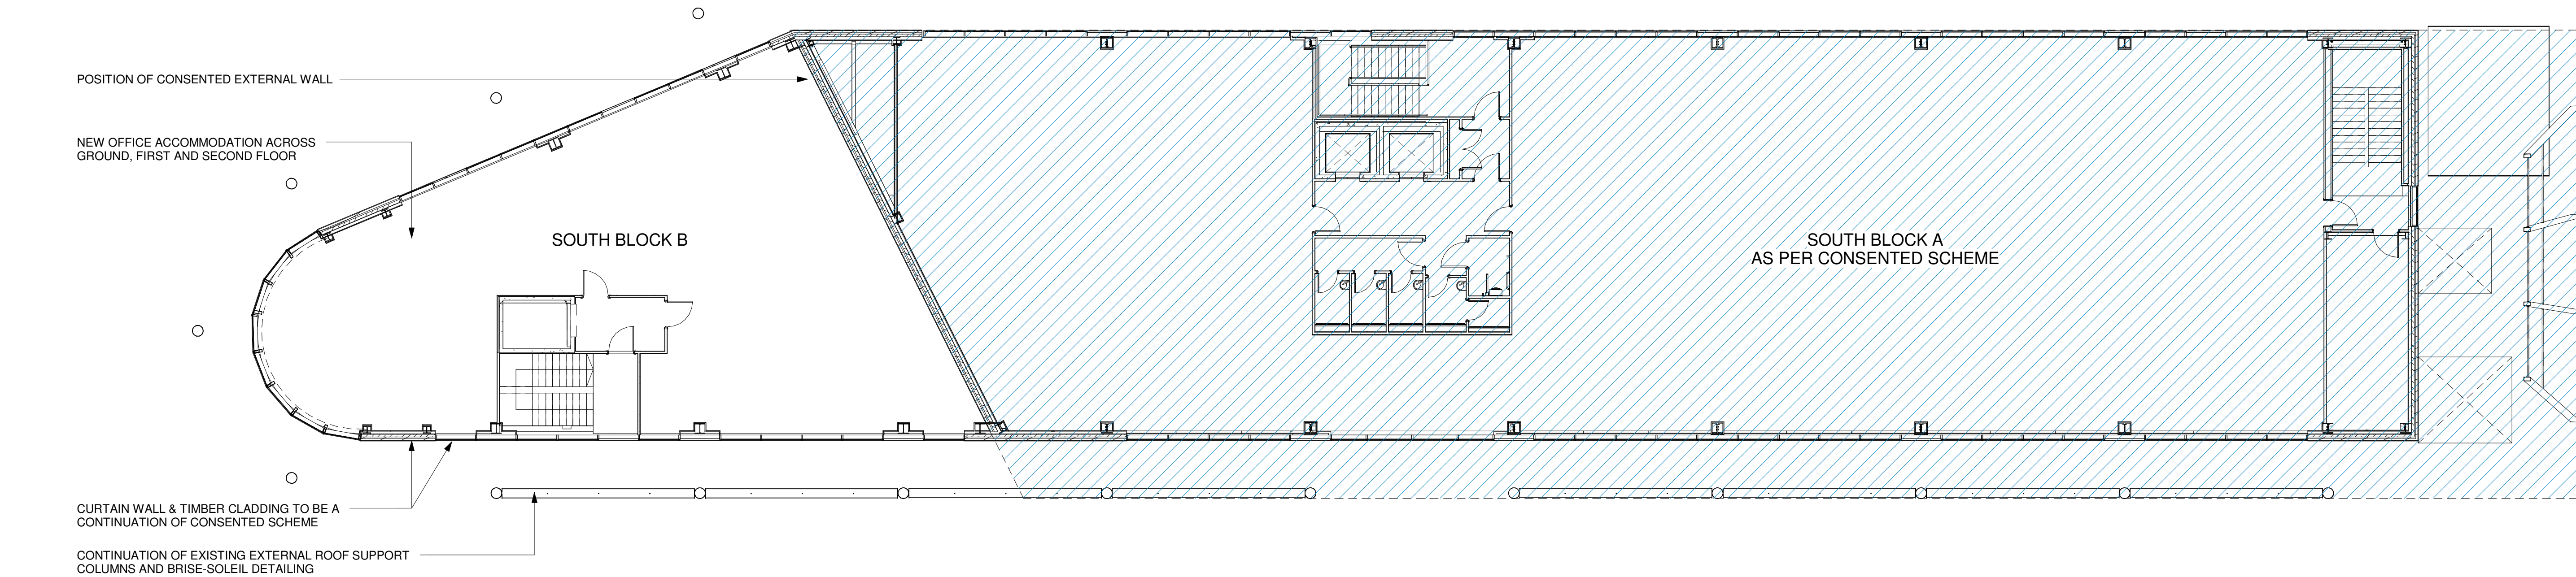

2 SOUTH BLOCK - SECOND FLOOR PLAN


1 : 125

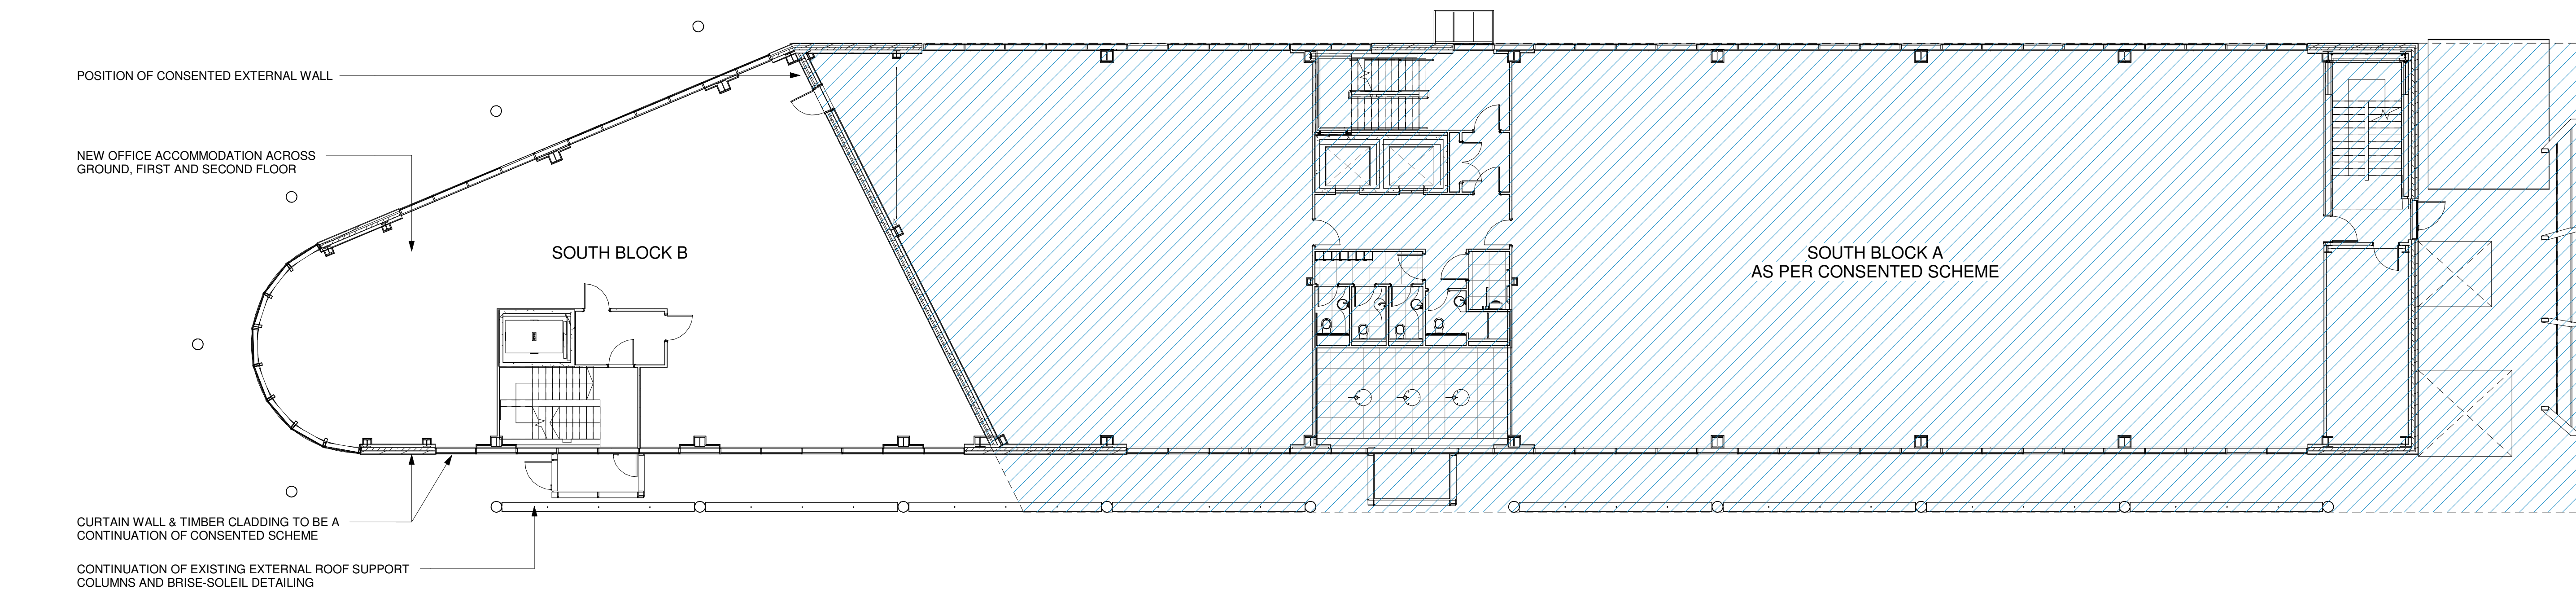

1 SOUTH BLOCK - FIRST FLOOR PLAN

1 : 125

notes: **NOTE** - ALL AREAS OF THE SOUTH BLOCK HATCHED IN BLUE ARE TO BE IN FULL ACCORDANCE WITH THE CONSENTED / CONSENTED NMA PERMISSIONS.

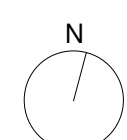

NOTE: The contractor is responsible for checking all site dimensions and levels. These should be checked prior to the ordering of any components and before the commencement of the works. All discrepancies should be brought to the attention of the Contract Administrator.

revisions: B 01/02/2021 LP MMA information amended
A 27/06/2018 NC MMA information amended

C&G Properties
Chilcomb Centre
Winchester
drawing information

title:

MMA FLOOR
PLANS

status:
date:
scale:
drawn:
chk'd:

PLANNING
15/02/18
1 : 125
NC
SL

job: 5714
dwg: P-1201
rev: B

pwparchitects
PWP Architects Ltd 61 South Street, Havant, Hampshire PO9 1BZ
t: 02392 482494 f: 02392 481152
e: design@pwp-architects.com
w: www.pwp-architects.com

01/02/2021 16:52:37