


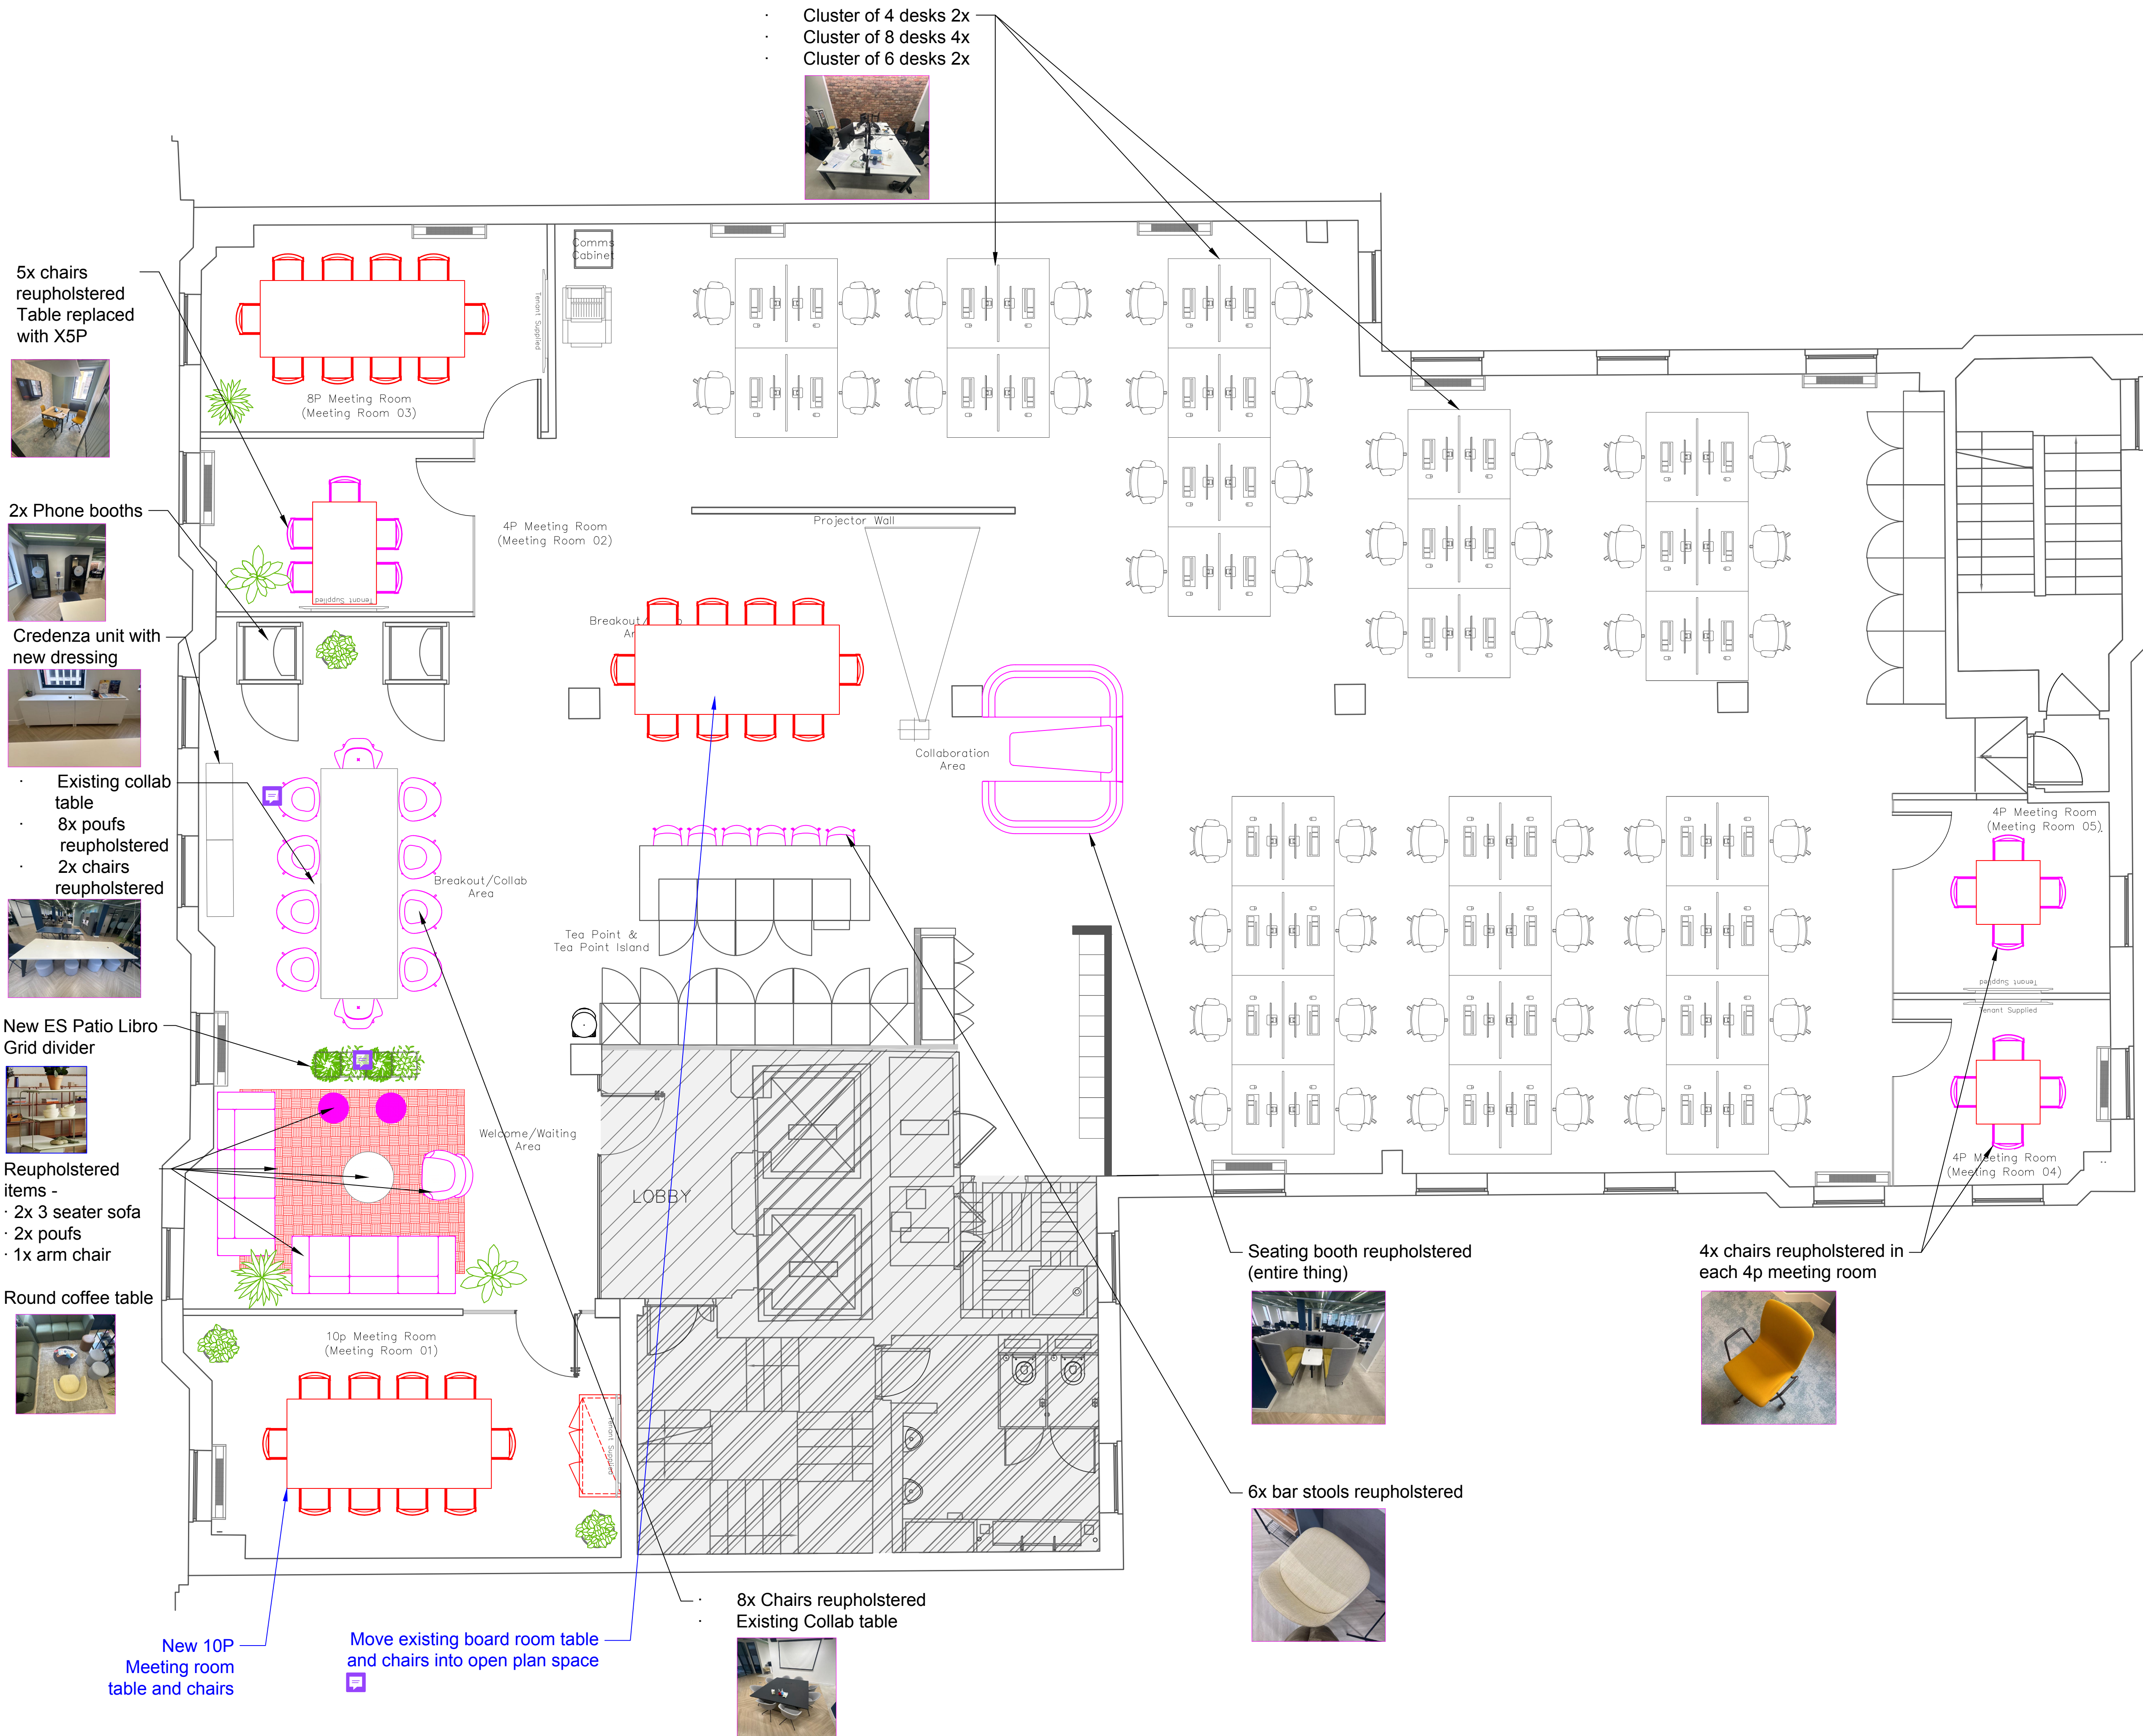

NOTES :

DO NOT SCALE FROM THIS DRAWING. ALL MEASUREMENTS MUST BE SITE CHECKED BEFORE THE COMMENCEMENT OF ANY WORK.

IF APPLICABLE:

DESK SIZE :	1400 x 800 mm
DESK QTY:	52 desks
SQFT :	4 710 sqft

NEW - Furniture Items

EXISTING - Furniture Items

EXISTING - To Be Reupholstered

- GENERAL NOTE:
- All new dressing to be specified & costed
 - Task chairs to be surveyed to ensure all are adequate for re-use
 - Deep clean of existing furniture staying and being reupholstered
 - Items to be reupholstered needs to be costed
 - If planters remain, these are to be re-used
 - Power for TV/AV in Meeting Room 03 to be costed as new position for TV proposed
 - New furniture items to be specified and costed
 - New dressing for the tea point to be specified and costed
 - Cost option for desk screens to be included
 - New manifestation to be costed for phone booths

C02	20/08/26	Updated following on-site client review	JRL	-
C01	14/05/26	First Issue	CM	-
REV	DATE	ISSUE	BY	CH

STATUS: FOR CONSTRUCTION



PROJECT :	51-53 GMS Communals & Externals
CLIENT :	Blackrock
LEVEL :	03
DESCRIPTION :	General Arrangement - Furniture Re-use
SCALE :	1:50 @ A1
DRAWING No :	J5339_CST_DR_A_03_100_00010
REVISION :	C02