


G t P u l t e n e y S t

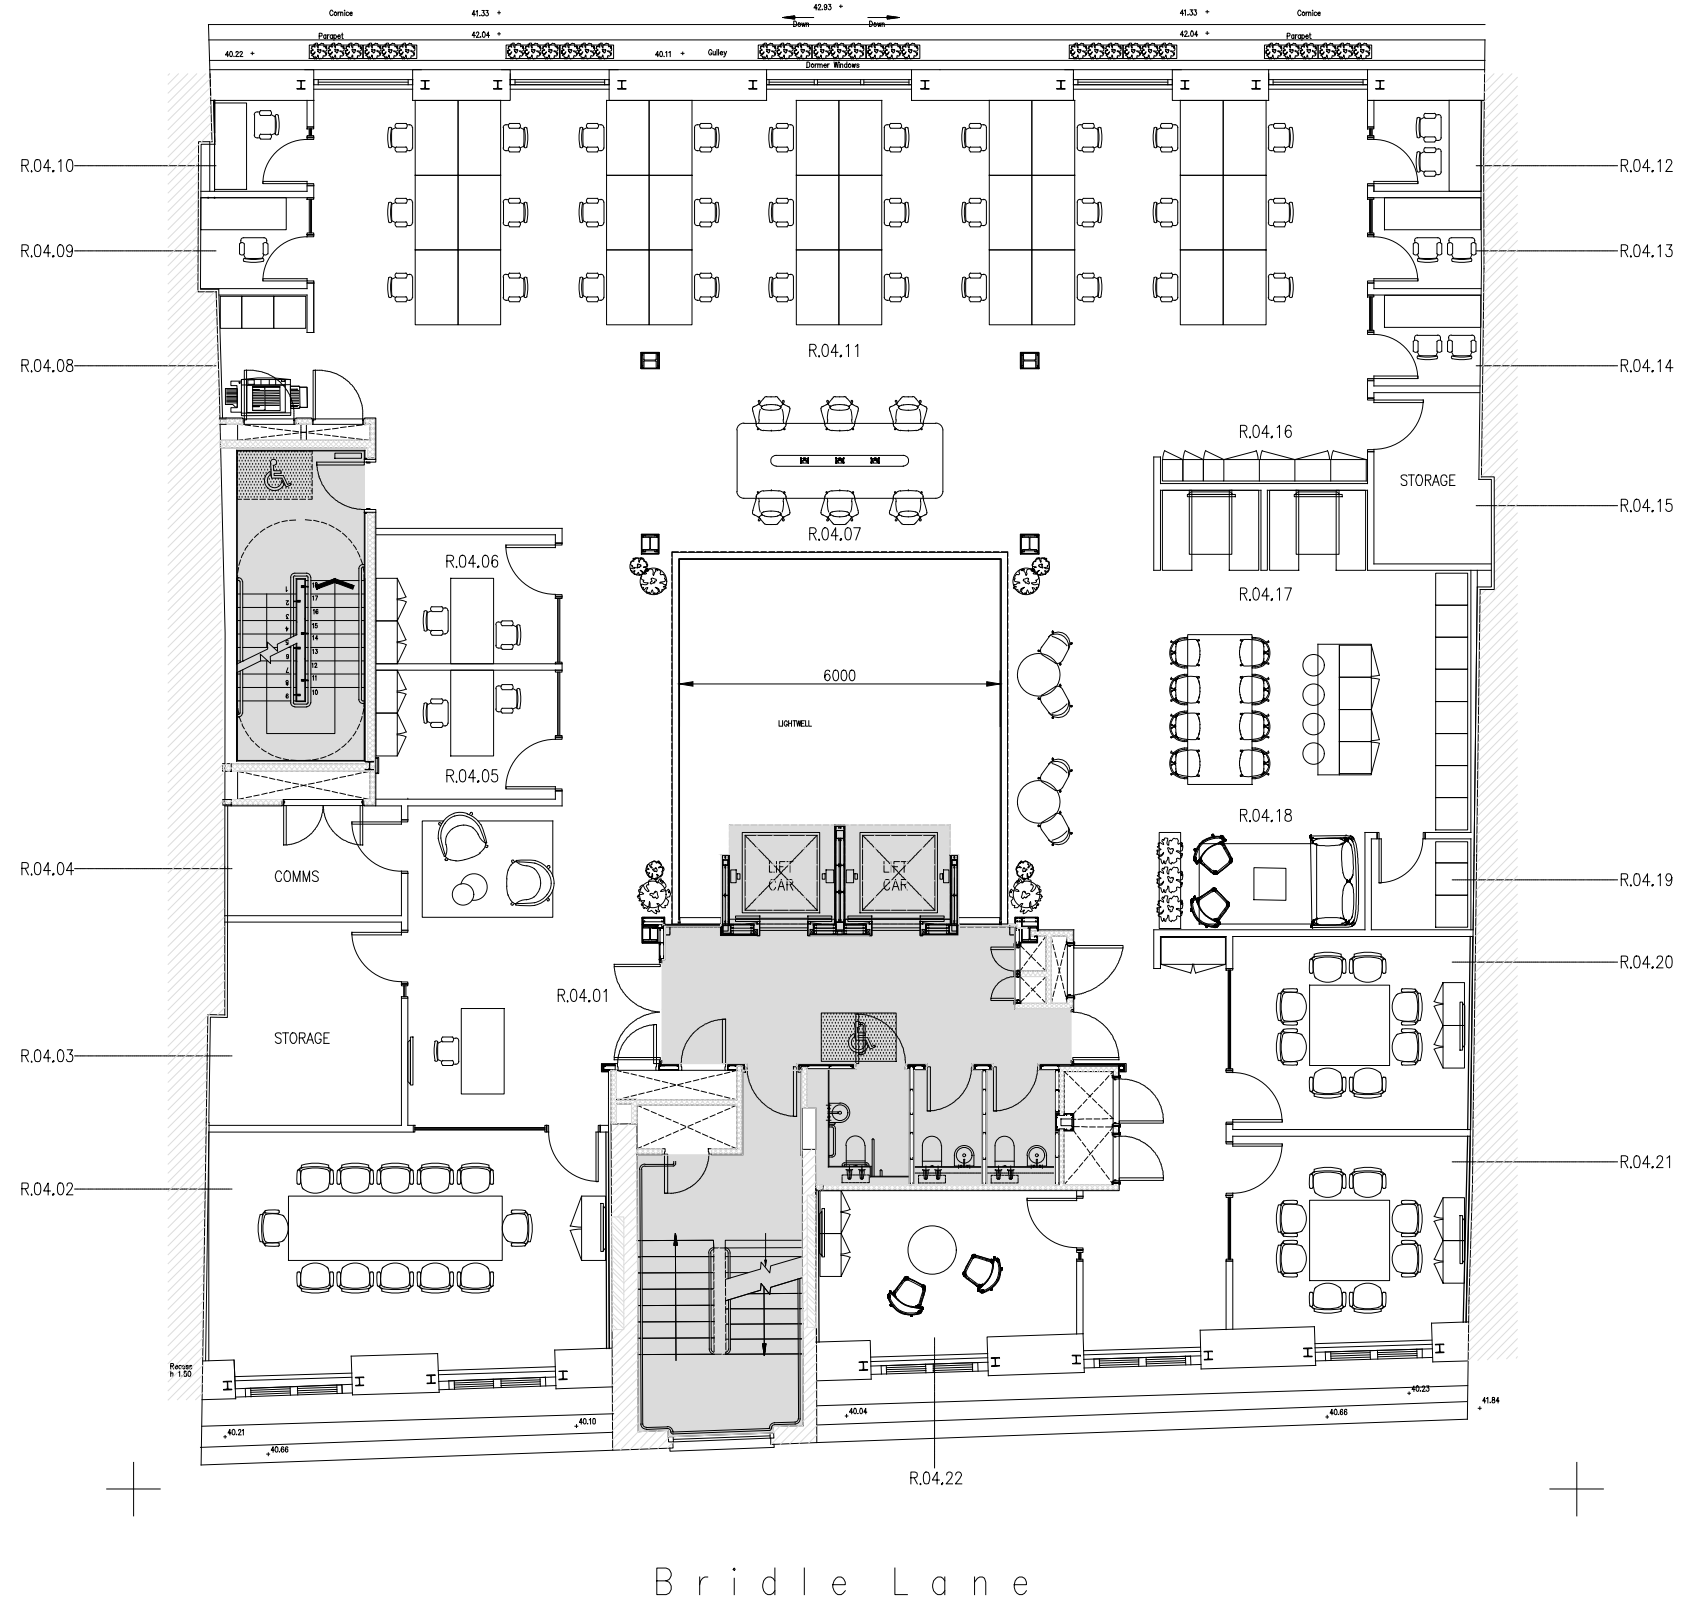

B r i d l e L a n e

DO NOT SCALE ANY DIMENSIONS OFF THIS DRAWING. ANY DISCREPANCIES BETWEEN THIS DRAWING AND OTHER INFORMATION ARE TO BE REFERRED TO SHAW STUDIOS. WHERE THE DRAWING RELATES TO AN EXISTING BUILDING OR COMPLETED CONSTRUCTION THE CONTRACTOR IS RESPONSIBLE FOR CHECKING THAT THERE IS NO CONFLICT BETWEEN ACTUAL BUILDING DIMENSIONS AND DRAWING DIMENSIONS. IN THE EVENT OF DISCREPANCIES BETWEEN THIS DRAWING AND SUBCONTRACTORS APPROVED WORKING DRAWINGS FOR RELEVANT BUILDING COMPONENTS, THE SUBCONTRACTORS DRAWING SHALL TAKE PRECEDENCE. ANY CONFLICTS ARISING OUT OF INFORMATION AS NOTED ABOVE MUST BE REPORTED IMMEDIATELY TO SHAW STUDIOS. THIS DRAWING IS THE COPYRIGHT OF SHAW STUDIOS. ALL DIMENSIONS ARE IN MILLIMETRES UNLESS OTHERWISE STATED.

REFER TO P288-23-I-05-104 FOR FIXED JOINERY ITEMS
 REFER TO FORUM FURNITURE LAYOUT OFR FINAL FURNITURE SELECTION, SETTING OUT AND SPECIFICATION

REV	DATE	PURPOSE OF ISSUE	BY
R 30.01.24		RECORD	ZT
C130.11.23		CONSTRUCTION	ZT
- 17.11.23		INFORMATION	ZT

client	SRSLS REGENT HOUSE, 41 GREAT PULTENEY ST LONDON. W1F 9NZ
project	4TH FLOOR REFURBISHMENT GOLDEN HOUSE, 30 GREAT PULTENEY ST LONDON

drawing title	FOURTH FLOOR GENERAL ARRANGEMENT PLAN		
date	21.07.23	scale	1:100@A2
dwn.	SH	rev.	R
drawing number	P288-23-I-03-104		

shaw	
Unit 217, Bon Marche Centre, 241 Finsdale Road, London, SW9 8BJ tel: 020 7274 3506 www.shawstudios.co.uk	
status	RECORD