



GENERAL NOTE  
 This drawing is to be read in conjunction with all other relevant drawings, schedules and specifications issued.  
 All interior dimensions including ceiling heights are taken to and from finished surfaces unless otherwise stated. All levels and dimensions must be checked on site.  
 Any discrepancies with the information depicted in this drawing must be reported in writing. Responsibility cannot be accepted for alterations made to this drawing without prior permission.  
 This drawing must not be photocopied, scaled or reproduced otherwise scale accuracy cannot be guaranteed.  
 This drawing should not be used in any circumstances for any structural calculation or building construction / demolition work.

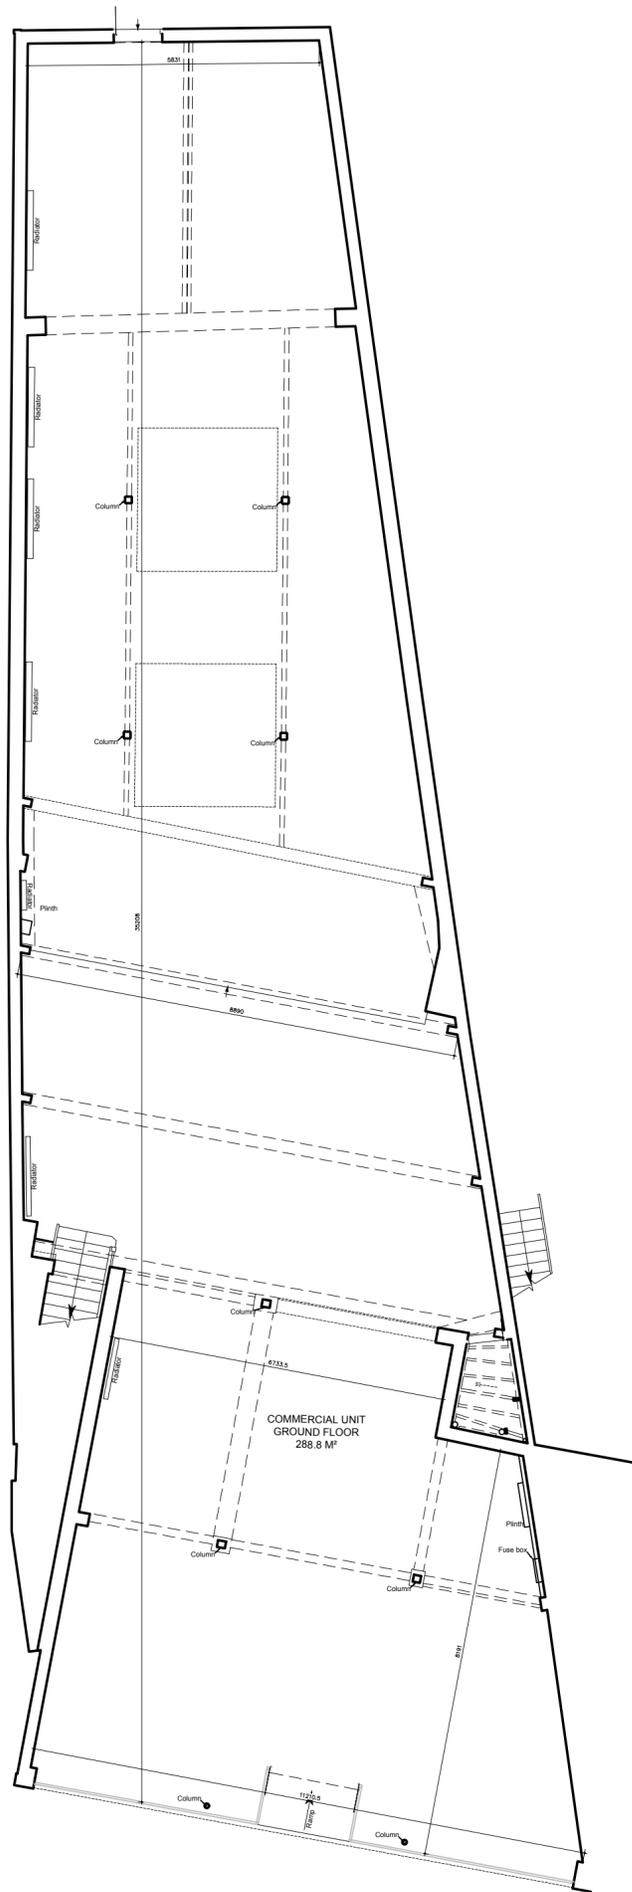

EXISTING GROUND FLOOR PLAN

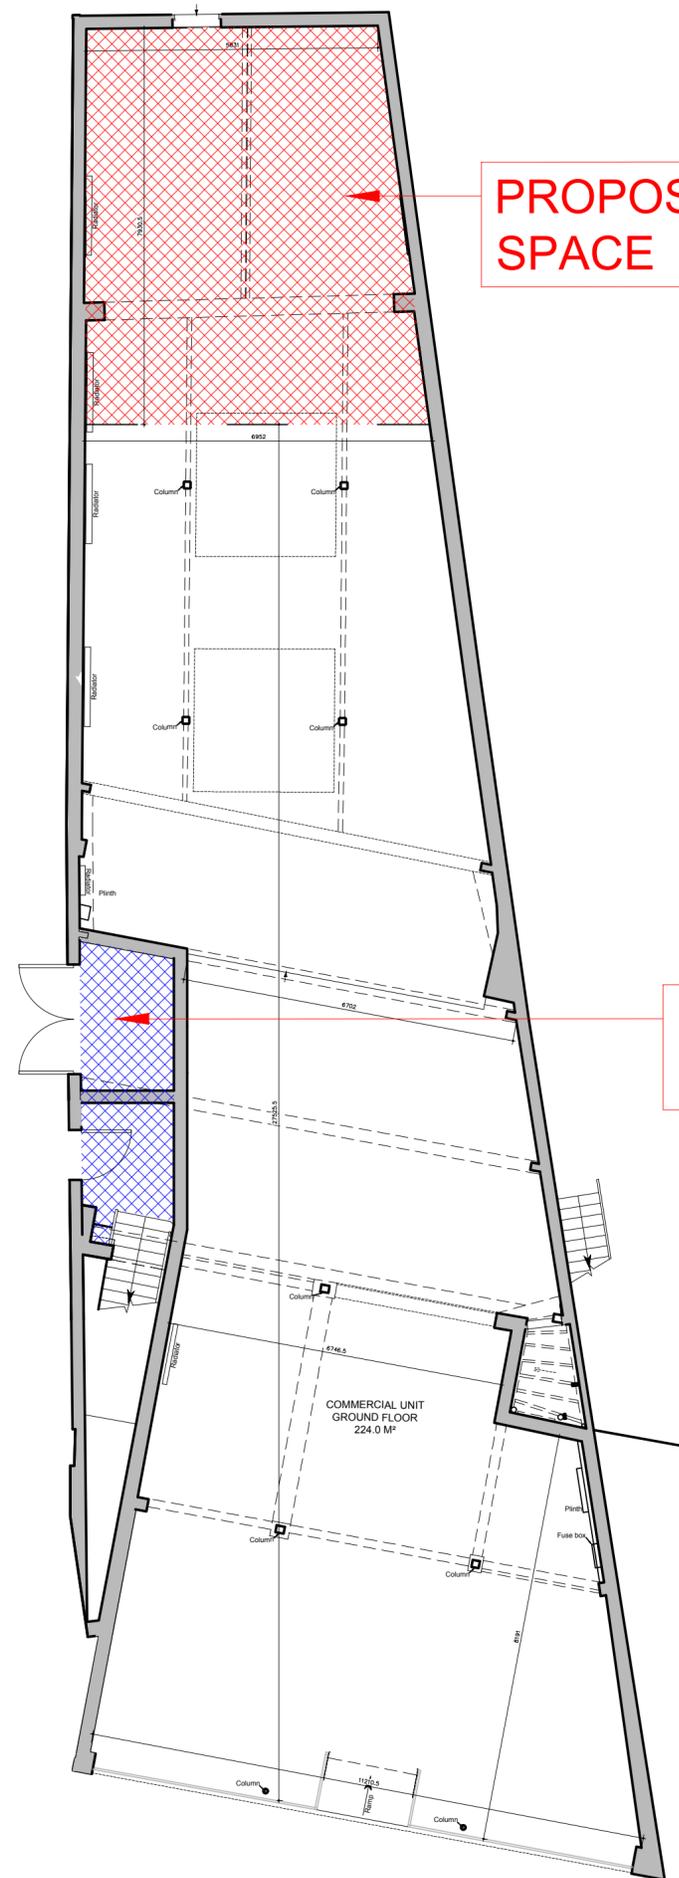

PROPOSED 50SQM SPACE

PROPOSED 10.3SQM REFUSE SPACE

PROPOSED GROUND FLOOR PLAN  
 224.0 SQM



PROJECT TITLE		
131 HIGH STREET STAINES		
DRAWING TITLE		
EXISTING + PROPOSED GROUND FLOOR		
AREA		
SCALE	SIZE	DRAWING
1:100	A2	01
DRAWN	CHECKED	DATE
AYH		17/12/2025