
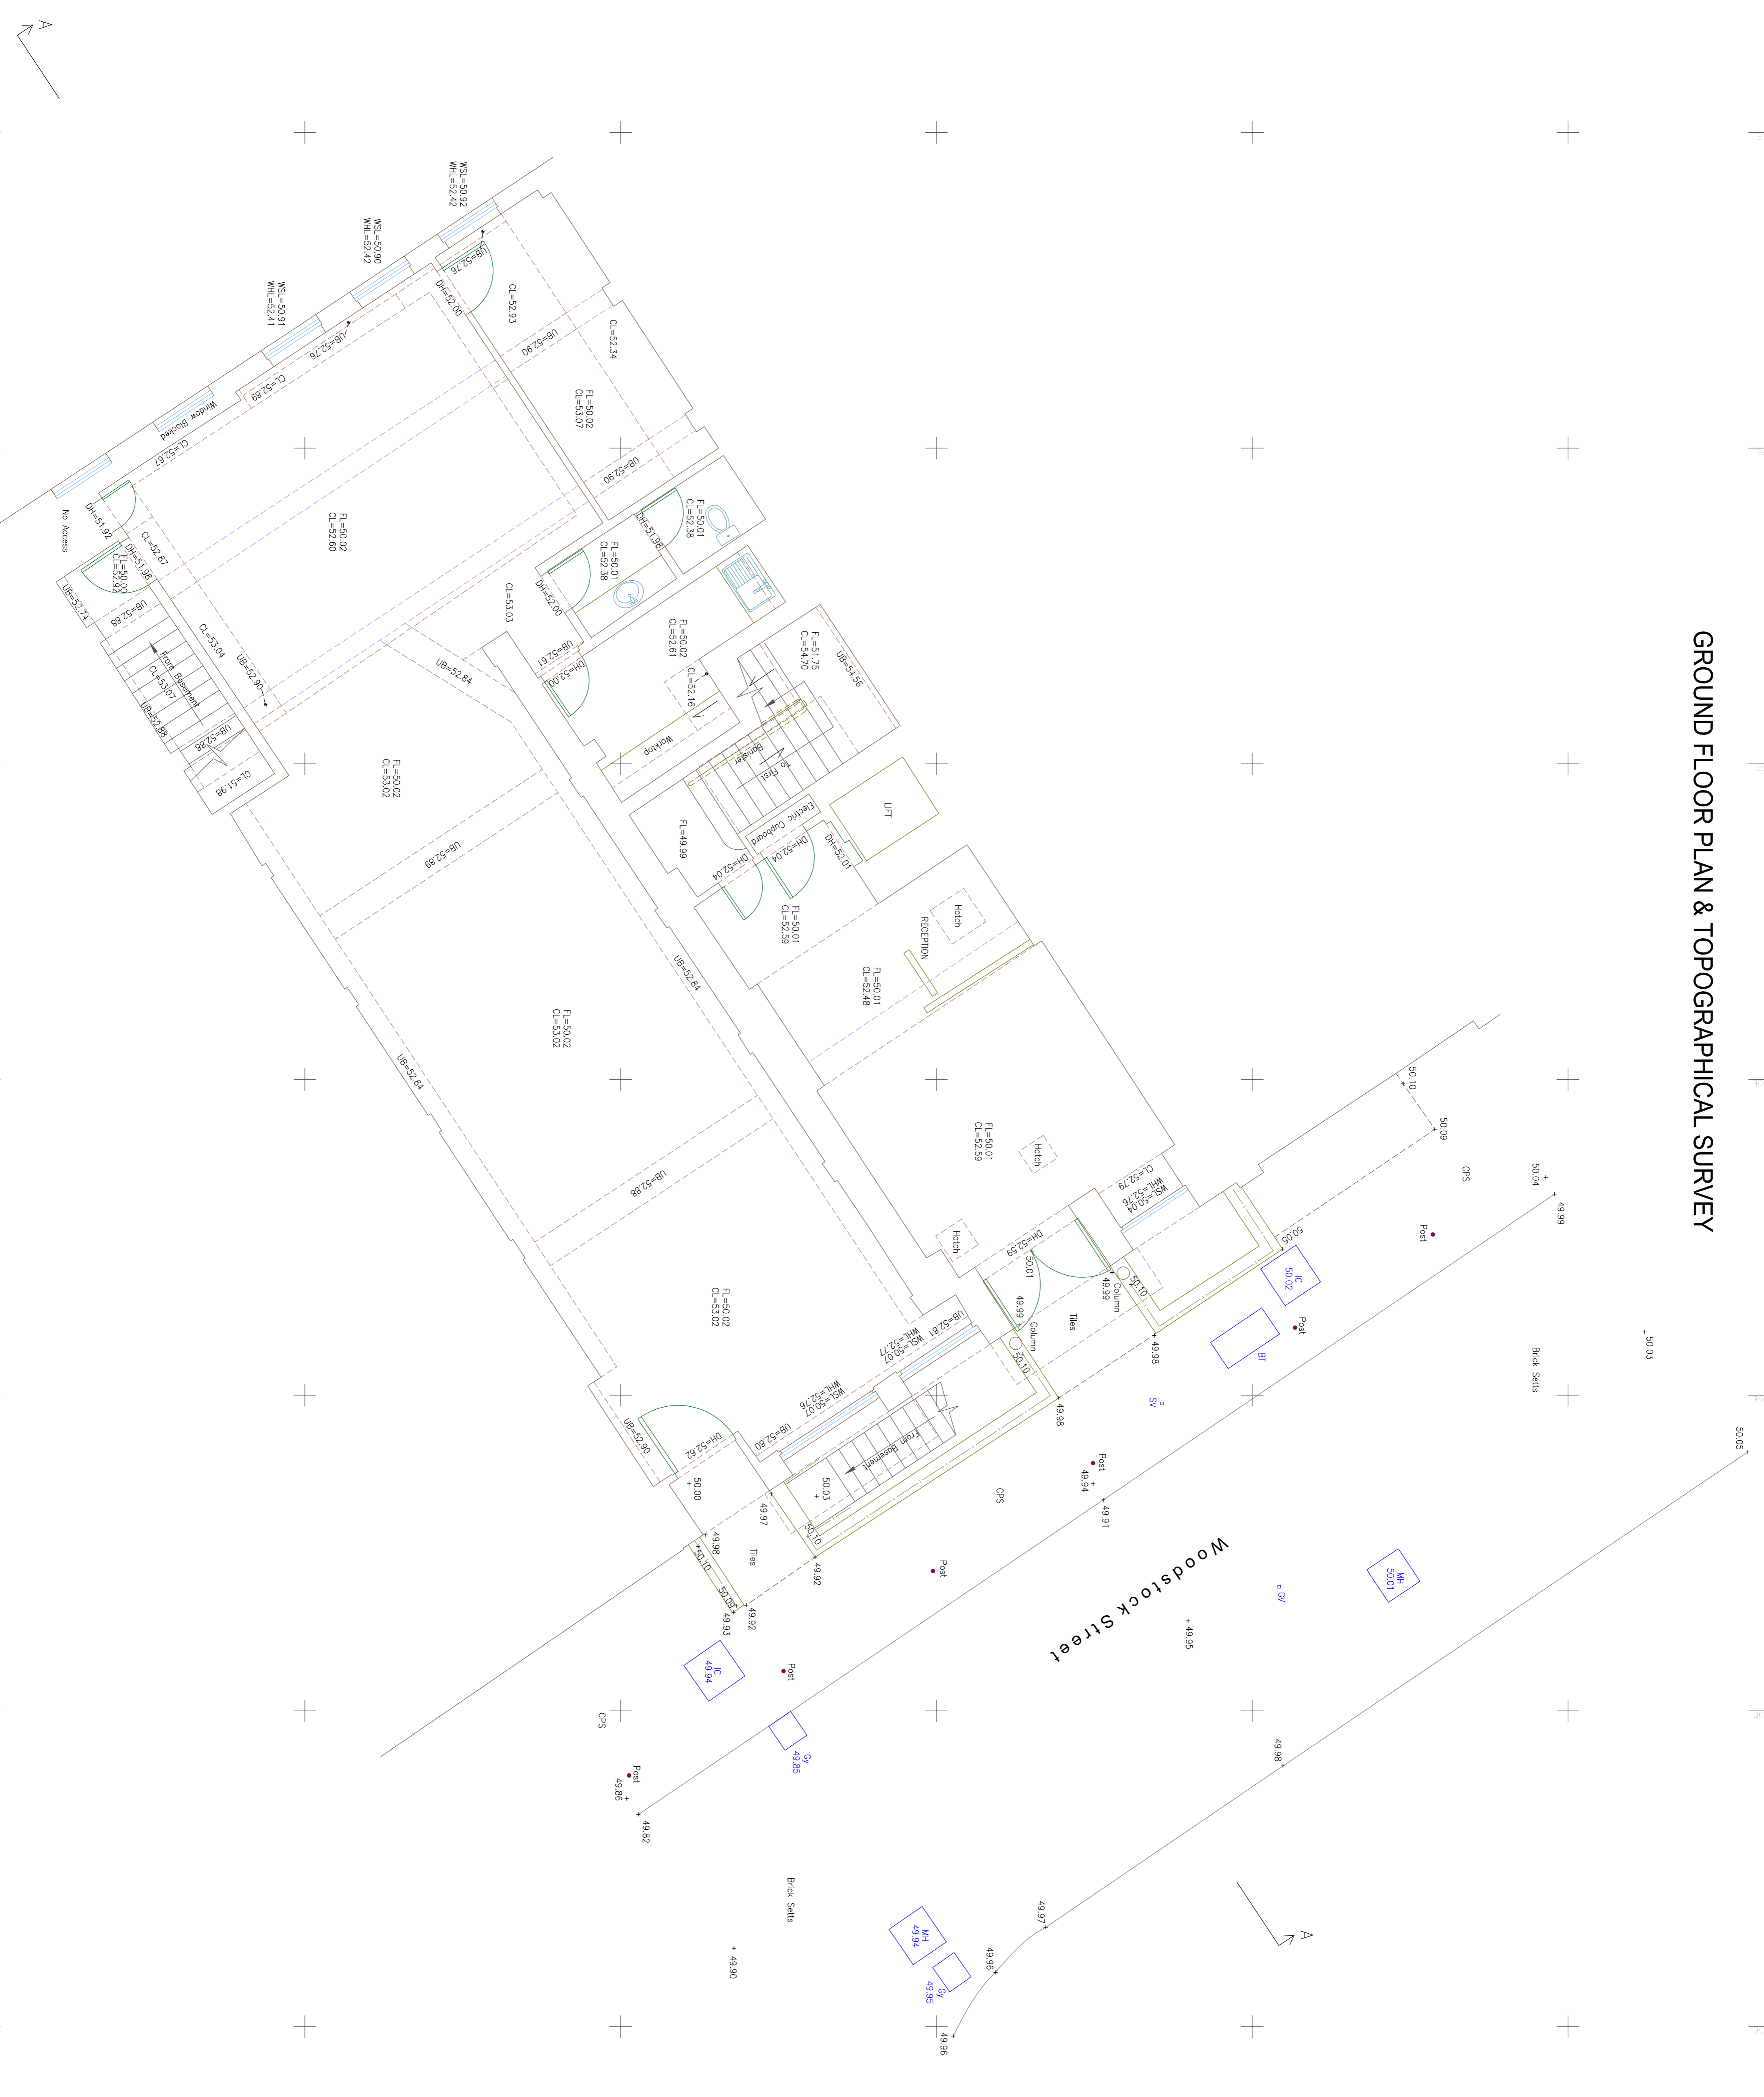


# GROUND FLOOR PLAN & TOPOGRAPHICAL SURVEY

## Important Information:

All information contained in this drawing (including digital data) should be checked and verified prior to any fabrication or construction.

--- Assumed Beam Detail due to limited visibility

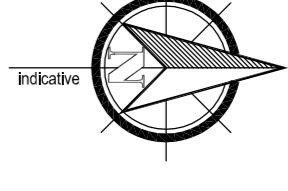

Survey Grid: Local Arbitrary

Levelling: Based on Ground Floor Level in Foyer

Drawing Title:  
Ground Floor Plan  
& Topographical Survey

Site Address:  
18-20 Woodstock Street  
London



Client:

Surveyor	ANF	Drawn By	WB	Verified By	ANF	Date	03.01.14
CM/NP:	CM/1585-G	Rev:					

Scale: 1:50 @ A1 Date: December 2013



Cadmap Ltd  
67 Marlowey Drive  
Forest Waking  
Surrey, GU24 1HF  
T: 01483 429865  
W: www.cadmap.co.uk