


KNIGHTSBRIDGE

PAVEMENT

PARK CLOSE

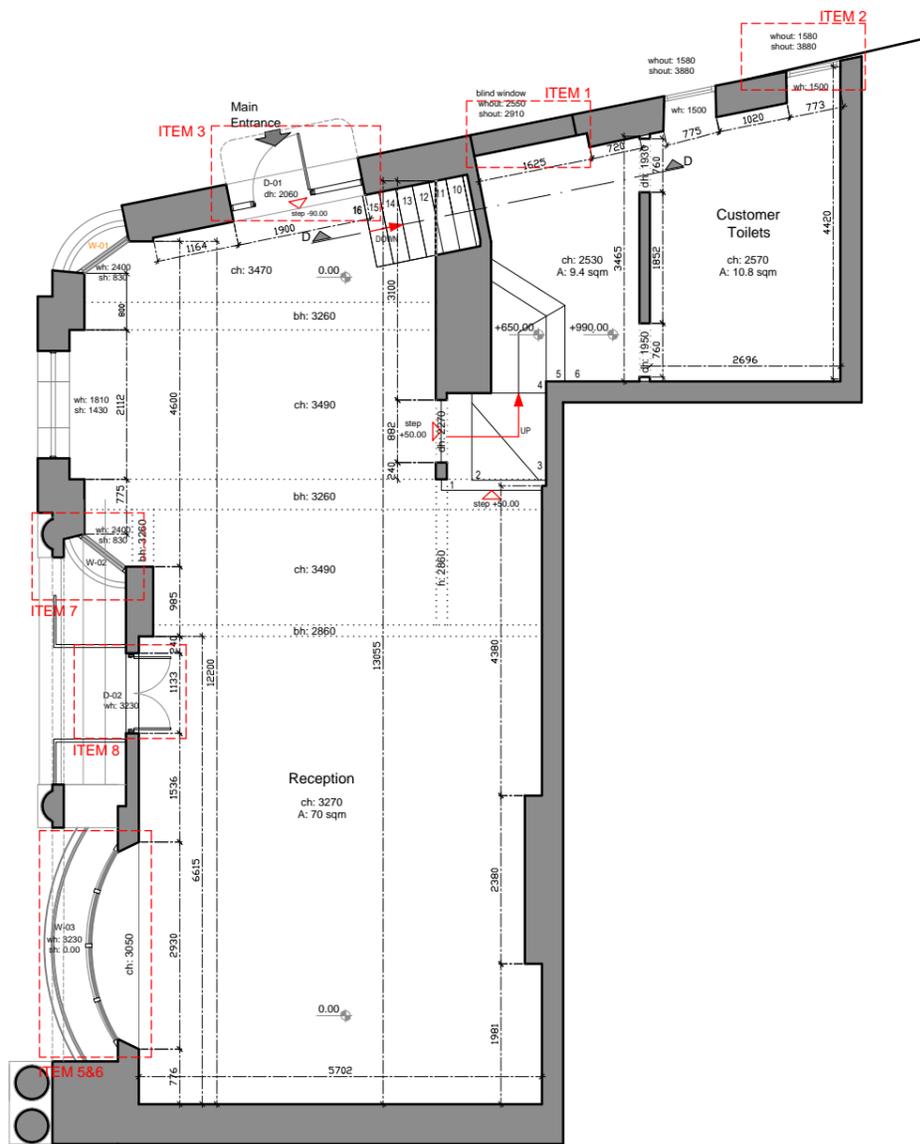

**EXISTING GROUND FLOOR PLAN**  
Scale 1:100@A3



**EXISTING FRONT ELEVATION AA - KNIGHTSBRIDGE**  
Scale 1:100@A3

IMAGES OF THE EXISTING EXTERNAL FRONT AND SIDE ELEVATIONS - KNIGHTSBRIDGE



- GENERAL NOTES**
- Contractor must verify all dimensions on site before commencing any work or shop drawings.
  - If this drawing exceeds the quantities taken in any way the Architects are to be informed before the work is initiated.
  - Only figured dimensions are to be taken from this drawing. Do not scale off this drawing. For dimensions that are not given, the Architects' agreement/clarification is to be sought before any work commences.
  - Design and drawing content is subject to Site Survey, Structural Survey, Site Investigations, Planning and Statutory Requirements and Approvals.
  - All workmanship and materials to be installed and carried out in accordance with latest and relevant British Standards as a minimum acceptable standard.
  - The Contractor is to check this drawing for errors and/or inconsistencies and inform the Architect immediately or seek clarification where there is any doubt as to the meaning and interpretation of the information provided.
  - Any discrepancy on the drawings General Arrangements, detail drawings or other contractor immediately to contact architect before any job started.

**KEY TO WALL TYPES**

- Existing Walls
- Proposed Partitions

Rev	Desc	By	Date	Ch
-	Preliminary	LL	Jan 2018	FN

**SIRAF ASSOCIATES Ltd**  
Chartered Architects  
Practice

**RIBA**

Edgo House 186, Sloane Street  
London  
SW1X 9QR

Tel +44 (0) 208 617 3944  
Mob +44 (0) 77 4899 1942  
E-mail: info@sirafassociates.com

Project:  
**116a KNIGHTSBRIDGE**  
LONDON, SW1X 7PJ

Title:  
**GROUND FLOOR ALTERATIONS**  
EXISTING PLAN AND ELEVATION AA

Scale: Scale 1:100@A3	Drawn by: LL
Date: Jan 2018	Checked by: FN
Drawing No: 18-116AK-GF100	Rev: -

0m 1m 2m 3m 4m

Scale 1:100@A1