



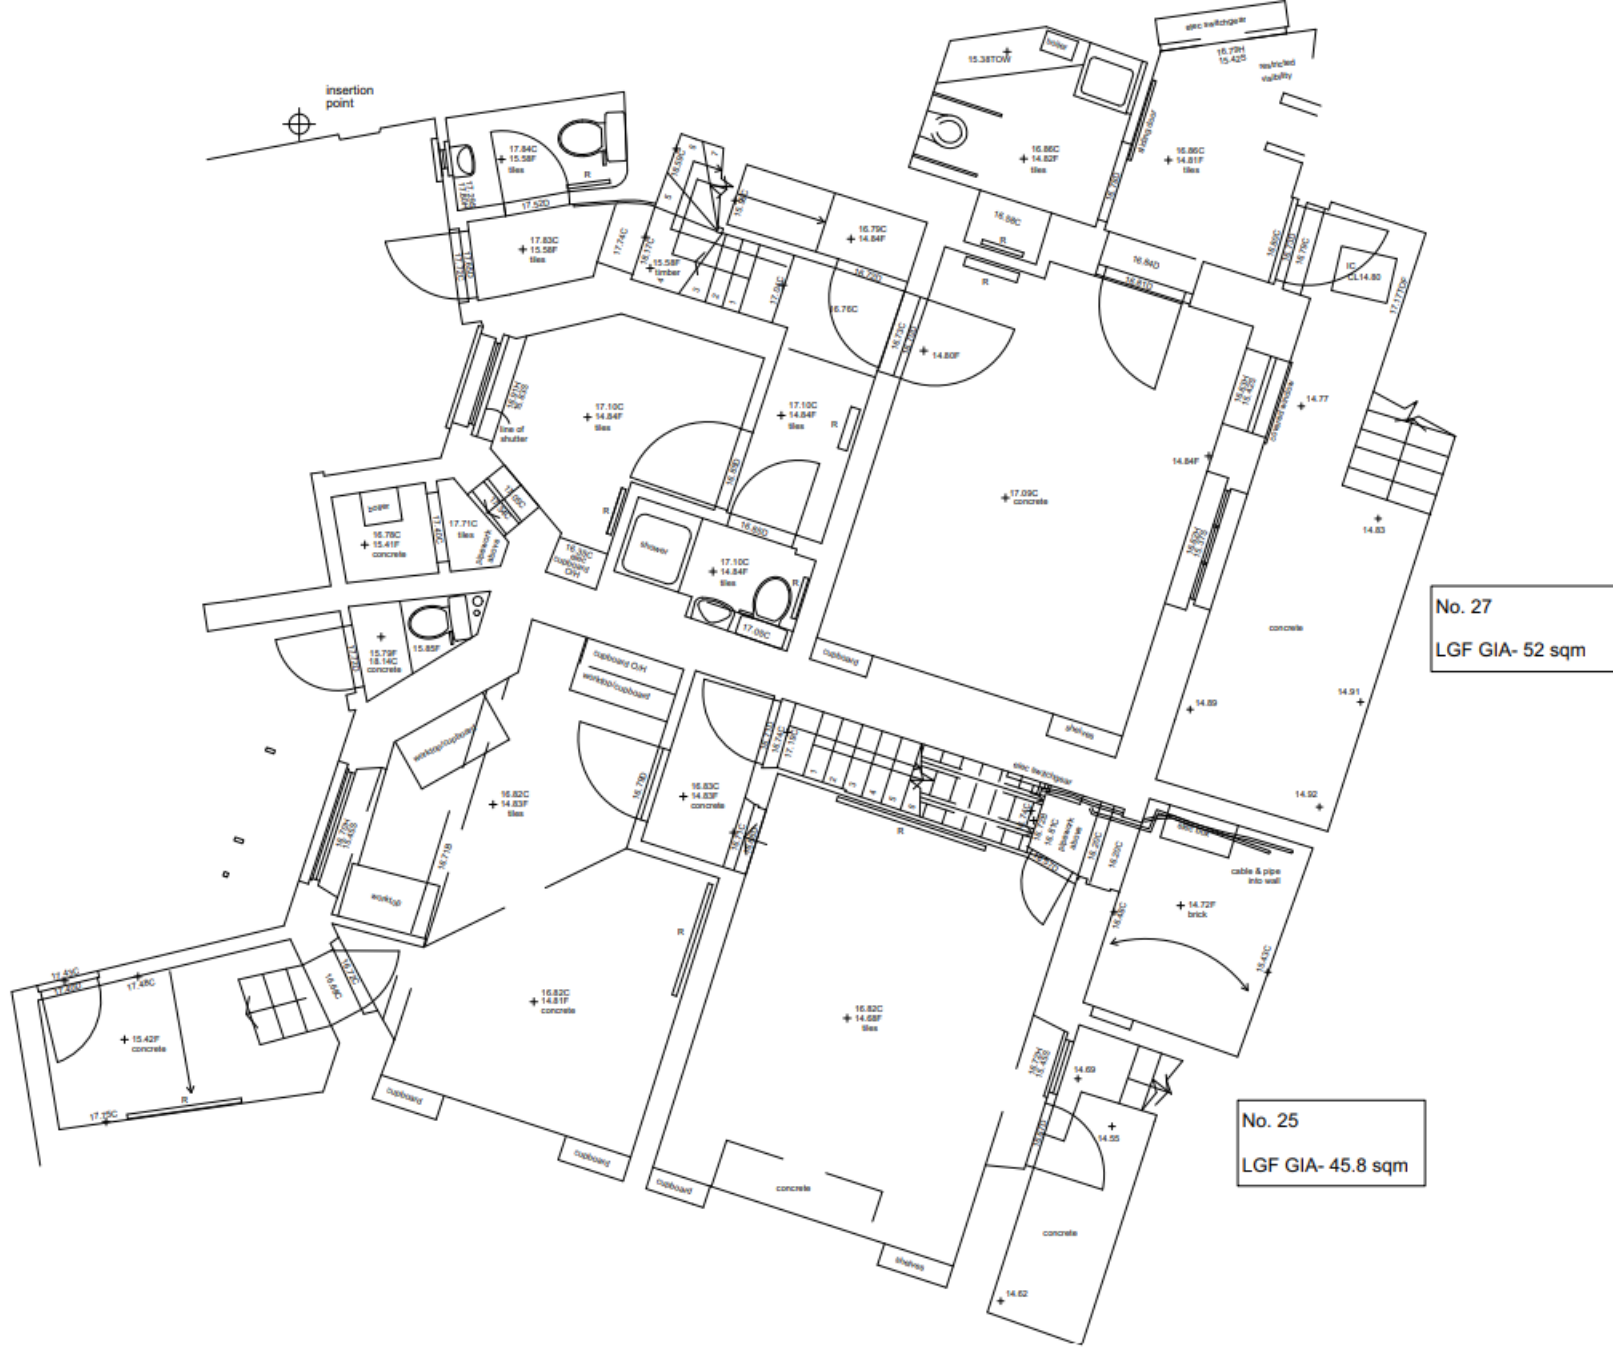




ELEVATION 2

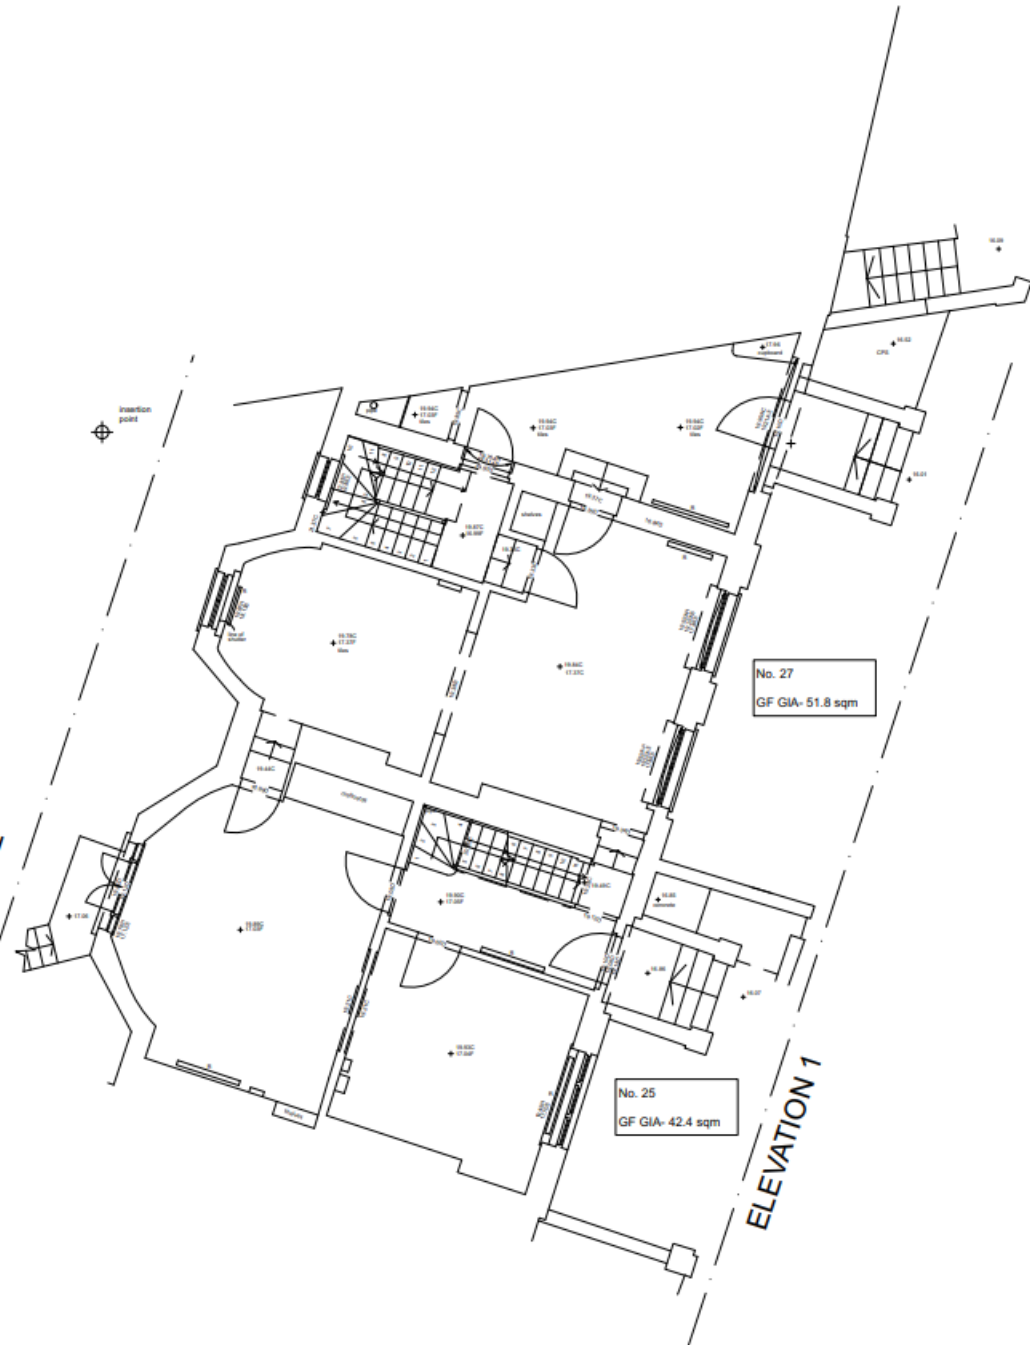

No. 27
GF GIA- 51.8 sqm

No. 25
GF GIA- 42.4 sqm

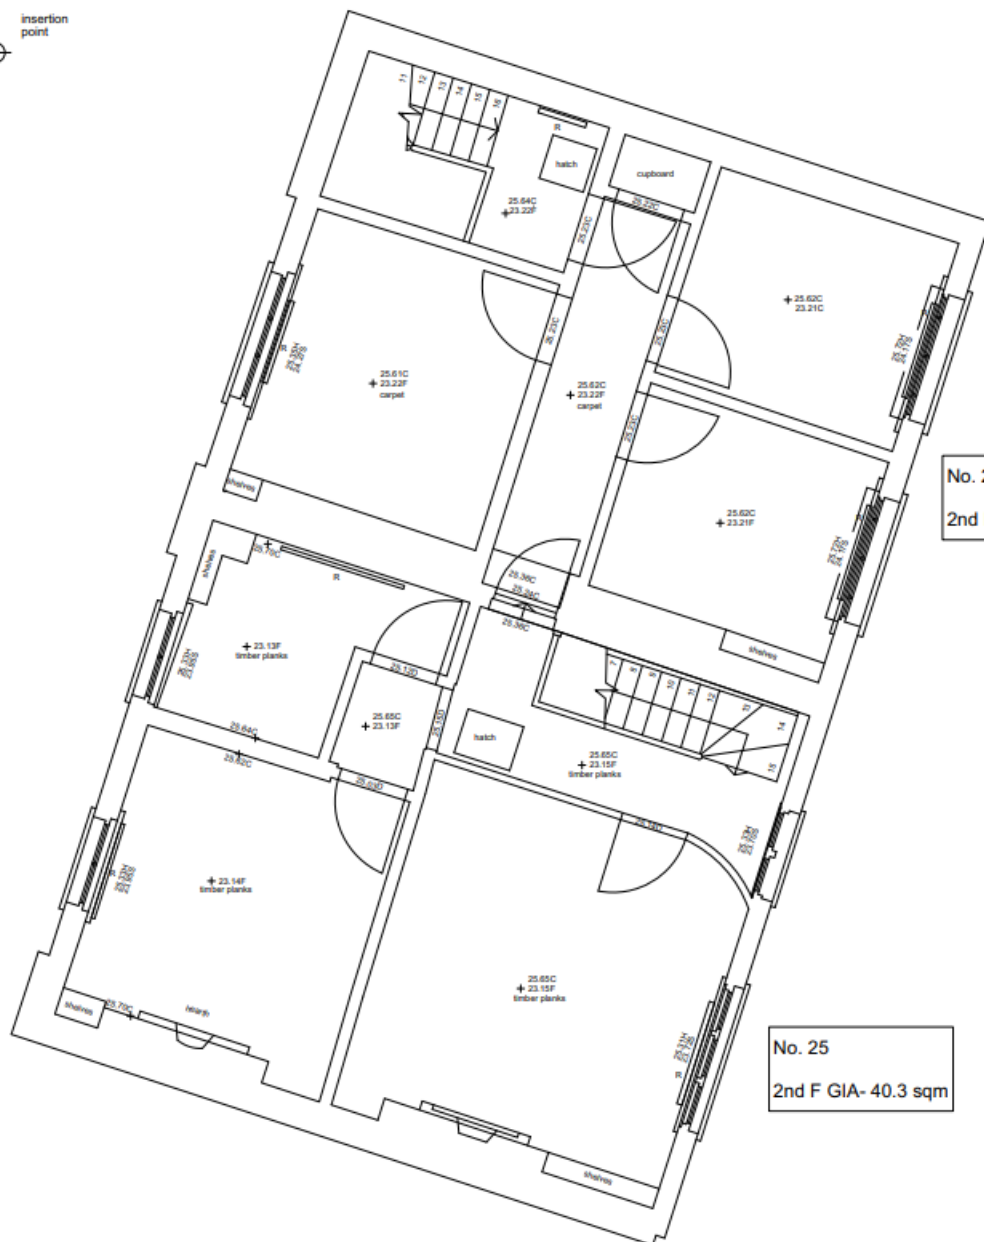

No. 27

2nd F GIA- 35.3 sqm

No. 25

2nd F GIA- 40.3 sqm