


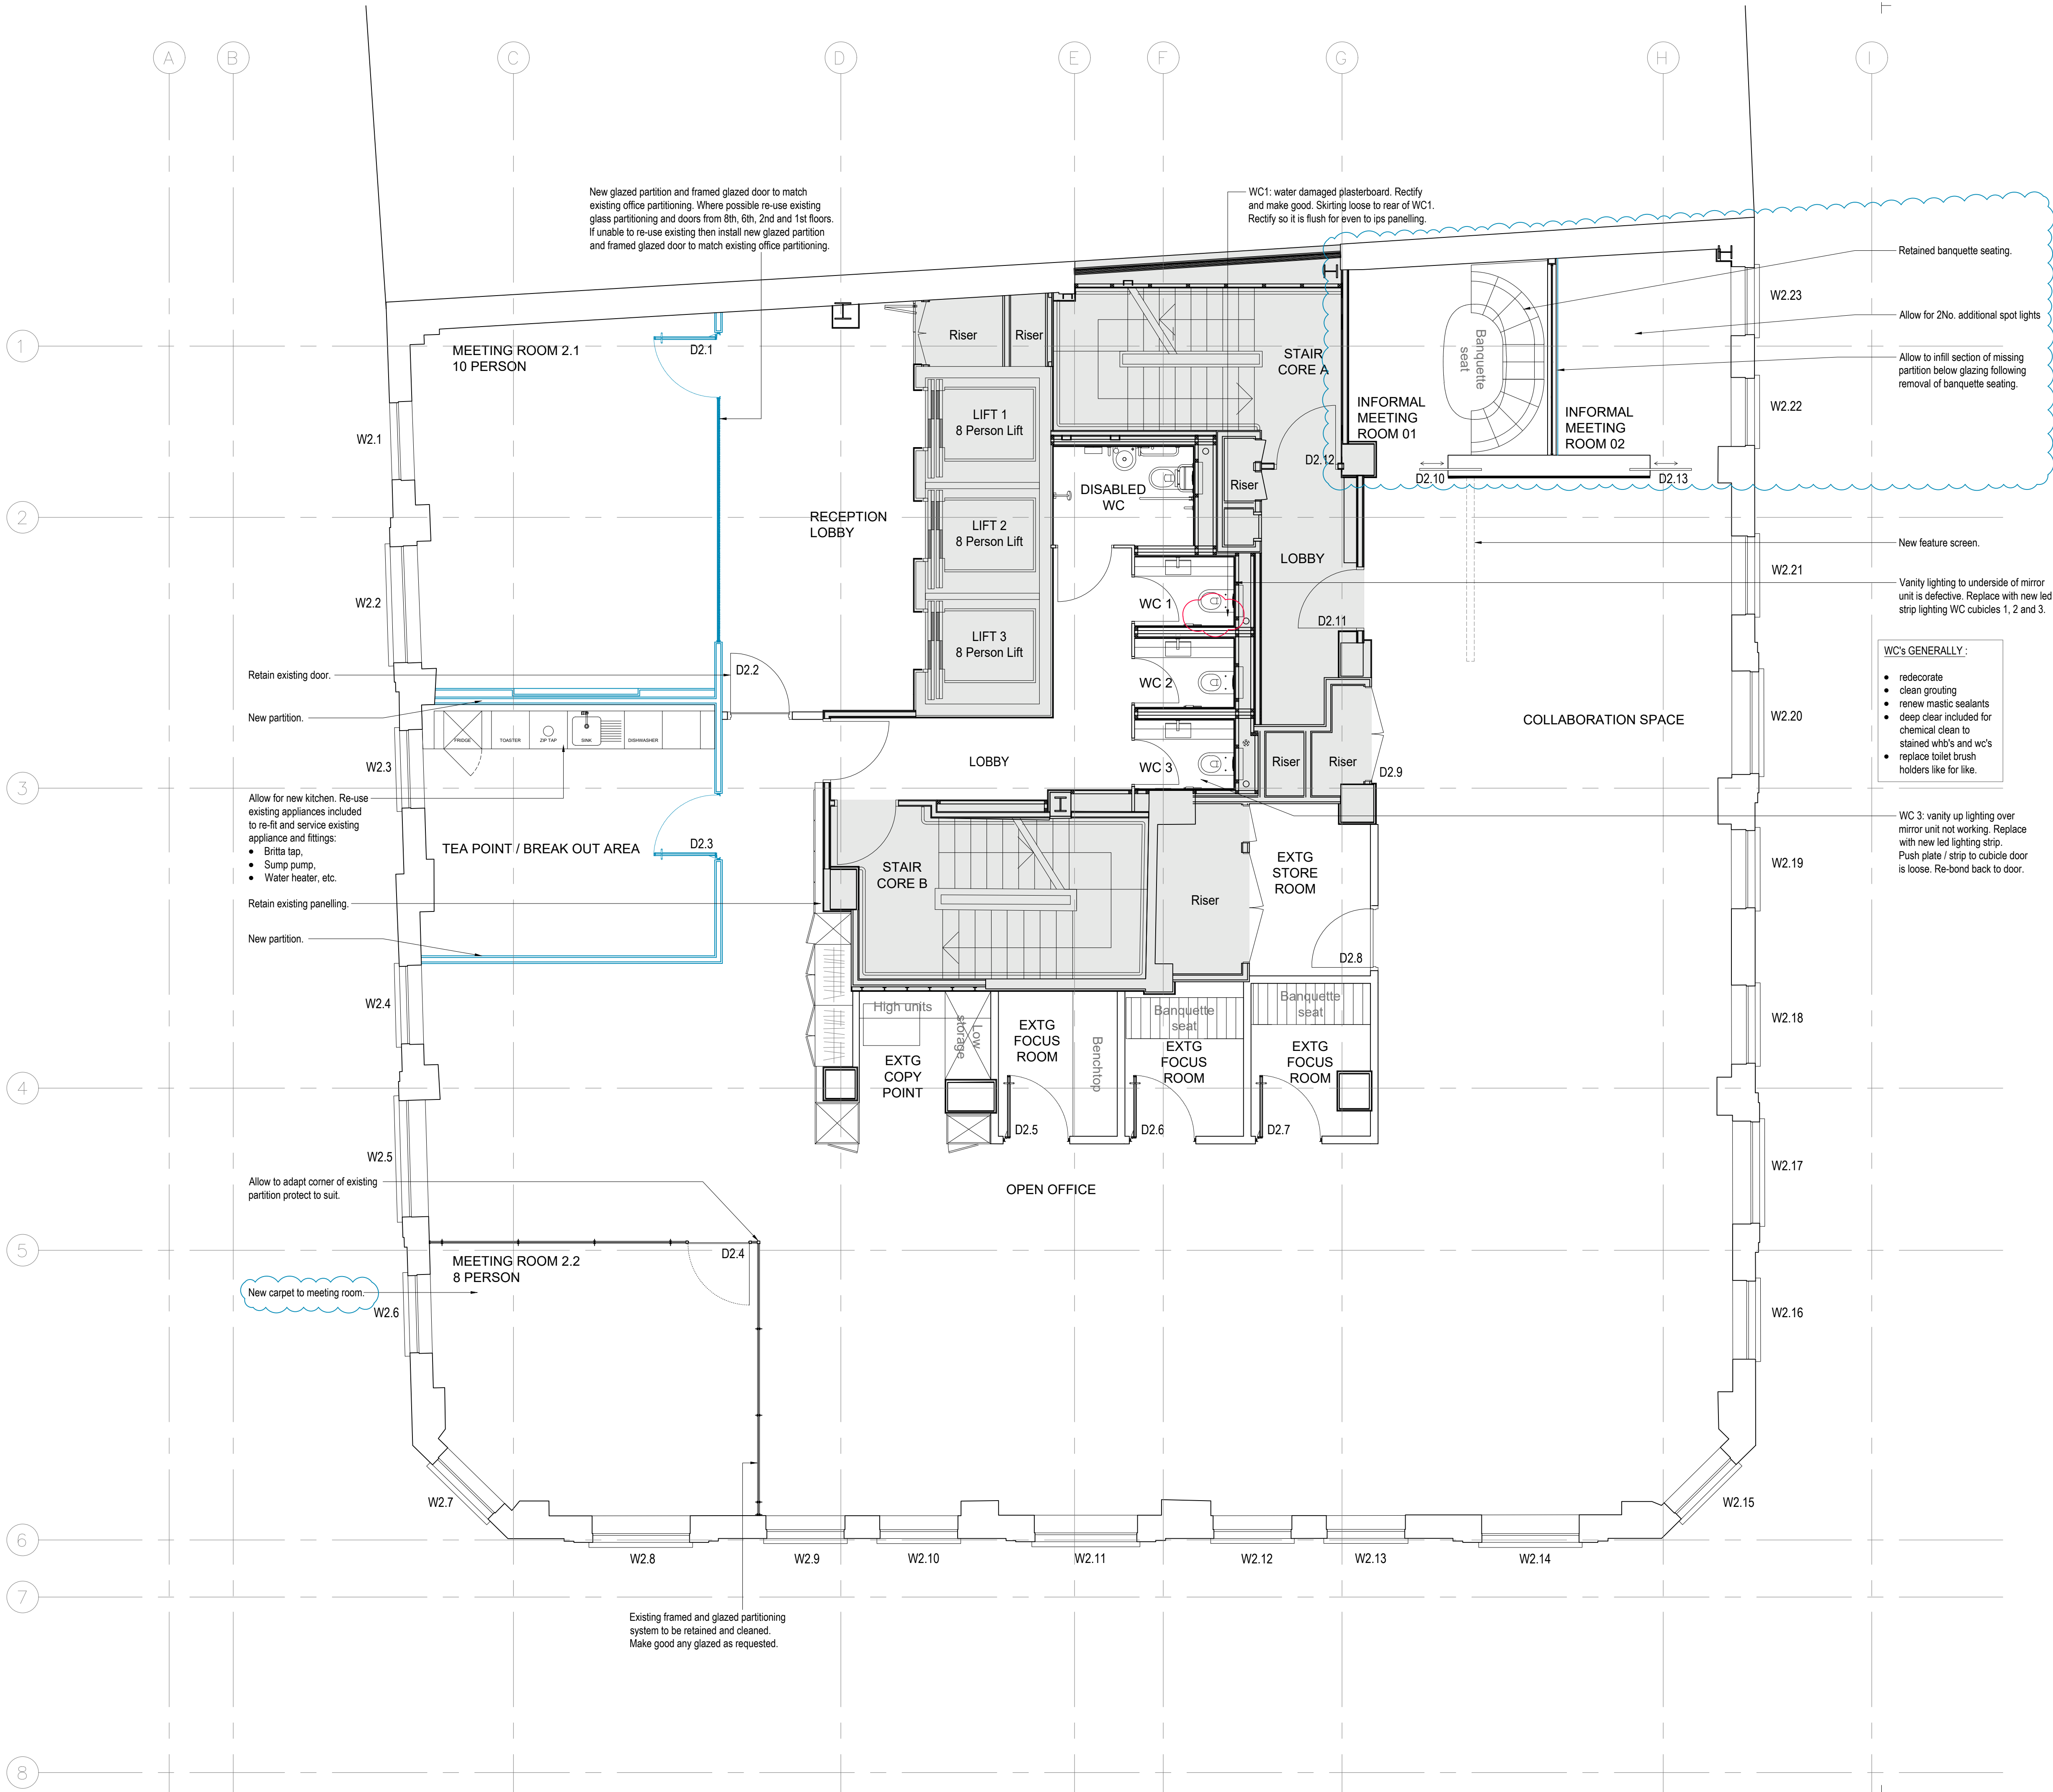

NOTES

All dimensions and levels to be checked by Contractor and verified before work commences; dimensions must be not be scaled from this drawing.
Copyright reserved.

EC REGULATIONS - GENERAL NOTE

Where reference is made on this drawing to British Standards or to specific manufacturer's products or trade names, this is intended to indicate a minimum acceptable standard of performance etc. Materials and components conforming to an equivalent European Standard may be used and supporting evidence shall be produced at tender stage to confirm fitness for purpose.

- AREA AMENDED
- EXISTING PARTITION AND SLIDING DOOR ENTRANCES SHOWN RETAINED.
 - 1 No. BANQUETTE SEATING RETAINED.
 - SECTION OF PARTITIONING INFILL BELOW GLAZED PARTITION FOLLOWING REMOVAL OF EXISTING BANQUETTE.
 - ADDITION OF 2No SPOTLIGHTS TO INFORMAL MEETING ROOM 2.

WC's GENERALLY :

- redecorate
- clean grouting
- renew mastic sealants
- deep clear included for chemical clean to stained whb's and wc's
- replace toilet brush holders like for like.

WC 3: vanity up lighting over mirror unit not working. Replace with new led lighting strip. Push plate / strip to cubicle door is loose. Re-bond back to door.

C1	CONSTRUCTION ISSUE	15.03.2022
T2	TENDER ISSUE	24.11.2021
T1	TENDER ISSUE	03.11.2021
A	PRELIMINARY ISSUE	25.10.2021
-	PRELIMINARY ISSUE	21.10.2021

revisions

CONSTRUCTION ISSUE

UK SPAN PROPERTY Ltd

One Bridge Wharf
156 Caledonian Road, London N1 9UJ
Tel: 020 7636 6833

Threeways House
36 George Street, Oxford OX1 2BJ
Tel: 01865 260 600

e-mail: info@tmd-surveyors.co.uk
www.tmd-surveyors.co.uk

Project

ONE SOUTHAMPTON STREET
LONDON
WC2R 0LR

Drawing:

PROPOSED
SECOND FLOOR
GENERAL ARRANGEMENT PLAN

Scale: 1:50 @ A1	Date: SEPTEMBER 2021	Drawn By: EP	Checked By: DMC / MCD
Job No. 10668	Dwg No. 2-03	Rev'n C1	A T1 T2 · · ·

