


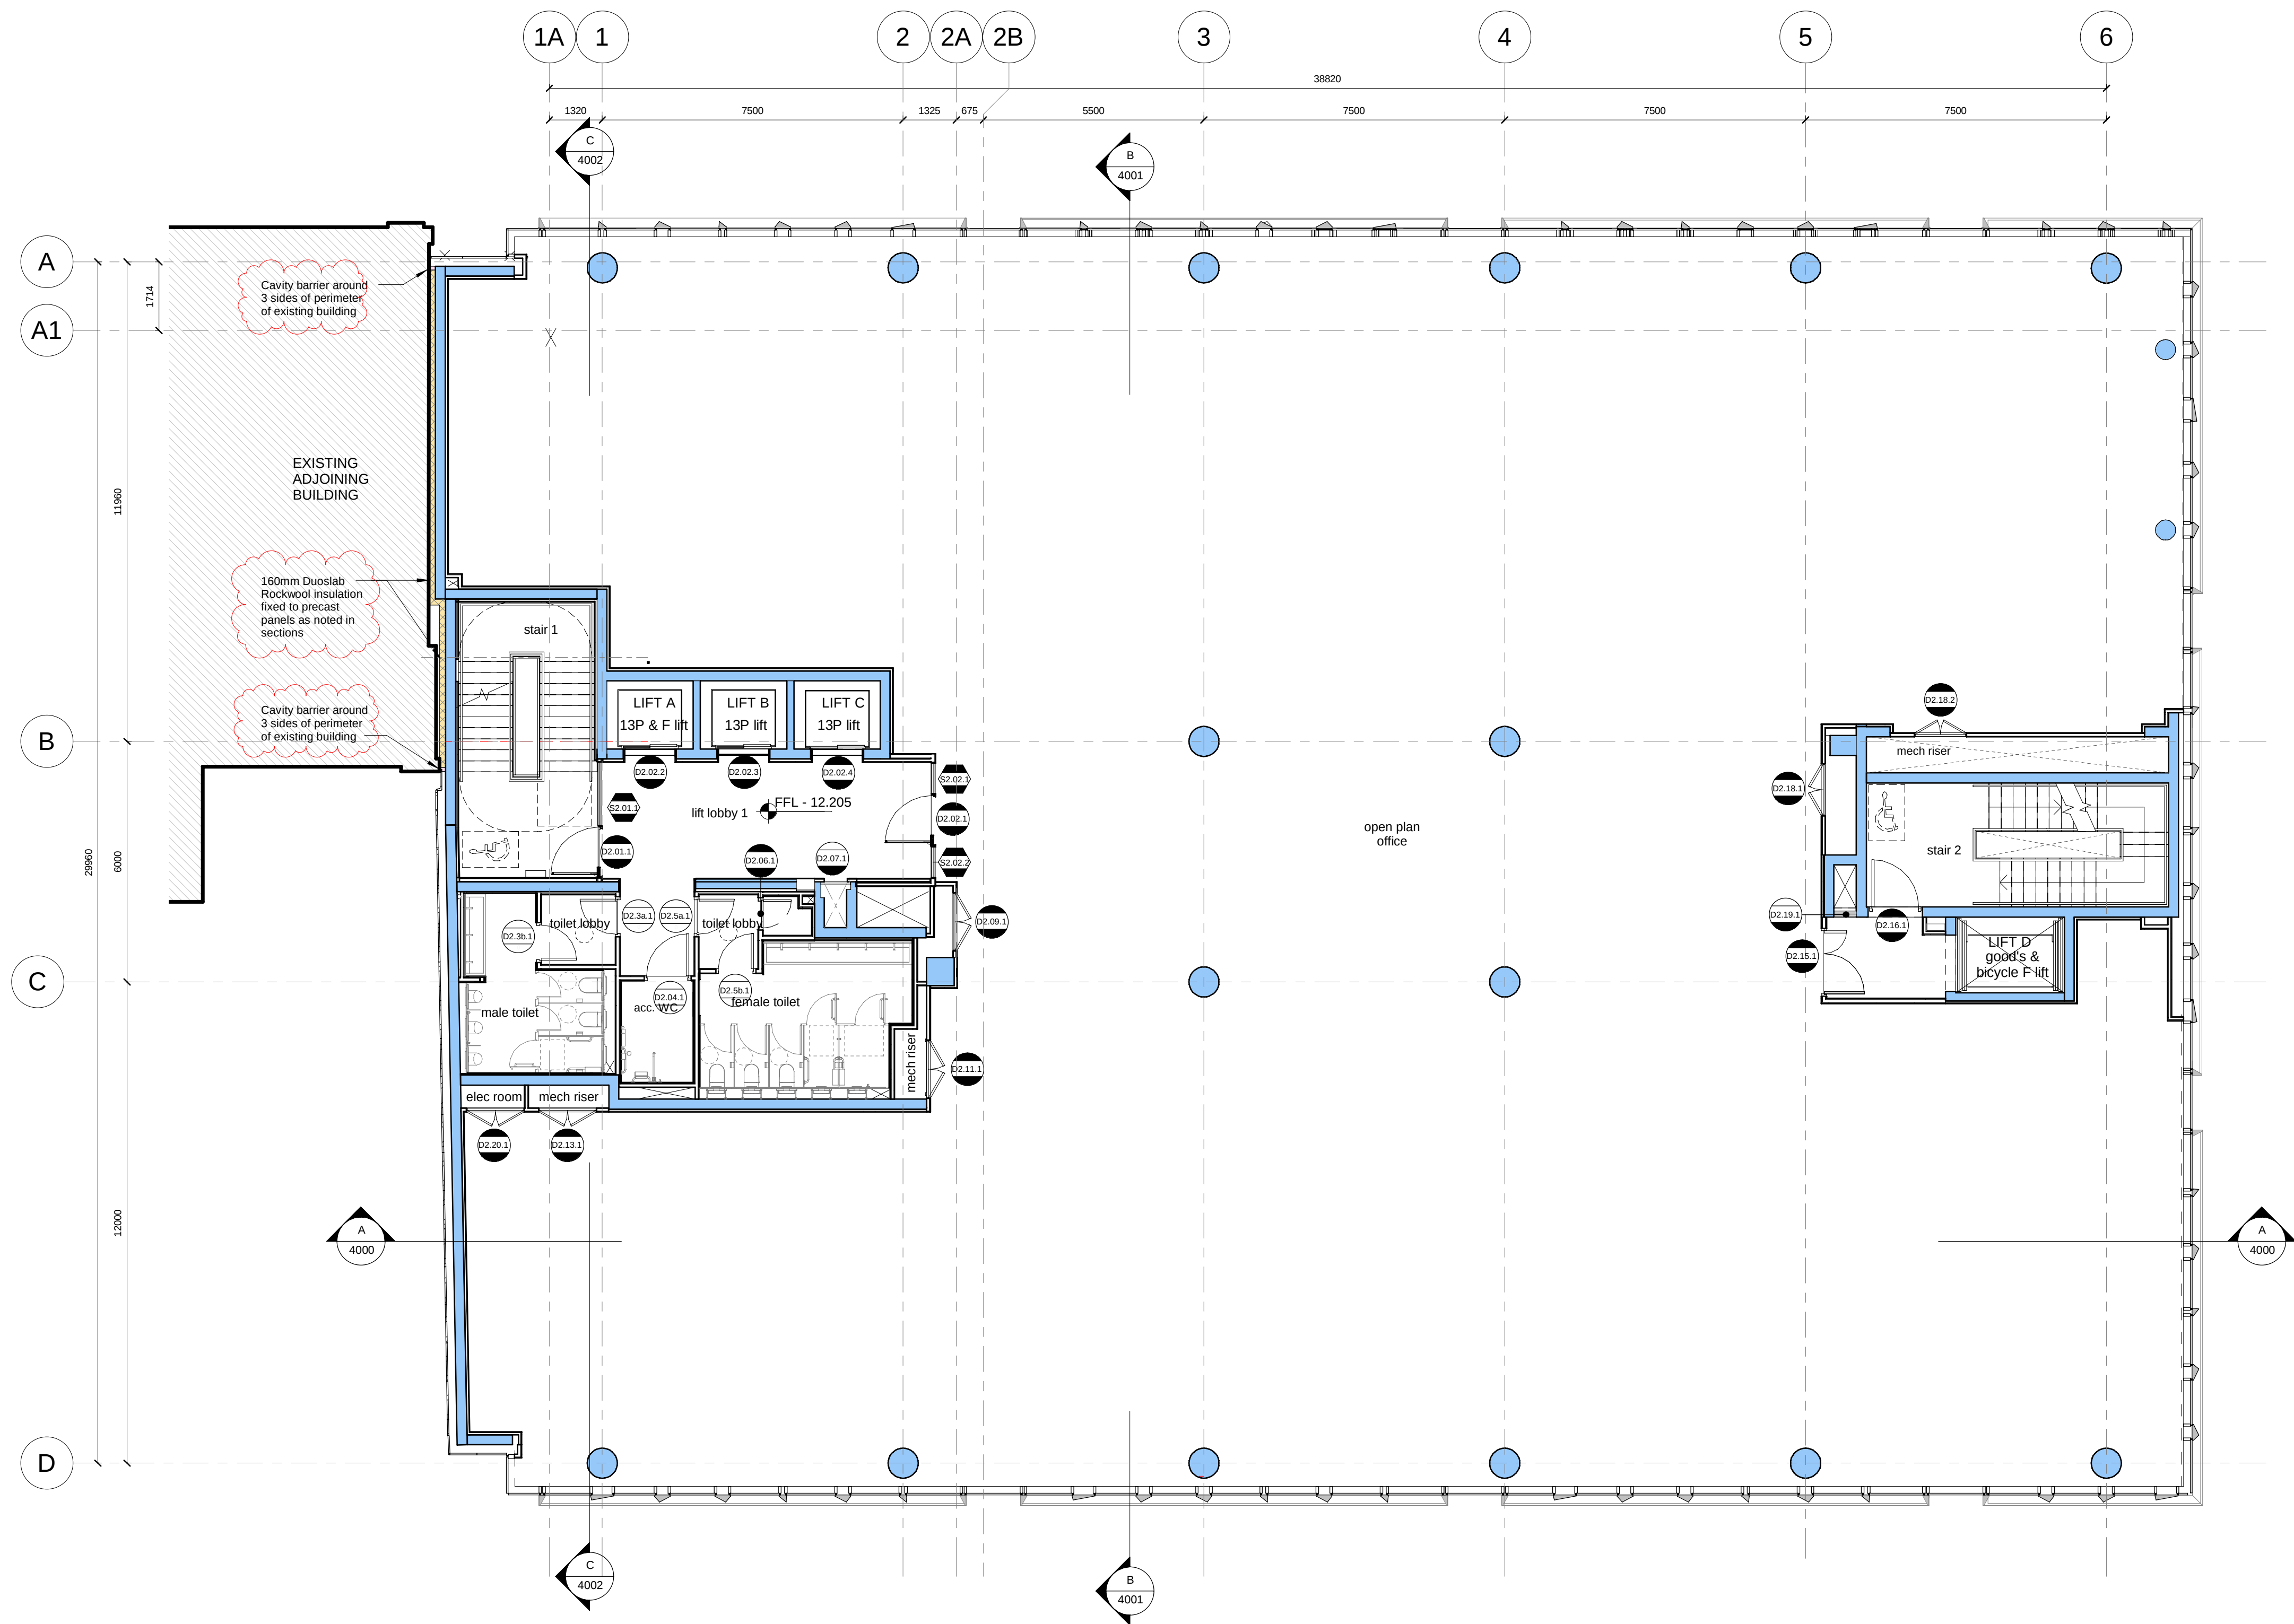

NOTES:

Check all dimensions on site. Do not rely on scaled dimensions. This drawing must be read in conjunction with all relevant contract documents.

This drawing is the property of Michael Collins Associates Ltd. (trading as MCA Architects). The drawing shall not be copied, reproduced or otherwise used without the consent of Michael Collins Associates Ltd.

Legend:

--- site boundary



Door with no fire rating requirement



Fire resisting door(set) achieving 30 minutes integrity(I) rating in accordance with BS 476: Part 8/22 (and fitted with an appropriate self closer and a cold smoke seal which limits the leakage past the head and jambs of the door to 3m³/m²hour when subject to a pressure of 25 Pascals.



Fire resisting door(set) achieving 60 minutes integrity(I) rating in accordance with BS 476: Part 8/22 (and fitted with an appropriate self closer and a cold smoke seal which limits the leakage past the head and jambs of the door to 3m³/m²hour when subject to a pressure of 25 Pascals.



Screen with no fire rating requirement



Fire rated glazing/screen achieving 30 minute fire resistant rating (integrity & insulation) to a height of 2.0m above floor level in accordance with BS 476: Part 8/ 20-24 and relevant provisions of Section 7 of BS 9999: 2017



Fire rated glazing/screen achieving 60 minute fire resistant rating (integrity & insulation) to a height of 2.0m above floor level in accordance with BS 476: Part 8/ 20-24 and relevant provisions of Section 7 of BS 9999: 2017

structural frame by structural engineer

Rev	Date	Description	Dm	Chkd
C01	31/05/22	Issued for Construction	MD	SS
C02	17/11/22	Implications of FSC Grant, Western boundary, thermal line, and annotation clarifications	MD	SS
C03	26/07/23	Core 1 Lobby door moved for CFD	MD	SS
C04	30/11/23	Internal doors adjusted graphically	BW	MD
C05	11/12/23	Revision to core 02 as clouded	BW	MD
C06	15/05/24	Note from sections added to plans. Gate location.	BW	BW

MCA
ARCHITECTS

Architecture • Interior Design • Masterplanning • Project Management

4 Harcourt Wharf,
Asgard Road,
Dublin 2, Ireland.

+353 1 6769916
info@mca.ie
www.mca.ie

Client: ALSTEAD SECURITIES LTD

Project: 157/164 TOWNSEND STREET

Drawing: PROPOSED SECOND FLOOR - GENERAL ARRANGEMENT PLAN

Stage: CONSTRUCTION

Status: FOR CONSTRUCTION

Drawing Number: TSH-MCA-00-02-DR-A-3200

Job No:

2022.09

Sheet: A1

Scale: 1 : 100

Status Code: A

REVISION:

C06