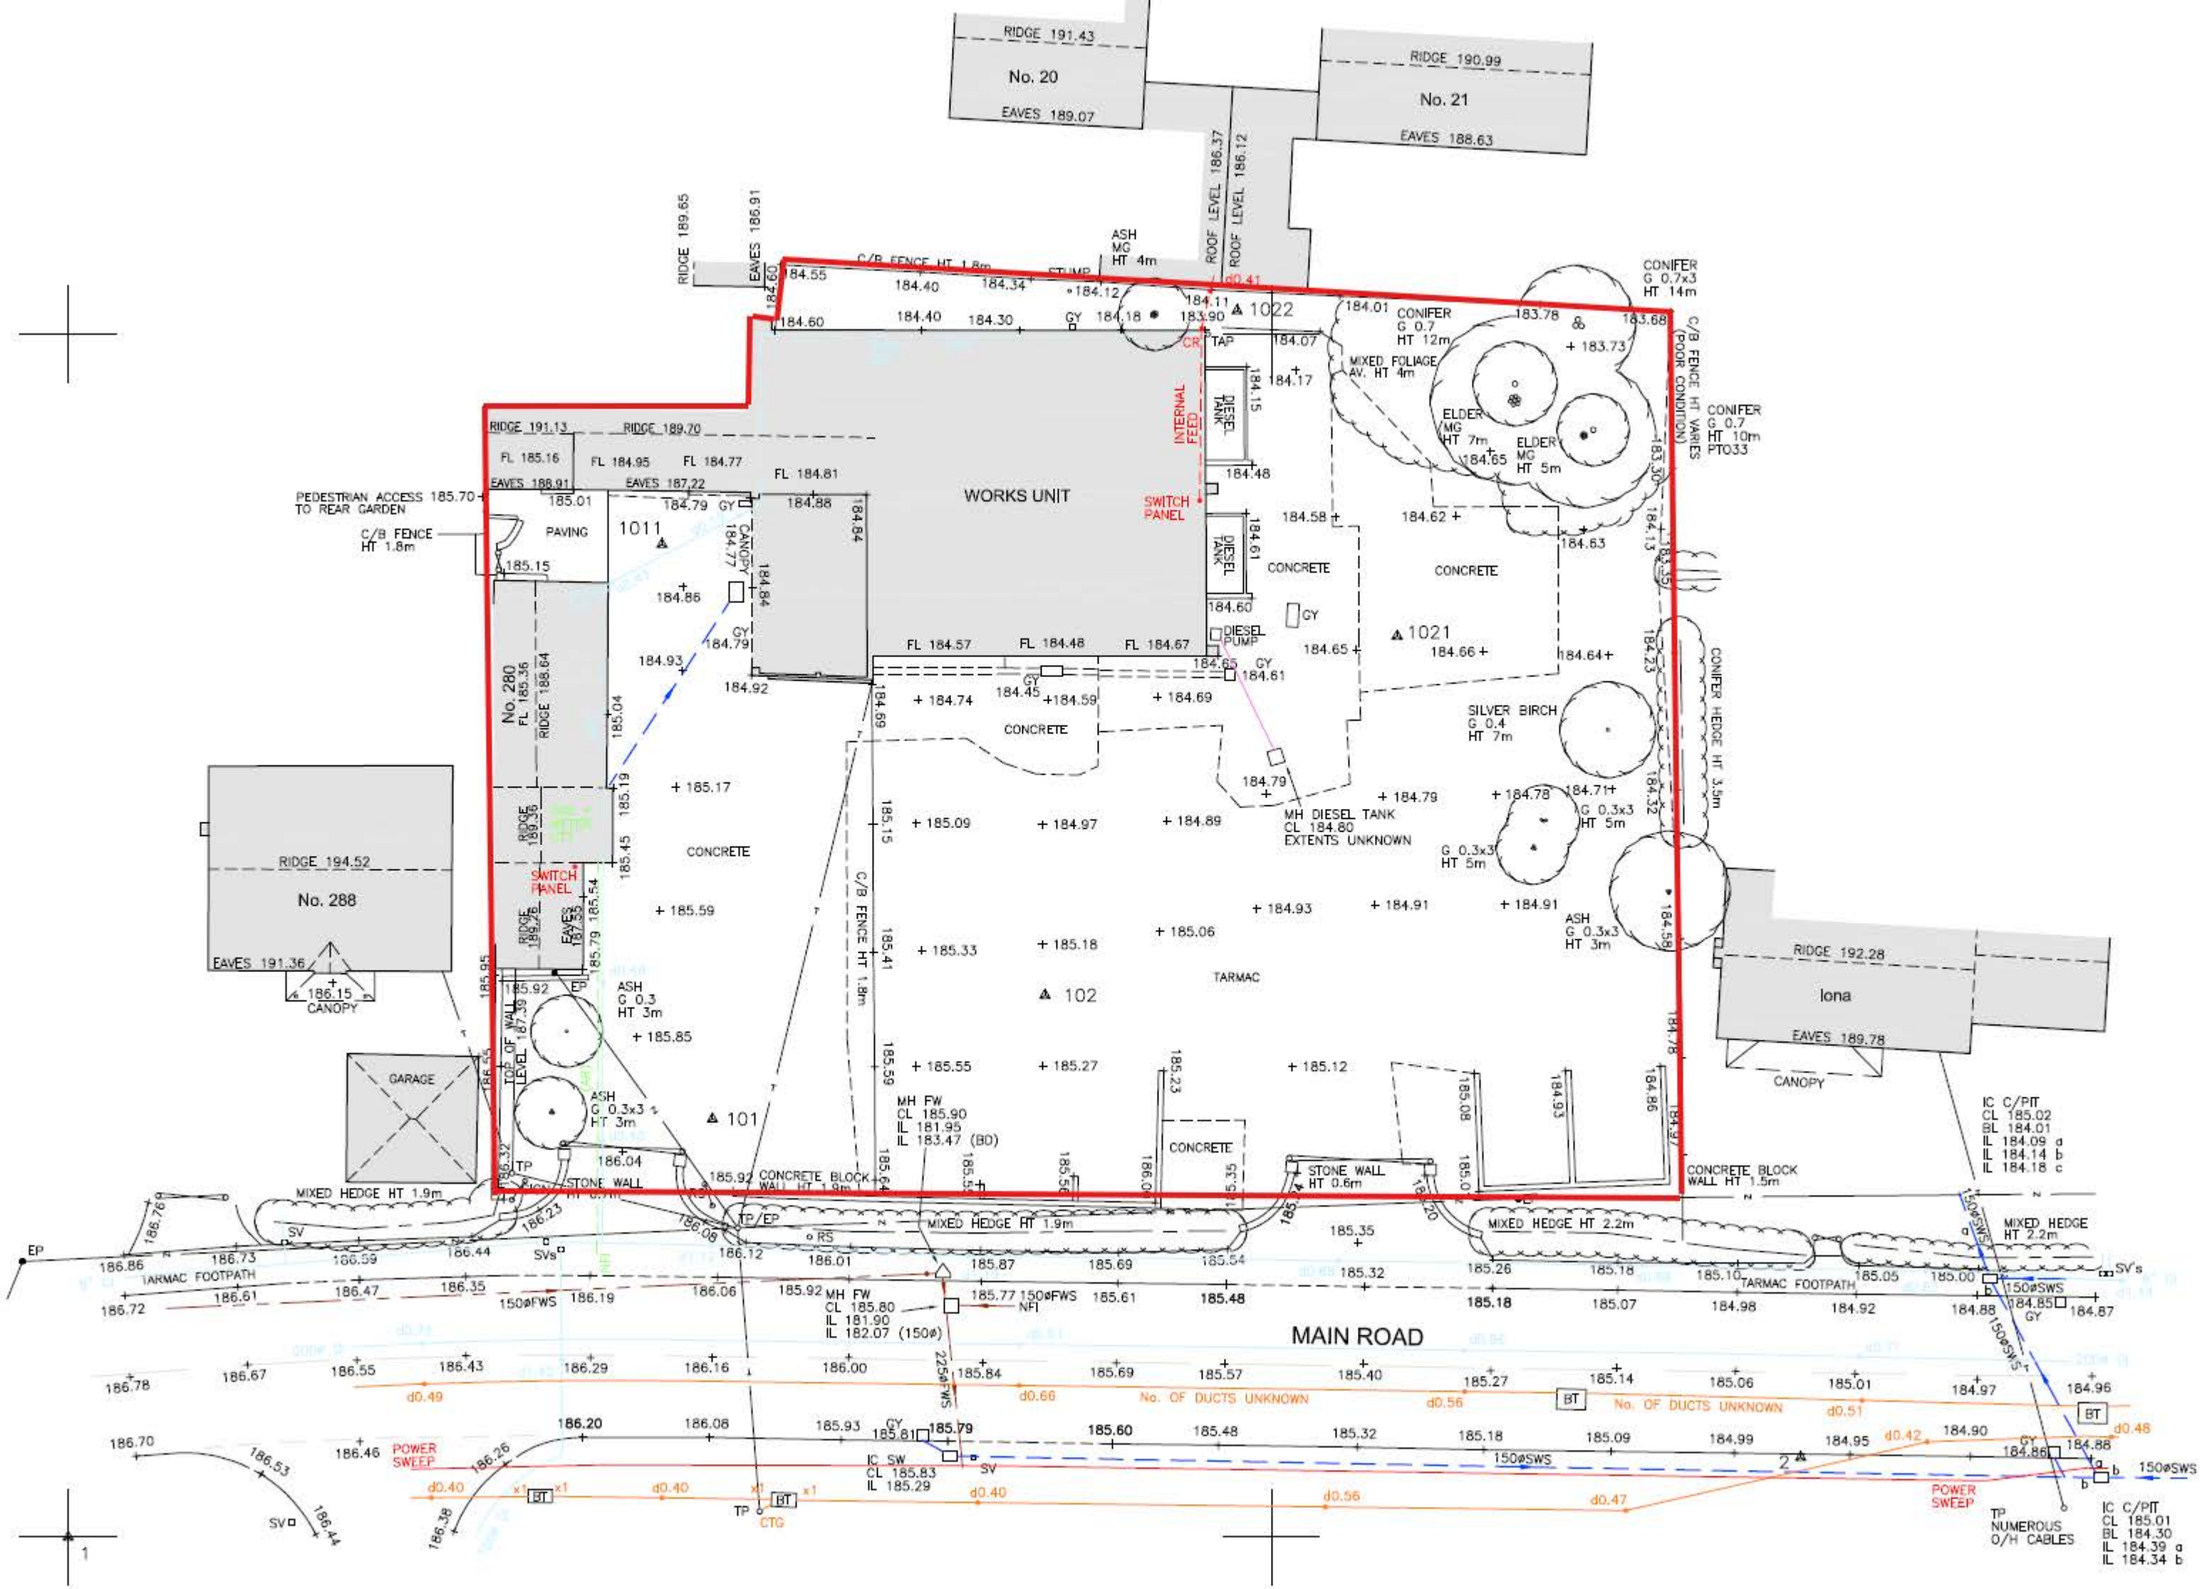
No. 20
RIDGE 191.43
EAVES 189.07
No. 21
RIDGE 190.99
EAVES 188.63
WORKS UNIT
CONCRETE
TARMAC
MAIN ROAD
No. 288
RIDGE 194.52
EAVES 191.36
GARAGE
No. 280
Iona
RIDGE 192.28
EAVES 189.78
PEDESTRIAN ACCESS TO REAR GARDEN
C/B FENCE HT 1.8m
PAVING
SWITCH PANEL
INTERNAL FEED
DIESEL TANK
DIESEL PUMP
MIXED HEDGE HT 1.9m
MIXED HEDGE HT 2.2m
STONE WALL HT 0.6m
CONCRETE BLOCK WALL HT 1.5m
TARMAC FOOTPATH
POWER SWEEP
No. OF DUCTS UNKNOWN
MH DIESEL TANK CL 184.80 EXTENTS UNKNOWN
MH FW CL 185.90 IL 181.95 IL 183.47 (BD)
MH FW CL 185.80 IL 181.90 IL 182.07 (150ø)
IC SW CL 185.83 IL 185.29
IC C/PIT CL 185.02 BL 184.01 IL 184.09 d IL 184.14 b IL 184.18 c
IC C/PIT CL 185.01 BL 184.30 IL 184.39 a IL 184.34 b
TP NUMEROUS O/H CABLES
CONIFER G 0.7x3 HT 14m
CONIFER G 0.7 HT 12m
CONIFER G 0.7 HT 10m PTO33
CONIFER HEDGE HT 3.5m
SILVER BIRCH G 0.4 HT 7m
ELDER MG HT 7m
ELDER MG HT 5m
ASH MG HT 4m
ASH G 0.3 HT 3m
ASH G 0.3x3 HT 3m
G 0.3x3 HT 5m
MIXED FOLIAGE AV. HT 4m
C/B FENCE HT VARIES (POOR CONDITION)