DO NOT SCALE FROM DRAWING. ALL DIMENSIONS MUST BE TAKEN ON SITE.

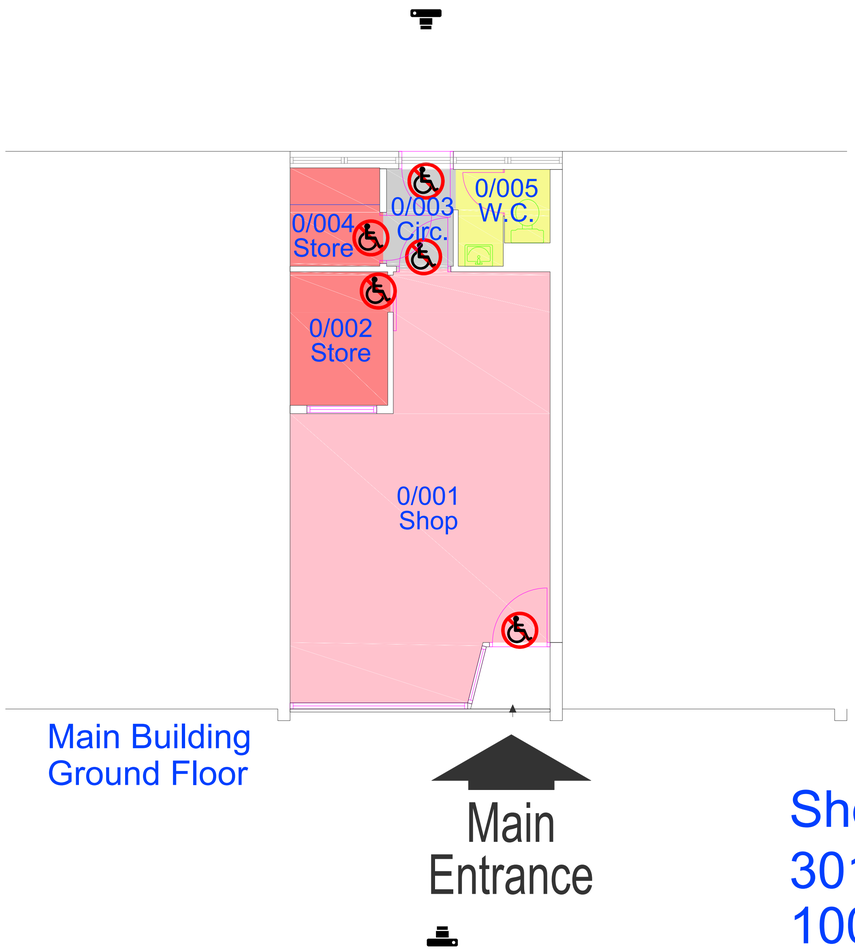

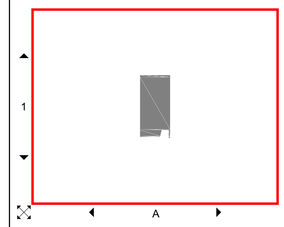



- Accommodation
- Changing/Cloaks
- Child Care
- Circulation
- Dining
- Kitchen
- Medical
- Office
- Plant
- Recreation
- Resource
- Retail
- Sport/Fitness
- Store
- Toilet
- Training/Teaching
- Unclassified
- Utility
- Vehicle Storage
- Workshop
- Worship



<850 & / OR STEP

Shop
301 Hoxton Street
100023135234
100023135234

Site Area:		
Gross External Area:	39.3	
Gross Internal Area:	37.3	
Total Room Area:	34.6	
Net Internal Area:	24.8	

Rev	Description	Drn	Chk	Date
00	Initial Supply	CC	ARB	15/01/2009

Hackney

CAD-CAPTURE

CAD-CAPTURE AssetCapture™ www.assetcapture.net Tel: 01254 504450

Property: Shop
301 Hoxton Street

Title: Ground Floor Plan

Area Information		Job:	S4062
Total Site Area:		Scale:	NOT TO SCALE
Gross External Area:	39.3	Date:	15/01/2009
Gross Internal Area:	37.3	Survey:	19/11/2008
Total Room Area:	34.6	Drawn:	CAD-CAPTURE
Net Internal Area:	24.8	Checked:	ARB
Filename:	100023135234.dwg		

Drawing No: 100023135234