


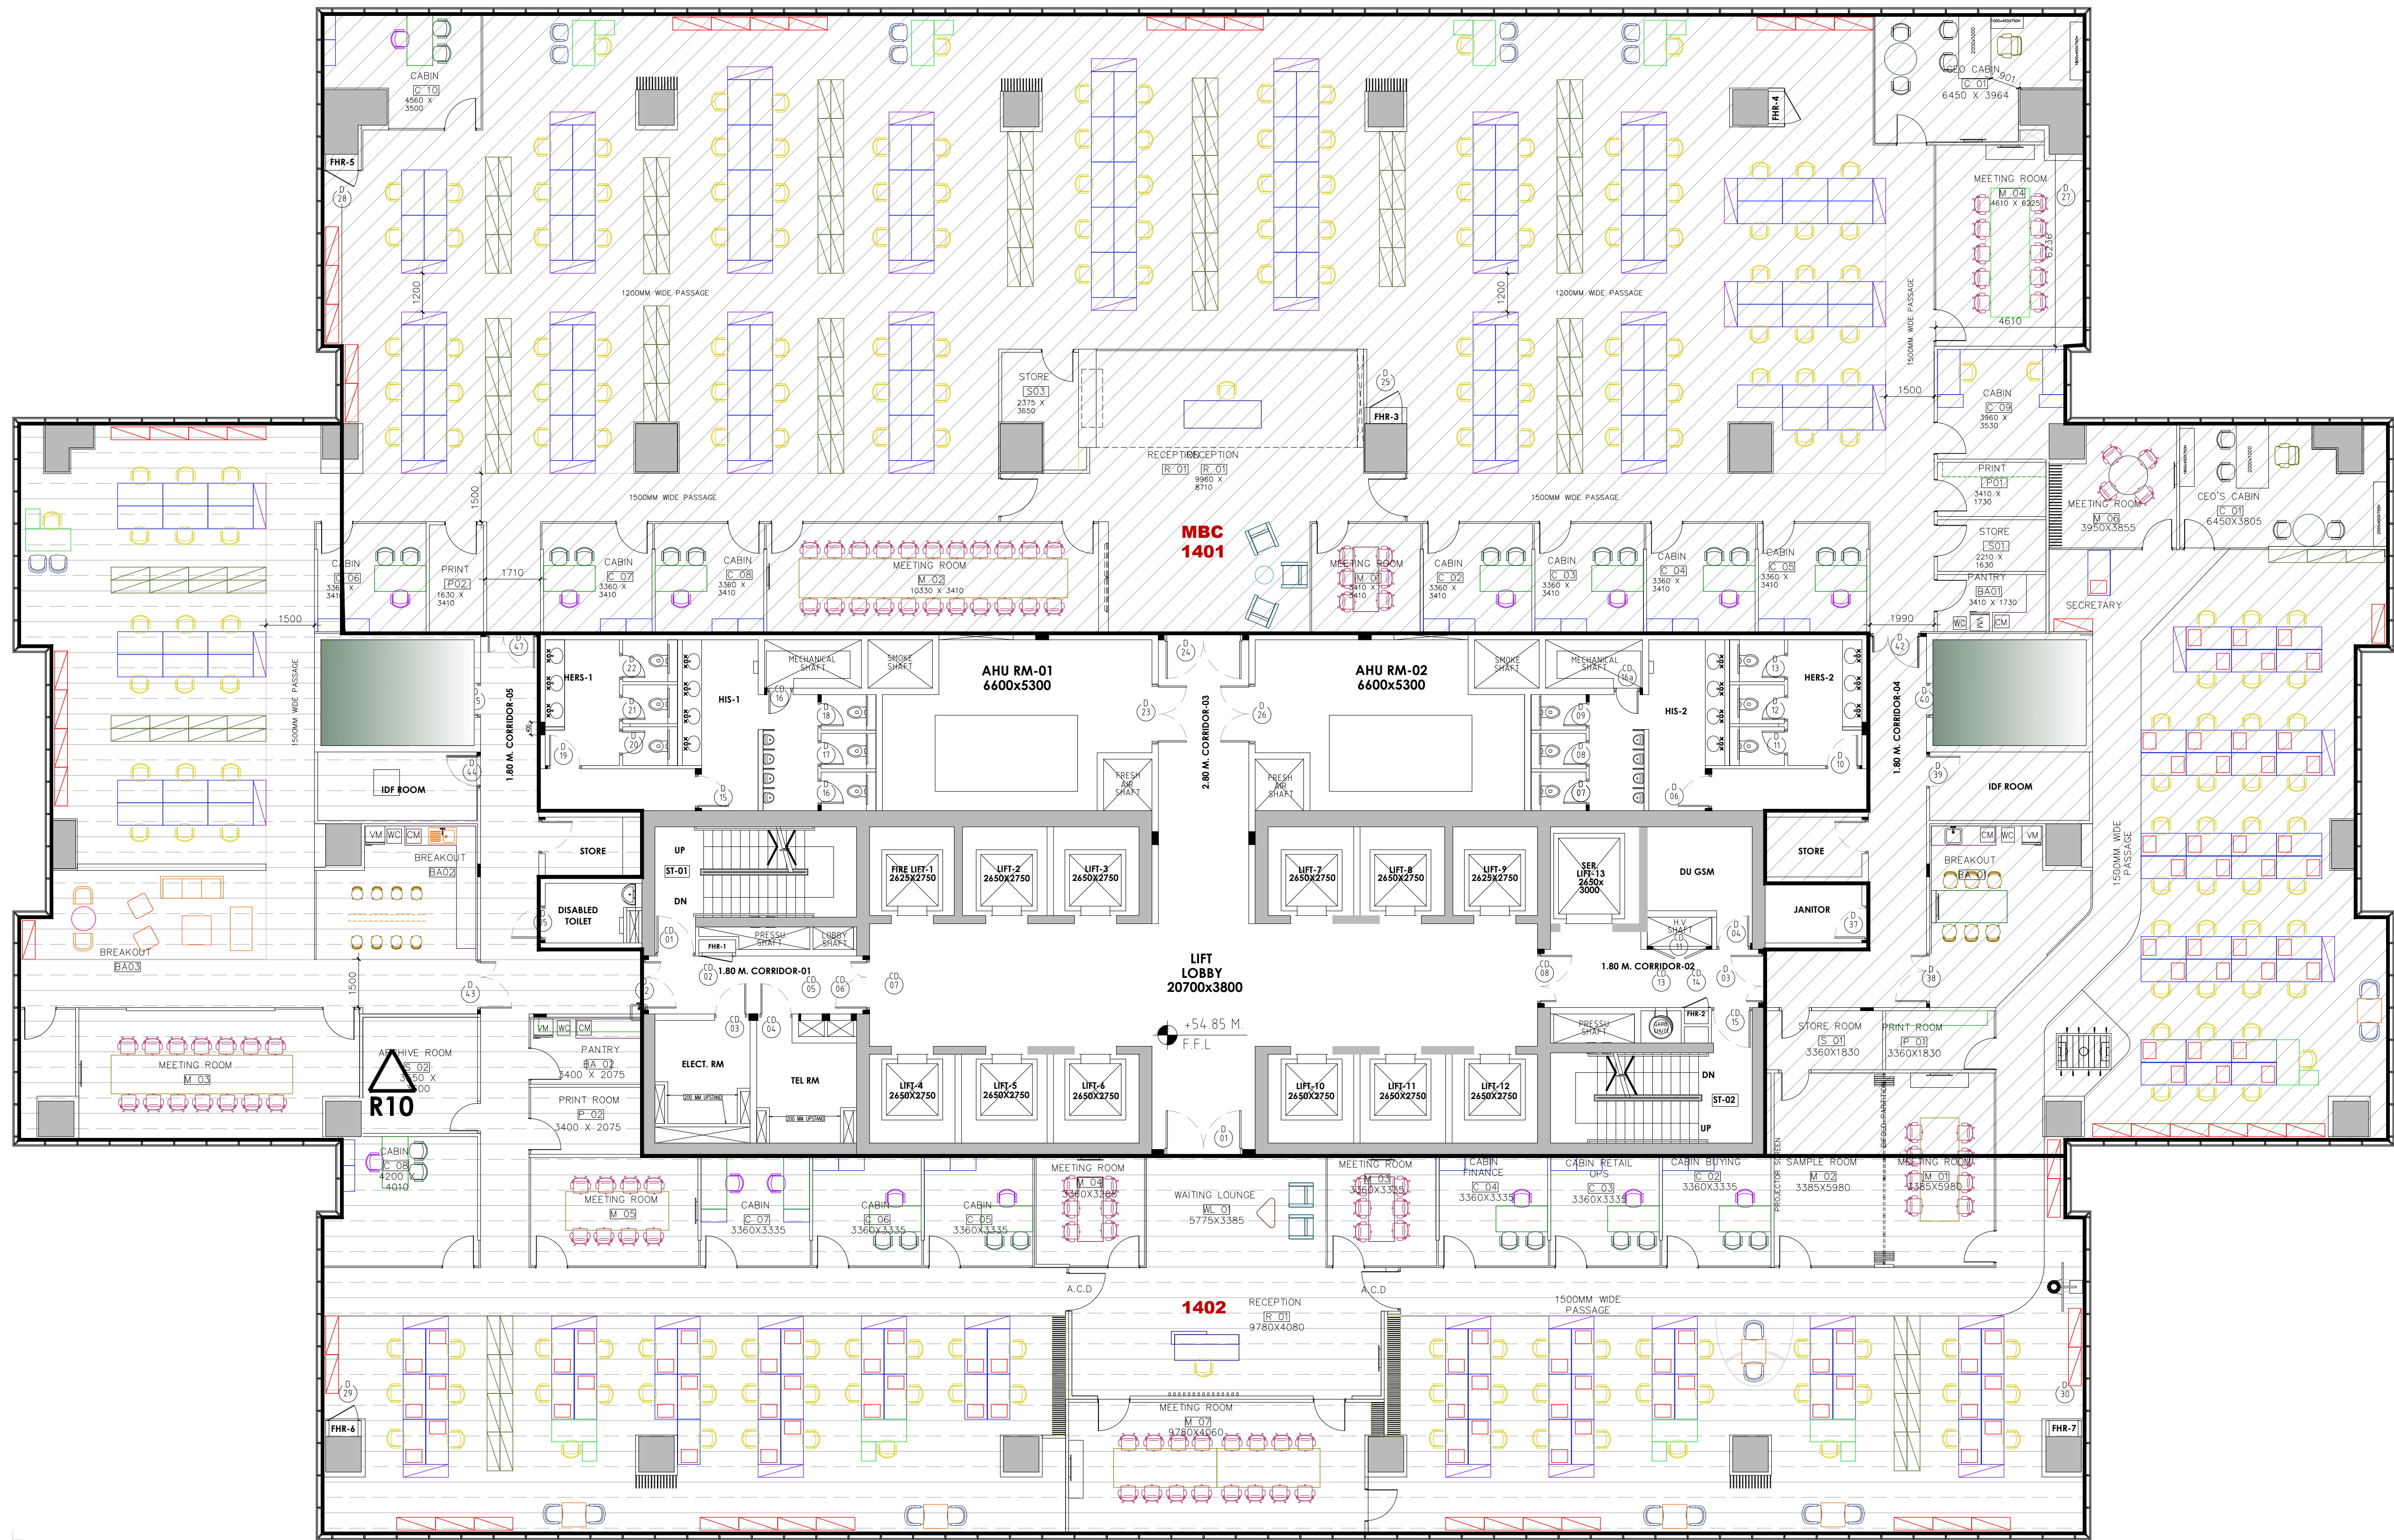

FLOOR AREA DETAILS

	DESCRIPTION	AREA IN M2	AREA IN SQFT.
1.	TOTAL FLOOR AREA	2,965.98	31,914.0
2.	COMMON AREA	732.34	7,880.0
3.	TENANT -1401	1,280.29	13,776.0
4.	TENANT-1402	953.34	10,258.0

NOTES
ALL DIMENSIONS ARE IN MILLIMETERS UNLESS NOTED OTHERWISE.
ALL LEVELS ARE IN METERS UNLESS NOTED OTHERWISE.
ANY DISCREPANCY TO BE BROUGHT TO THE NOTICE OF CONSULTANT
PRIOR TO COMMENCEMENT OF WORK
ALL STORE & IDF ROOM WALL SHOULD BE 1 Hr FIRE RATED

REVISION AS MARKED	10	10/25/23
PURPOSE OF ISSUE	REV.	DATE

CLIENT
LANDMARK ASSET HOLDING LIMITED
LANDMARK GROUP
P.O. BOX 25000, DUBAI - U.A.E
TEL: 04-8944000, FAX: 04-8944321

PROJECT NAME:
**3B + GR + 7P + 19 STOREY OFFICE BUILDING
ON PLOT D-001-004 @ TECOM, DUBAI**

DRAWING TITLE:
**14th LEVEL
FURNITURE LAYOUT**

SCALE:	DRAWN:	CHECKED:	APPROVED:	SIZE:
N.T.S	Srj	MONSTE/ASHOK	ALOK	A2
PROJECT NO.	CAD FILE	DATE:	DATE:	REV.
101	REF.	14th LVL.dwg	13-Dec-15	10
DRAWING NO.	A-111e			