


KEY

|         |                      |
|---------|----------------------|
| (n.nn)  | CEILING HEIGHT       |
| (Fn.nn) | FALSE CEILING HEIGHT |
| USB     | UNDERSIDE OF BEAM    |
| FC      | FLOOR TO CILL HEIGHT |
| CH      | CILL TO HEAD HEIGHT  |
| DH      | DOOR HEAD HEIGHT     |
| x 9.99  | FLOOR LEVEL          |
| SPR     | SPRINGER HEIGHT      |
| CRO     | CROWN HEIGHT         |

THE ORIGIN AND ORIENTATION OF THE SURVEY  
IS ARBITRARY.

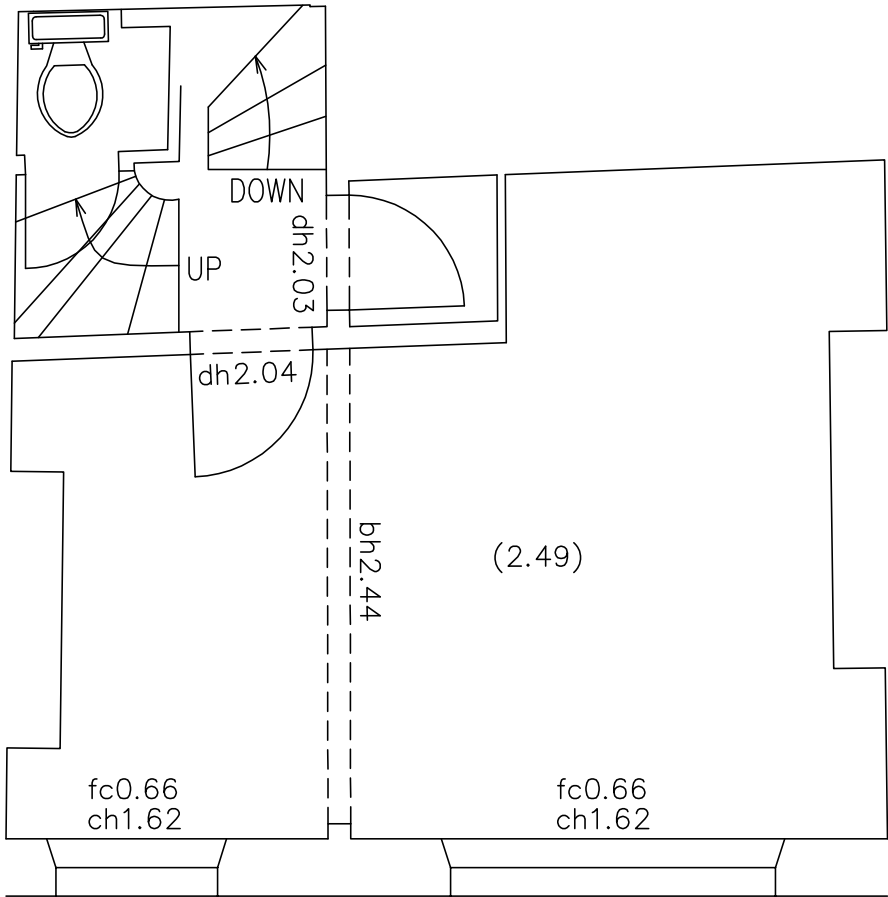

GRYPHON SURVEYS

Hanover House  
78-82 High Street  
Brentwood, Essex CM14 4AP  
Telephone: 01277-212794  
Fax: 01277-214928  
e-mail: admin@gryphonsurveys.co.uk  
www.gryphonsurveys.co.uk

Title:

1 GREAT TICHFIELD STREET  
LONDON W1  
THIRD FLOOR

drawn

LR

date

09/10

scale

1/50@a4

checked

Drg. Ref.

1GTS

KEY

- (n.nn)

(Fn.nn)

USB

FC

CH

DH

x 9.99

SPR

CRO
- CEILING HEIGHT

FALSE CEILING HEIGHT

UNDERSIDE OF BEAM

FLOOR TO CILL HEIGHT

CILL TO HEAD HEIGHT


DOOR HEAD HEIGHT

FLOOR LEVEL

SPRINGER HEIGHT

CROWN HEIGHT

THE ORIGIN AND ORIENTATION OF THE SURVEY  
IS ARBITRARY.

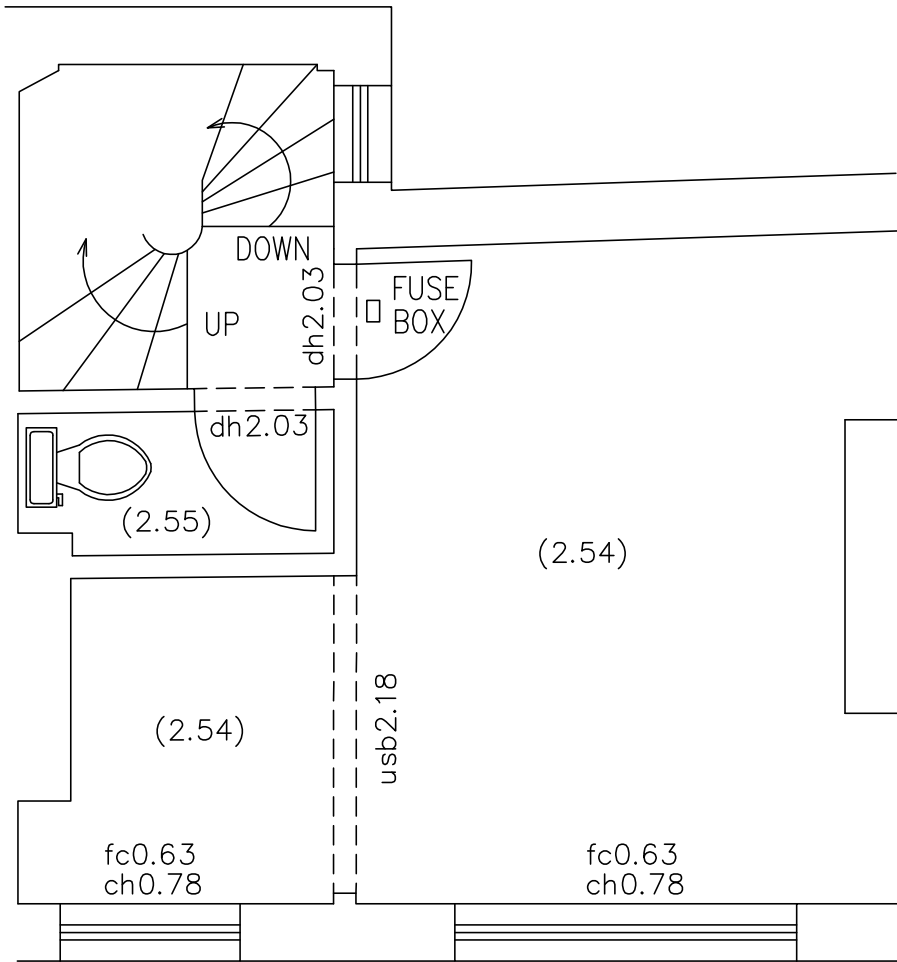

GRYPHON SURVEYS

Hanover House  
78-82 High Street  
Brentwood, Essex CM14 4AP  
Telephone: 01277-212794  
Fax: 01277-214928  
e-mail: admin@gryphonsurveys.co.uk  
www.gryphonsurveys.co.uk

Title:

1 GREAT TICHFIELD STREET  
LONDON W1  
SECOND FLOOR

drawn

LR

date

09/10

scale

1/50@a4

checked

Drg. Ref.

1GTS

KEY

- (n.nn)

(Fn.nn)

USB

FC

CH

DH

x 9.99

SPR

CRO
- CEILING HEIGHT

FALSE CEILING HEIGHT

UNDERSIDE OF BEAM

FLOOR TO CILL HEIGHT

CILL TO HEAD HEIGHT


DOOR HEAD HEIGHT

FLOOR LEVEL

SPRINGER HEIGHT

CROWN HEIGHT

THE ORIGIN AND ORIENTATION OF THE SURVEY  
IS ARBITRARY.

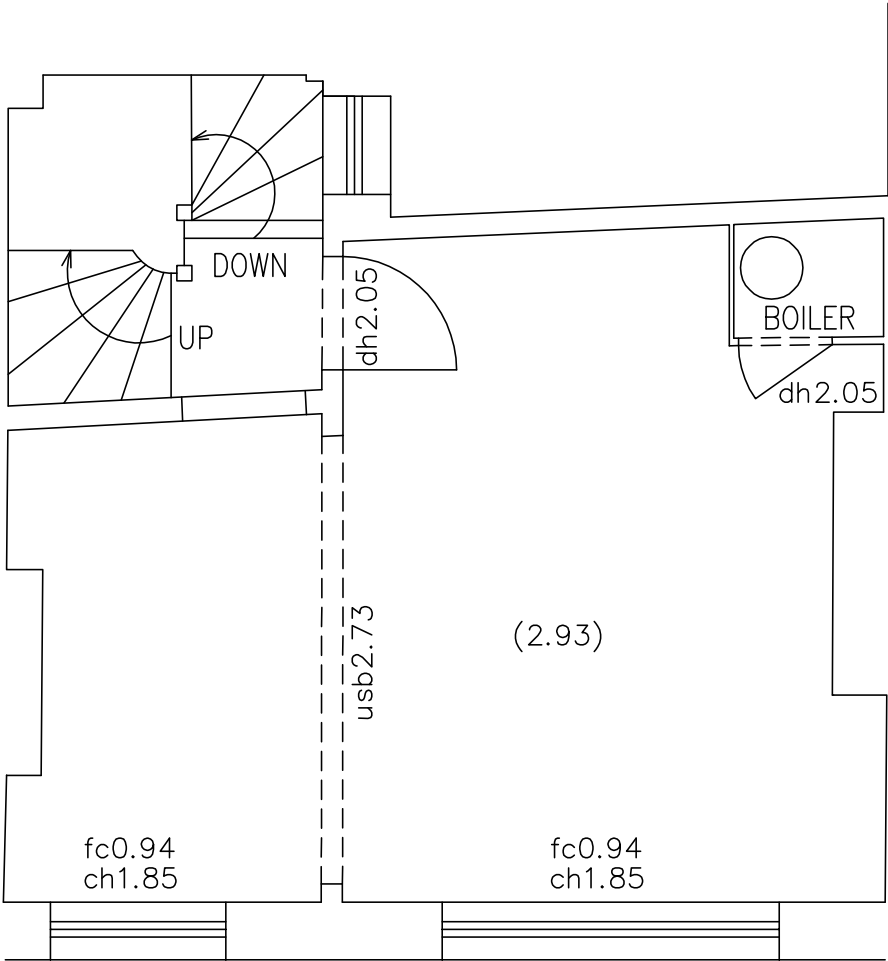

GRYPHON SURVEYS

Hanover House  
78-82 High Street  
Brentwood, Essex CM14 4AP  
Telephone: 01277-212794  
Fax: 01277-214928  
e-mail: admin@gryphonsurveys.co.uk  
www.gryphonsurveys.co.uk

Title:


1 GREAT TICHFIELD STREET  
LONDON W1  
FIRST FLOOR

|         |         |                       |
|---------|---------|-----------------------|
| drawn   | LR      | Drg. Ref.<br><br>1GTS |
| date    | 09/10   |                       |
| scale   | 1/50@a4 |                       |
| checked |         |                       |

# KEY

|         |                      |
|---------|----------------------|
| (n.nn)  | CEILING HEIGHT       |
| (Fn.nn) | FALSE CEILING HEIGHT |
| USB     | UNDERSIDE OF BEAM    |
| FC      | FLOOR TO CILL HEIGHT |
| CH      | CILL TO HEAD HEIGHT  |
| DH      | DOOR HEAD HEIGHT     |
| x 9.99  | FLOOR LEVEL          |
| SPR     | SPRINGER HEIGHT      |
| CRO     | CROWN HEIGHT         |

THE ORIGIN AND ORIENTATION OF THE SURVEY  
IS ARBITRARY.

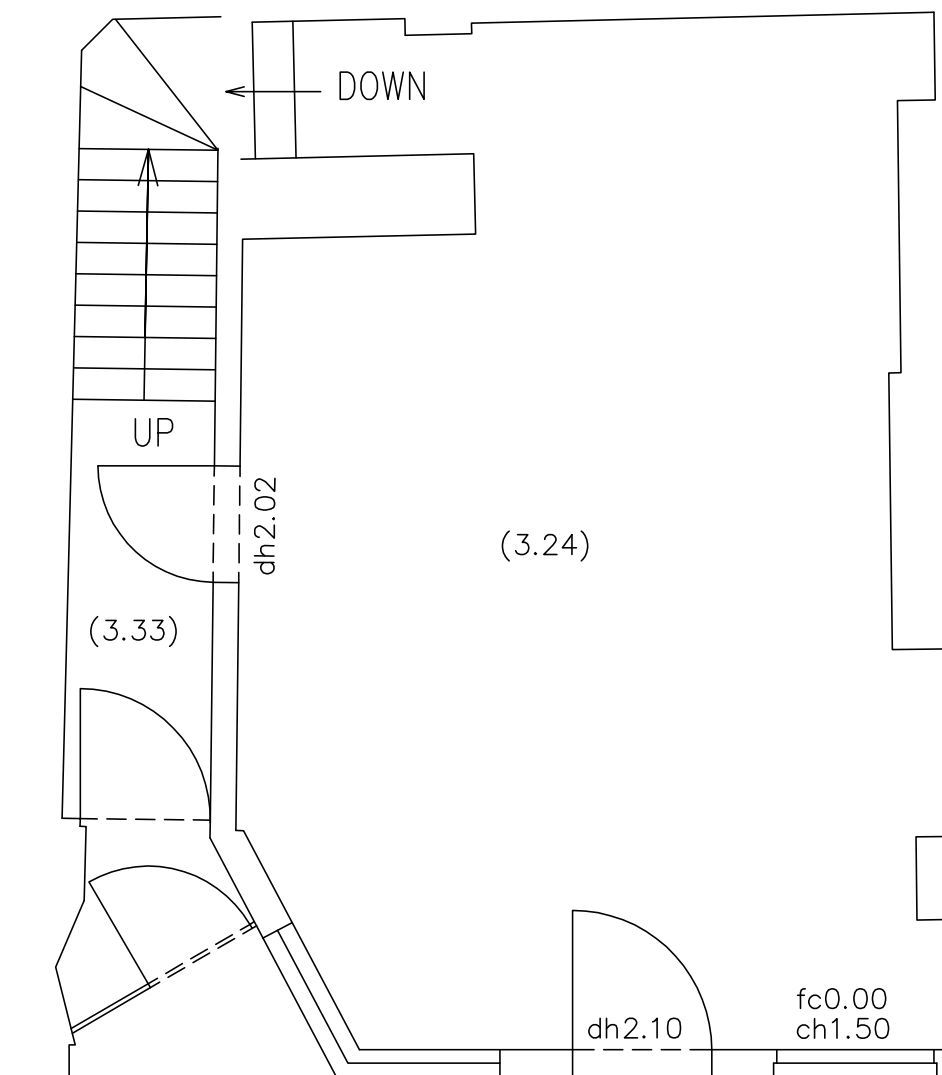

## GRYPHON SURVEYS



Hanover House  
78-82 High Street  
Brentwood, Essex CM14 4AP  
Telephone: 01277-212794  
Fax: 01277-214928  
e-mail: admin@gryphonsurveys.co.uk  
www.gryphonsurveys.co.uk

Title:

1 GREAT TICHFIELD STREET  
LONDON W1

GROUND FLOOR

drawn

LR

date

09/10

scale

1/50@a4

checked


Drg. Ref.

1GTS

KEY

(n.nn) CEILING HEIGHT  
(Fn.nn) FALSE CEILING HEIGHT  
USB UNDERSIDE OF BEAM  
FC FLOOR TO CILL HEIGHT  
CH CILL TO HEAD HEIGHT  
DH DOOR HEAD HEIGHT  
x 9.99 FLOOR LEVEL  
SPR SPRINGER HEIGHT  
CRO CROWN HEIGHT

THE ORIGIN AND ORIENTATION OF THE SURVEY  
IS ARBITRARY.

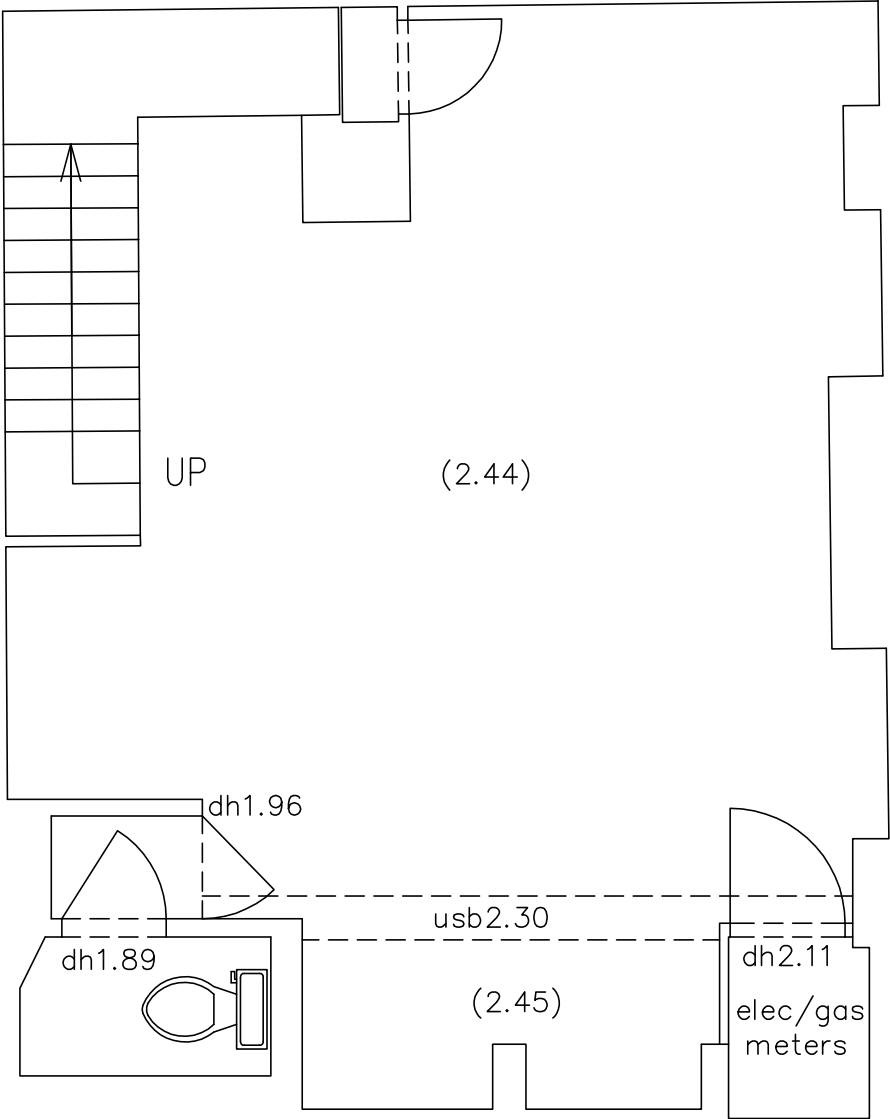

GRYPHON SURVEYS

Hanover House  
78-82 High Street  
Brentwood, Essex CM14 4AP  
Telephone: 01277-212794  
Fax: 01277-214928  
e-mail: admin@gryphonsurveys.co.uk  
www.gryphonsurveys.co.uk

Title:

1 GREAT TICHFIELD STREET  
LONDON W1  
BASEMENT

drawn

LR

date

09/10

scale

1/50@a4

checked

Drg. Ref.

1GTS