

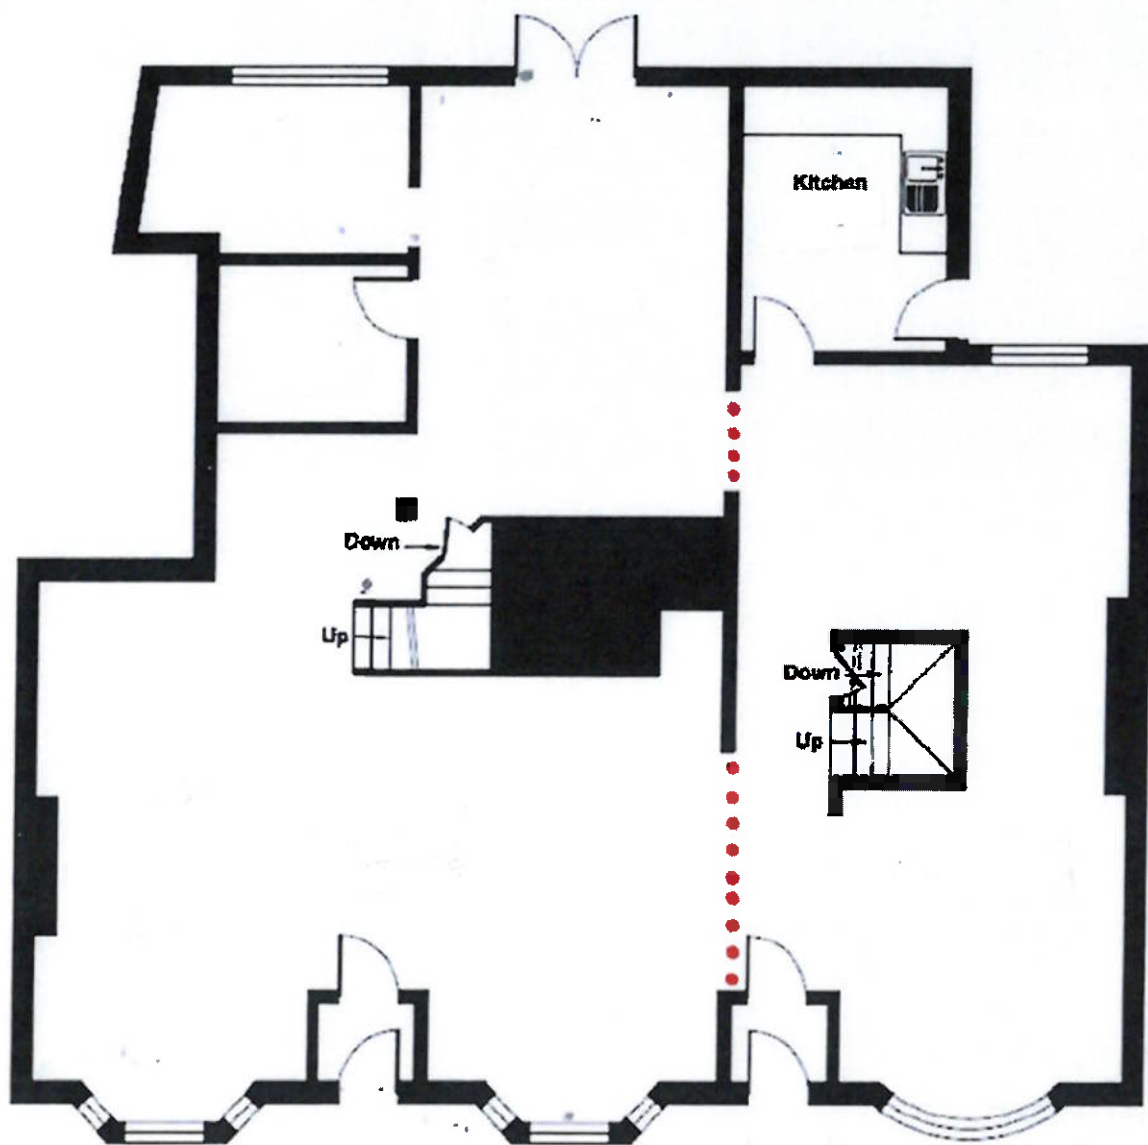


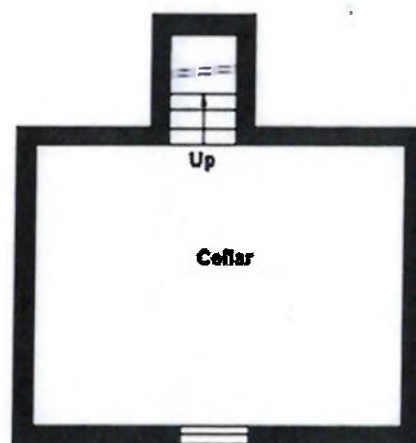

No. 8 East Cross

No. 9 East Cross

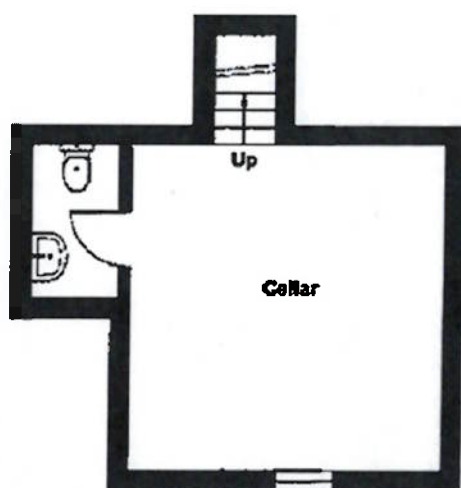

Not to scale