



LION HOUSE, 3 PLOUGH YARD - FIRST FLOOR REAR - INDICATIVE PLAN


version	date	author	version notes
P1	As dwg	As dwg	initial issue

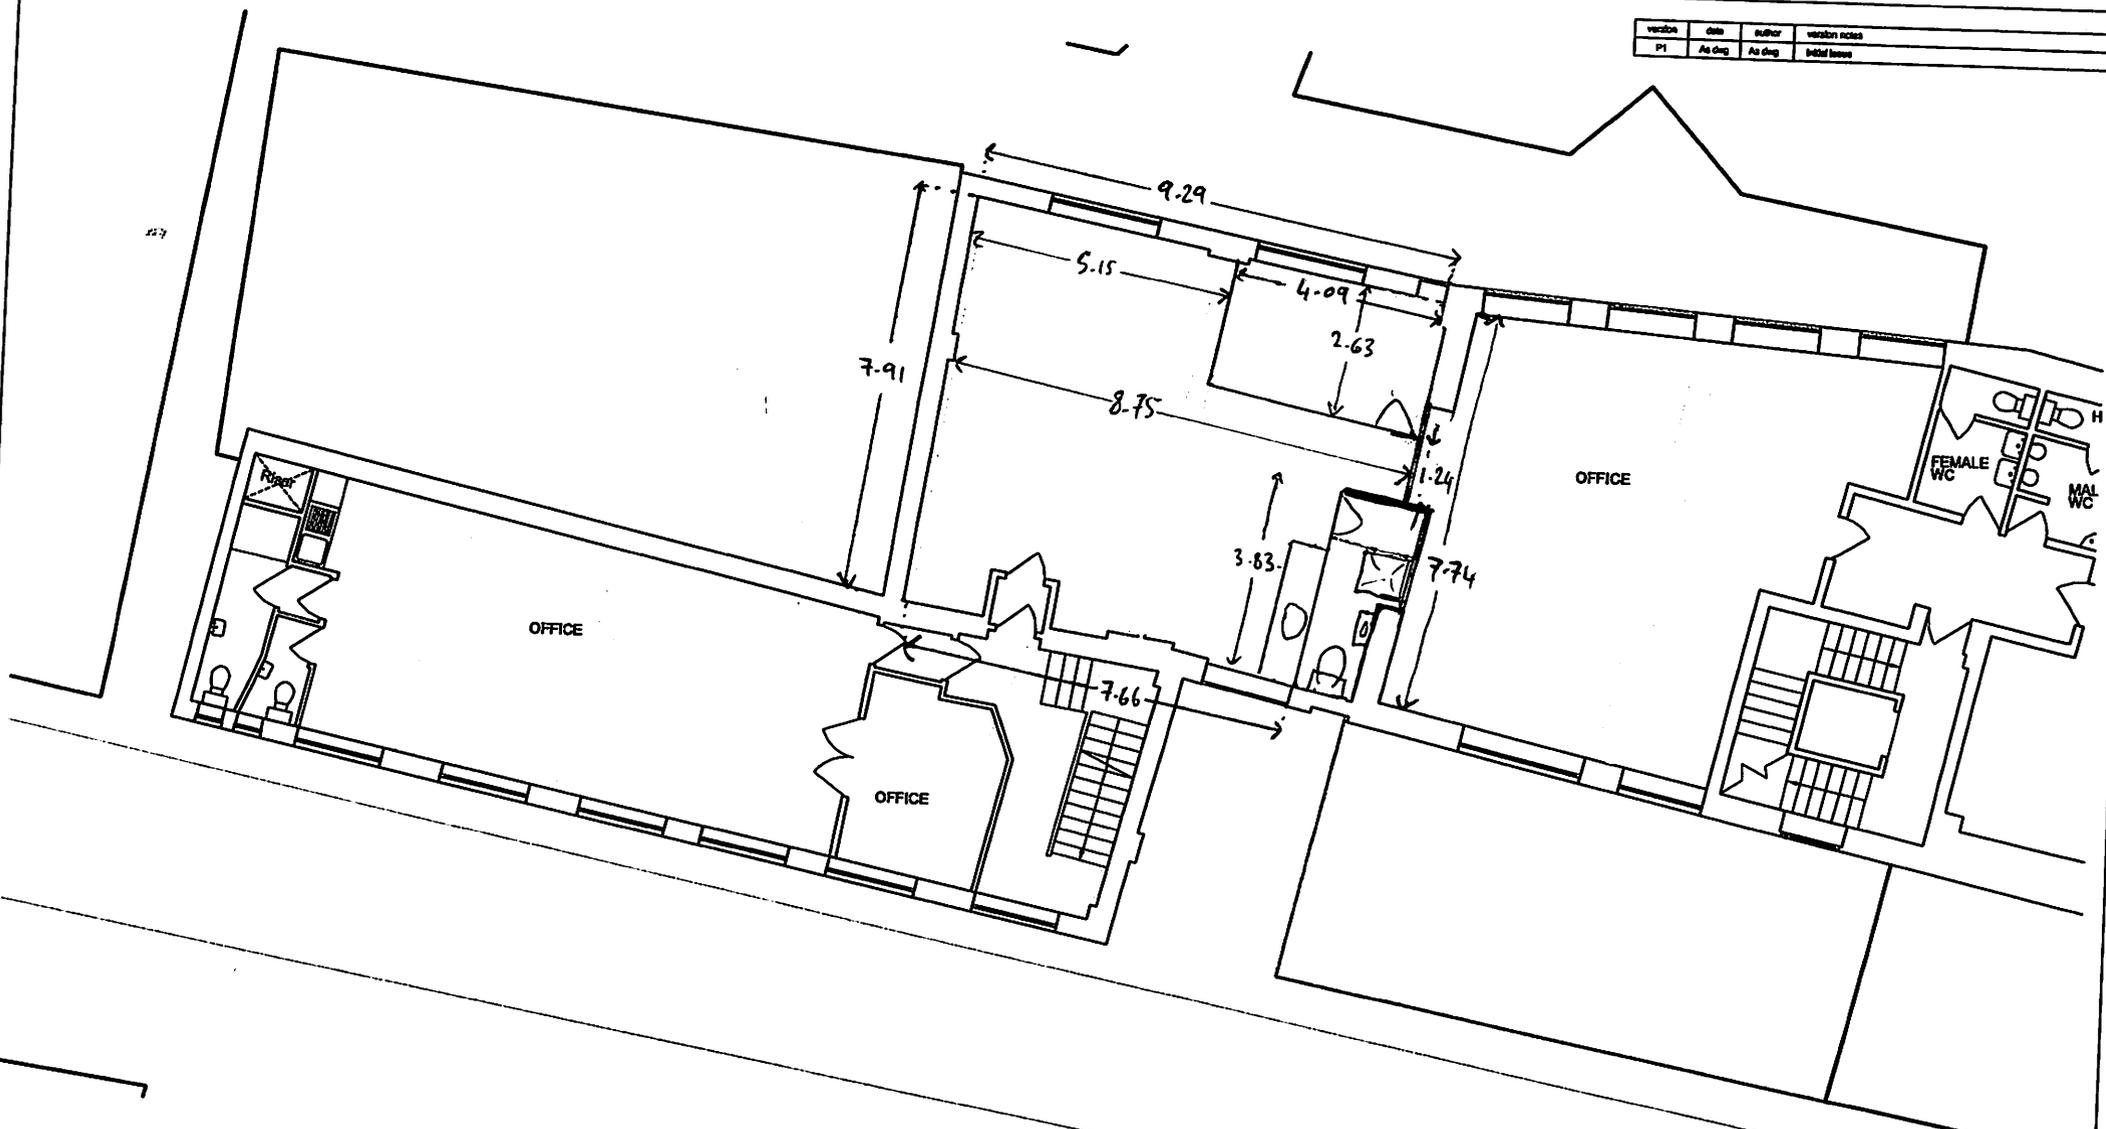

01 Proposed First Floor Plan  
Scale 1:100

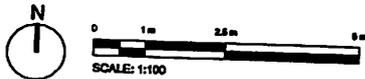

PLANNING

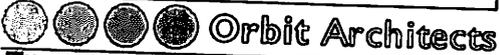

Lion House, 3 Plough Yard, EC2  
Proposed First Floor Plan  
1:100 @ A3 03.06.19 HC

DO NOT SCALE FROM THIS DRAWING | Validity of drawings as per  
© Orbit Architects 43 Marktree Road, London SE1 8NA T: 020 7263 3300 W: www.orbitarchitects.com E: info@orbitarchitects.com  
1188-D2-101 P1