
134 _GF_TT_GA_001_t3.dwg

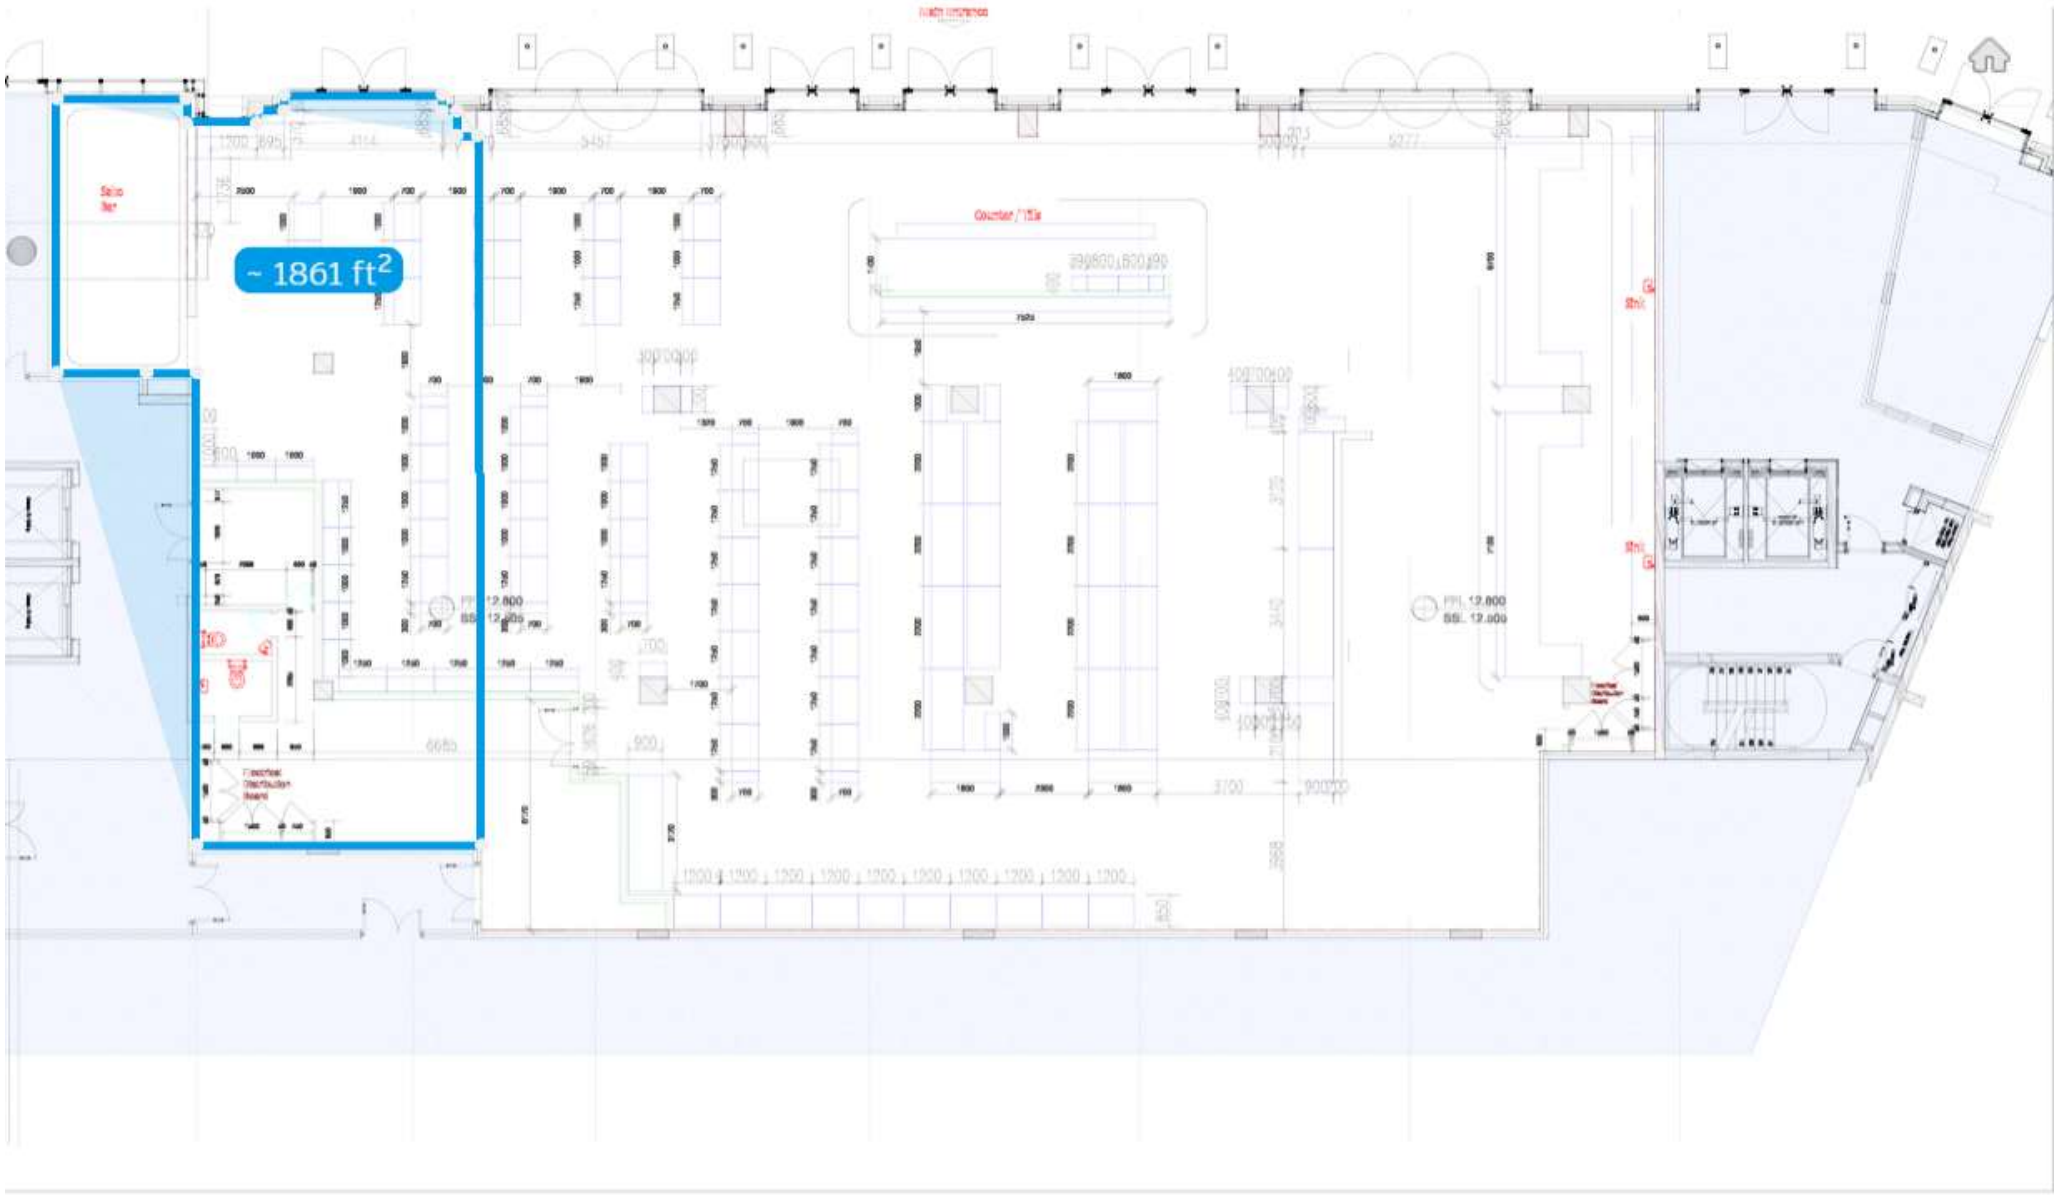

AUTODESK Viewer

AUTODESK