


4th Floor Right
St Andrews House
Leeds

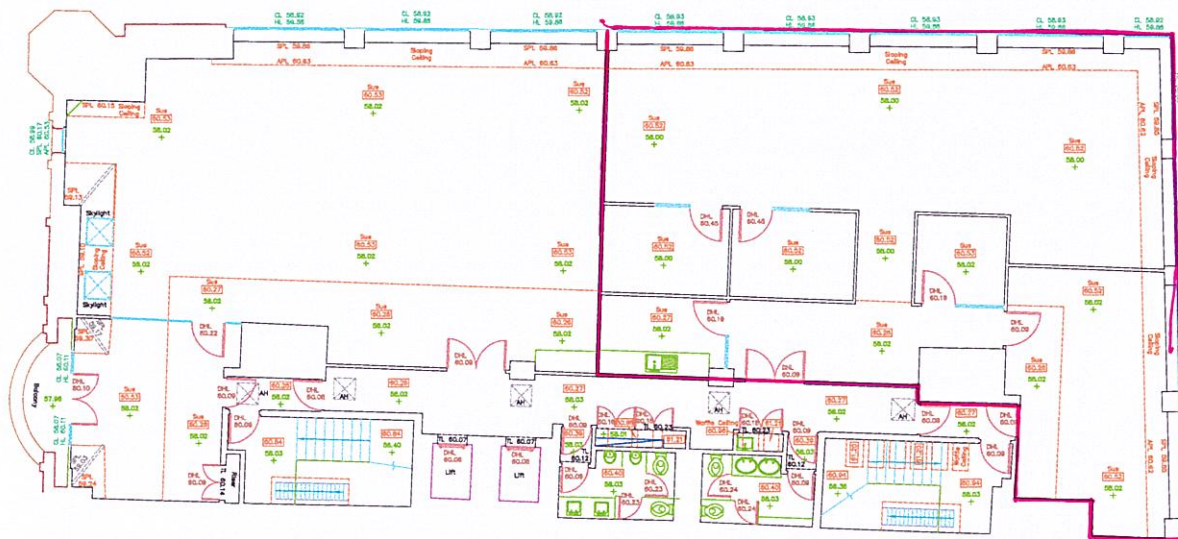

Grid : OS National Grid



Direction of North

Datum - OS Level Datum
Using the OS GPS Network and applying
OSGM15 National Geoid Model to obtain
local area corrections

KEY

- 116.12 + Floor Level
- 56.12 Ceiling Level
- APL 33.15 Apex Level
- SPL 32.53 Spring Level
- SUS Suspended Ceiling
- BWL 95.11 Level To U/S Of Beam
- SPL 102.15 Beam Spring Level
- APL 103.69 Beam Apex Level
- CL 22.84 Recess Cill Level
- HL 24.76 Recess Head Level
- CL 22.84 Window Cill Level
- HL 24.76 Window Head Level
- COL Column
- BL 40.01 Level To Bottom Of Recess
- TL 41.52 Level To U/S Of Recess
- DH 2.05 Height To U/S Of Door
- AH Access Hatch (Above)

Rev	Description	Date	By
-----	-------------	------	----

YPP

St Andrew House
The Headrow, Leeds, LS1 5JW

Fourth Floor Plan



Land & Measured Building Surveyors
7, Hall Annex, Thorncliffe Park, Chapeltown, Sheffield, S35 2PH
mail@silkstoneenvironmental.co.uk
Tel : 0114 2573487 www.silkstoneenvironmental.co.uk

Project No: 25288	Dwg No: 25288_4	Issue: 0
Surveyed: SA	Drawn: SA	Checked: SHJ
Date: 12/11/2025	Scale: 1:100	Sheet Size: A2

The copyright of this plan and its contents are the
sole property of Silkstone Environmental Ltd and
shall not be copied or shown to third parties
without prior consent of the Company or its clients.
Crown Copyright. All rights reserved. Licence Number: 100036464