




# Floorplans

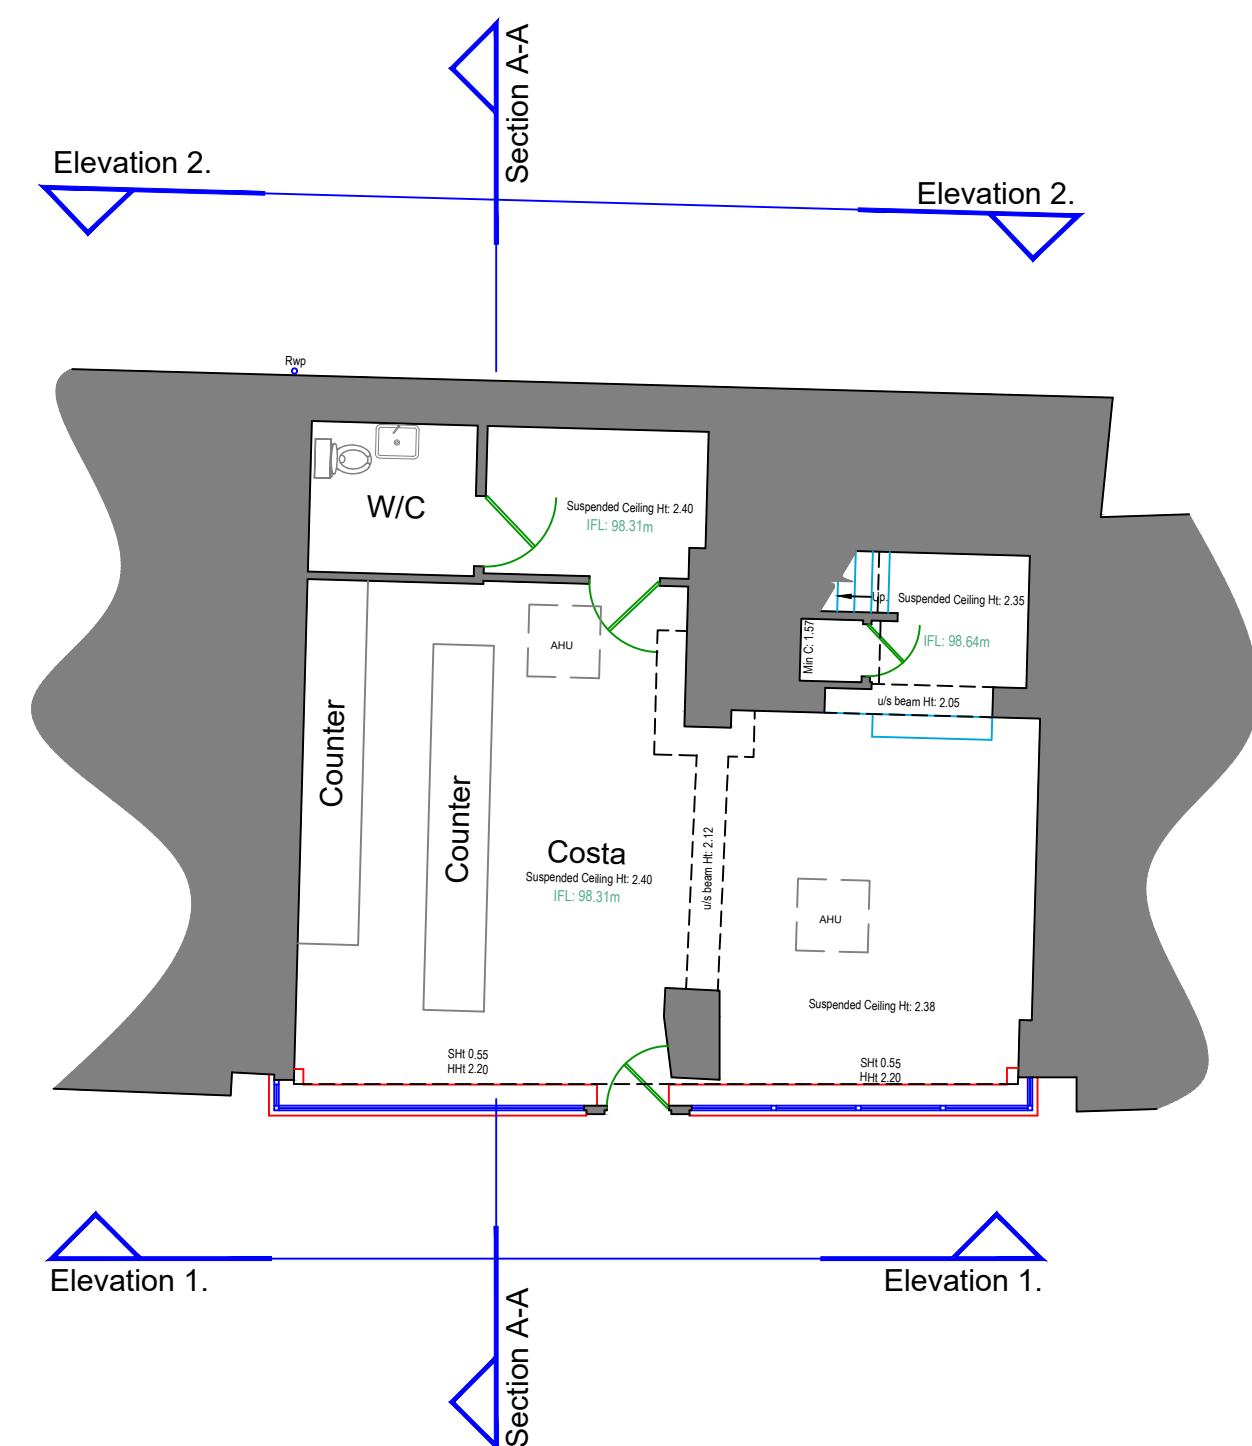


## Ground Floor

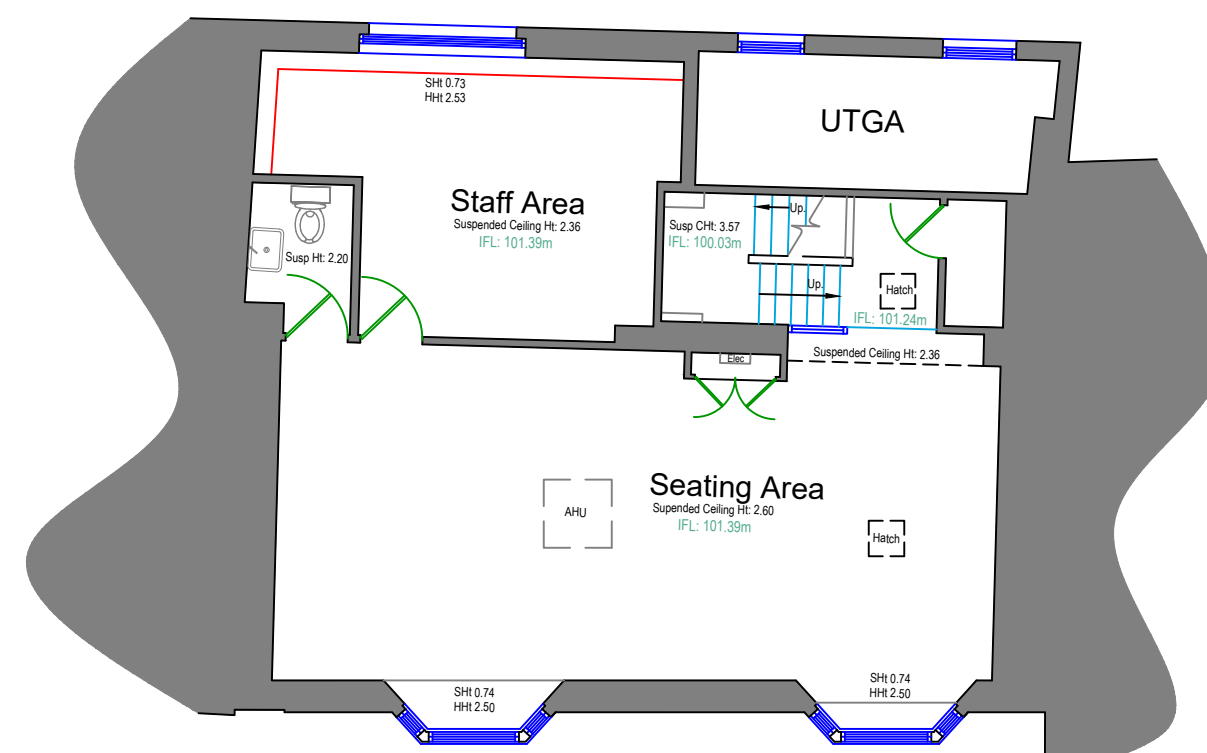


## First Floor

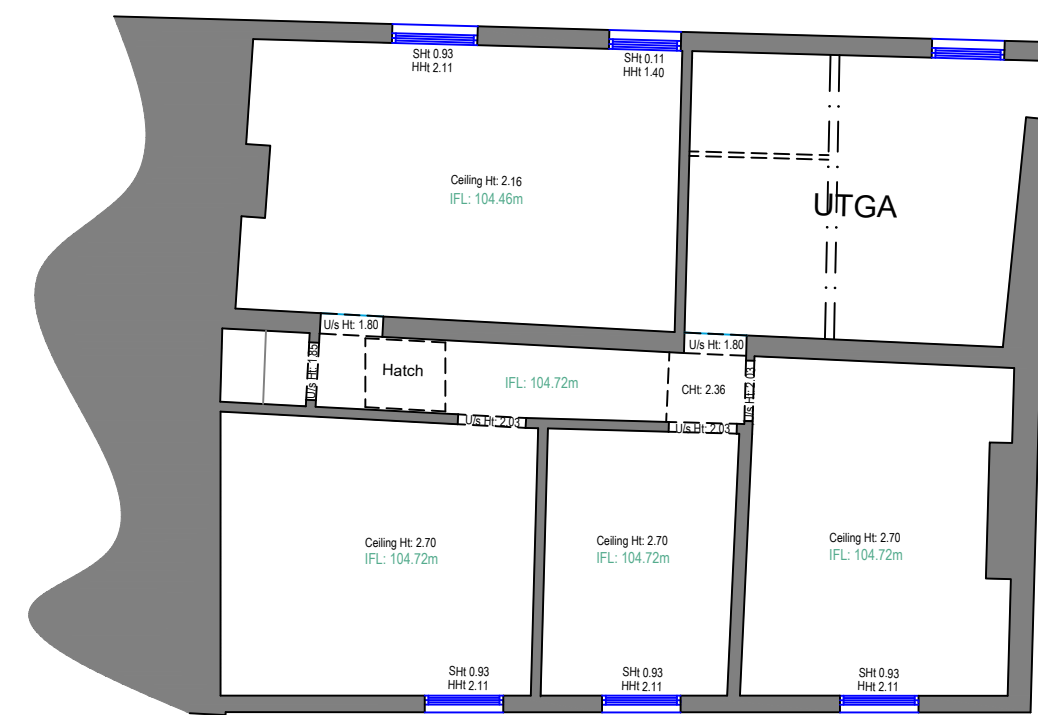

## Second Floor

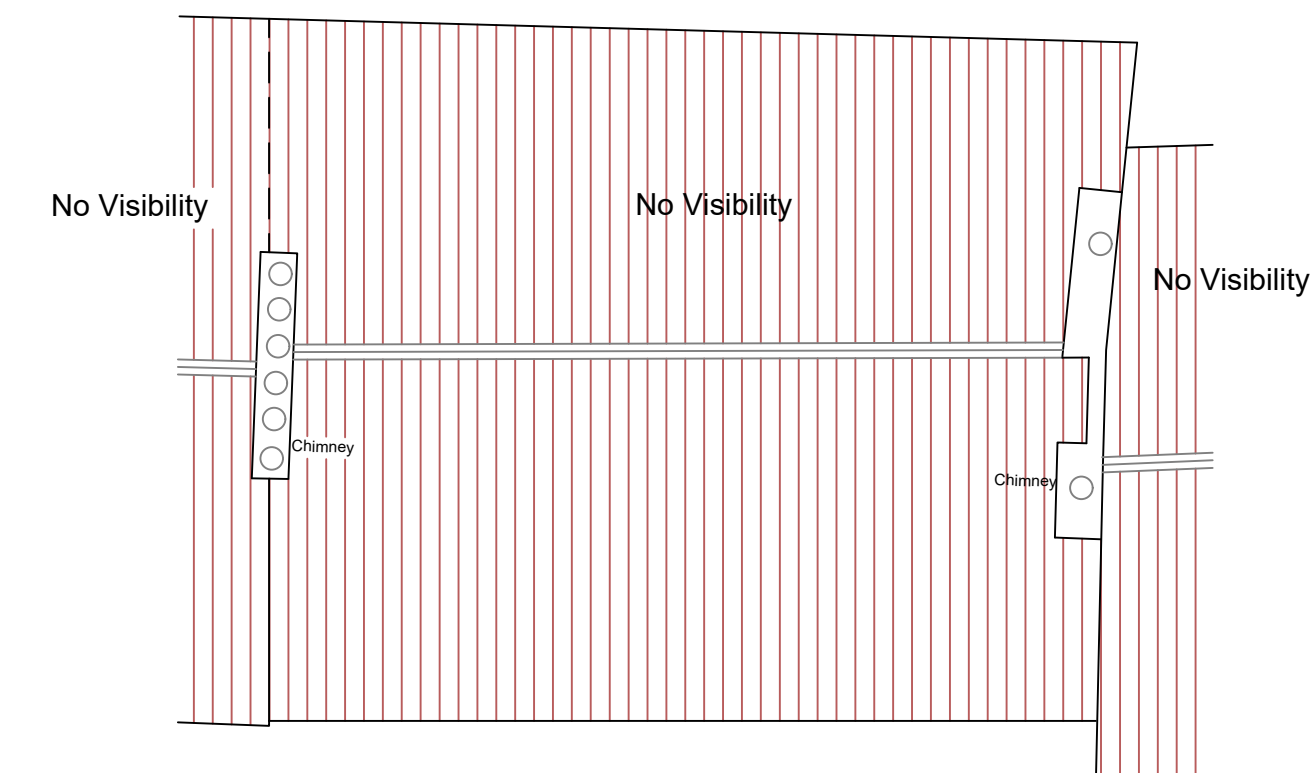

Roof

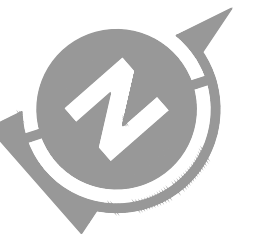

OS Note:  
This survey has been oriented to an arbitrary grid.

## Comments

This plan should only be used for its original purpose. iG Surveys accepts no responsibility for this plan if supplied to any party other than the original client.

All dimensions should be checked on site prior to design and construction.

Drainage information (where applicable) has been visually inspected from the surface and therefore should be treated as approximate only.

Key:

[illegible]

Client

Adil Group

## Project Address

25 - 27 Market Pl, Pocklington,  
York YO42 2AS

Drawing Title
---------------

Floorplans, Elevations and Section

Scale 1:100 @ A1	Date 17-11-2021
---------------------	--------------------


Drawn By LG	
----------------	--

Level datum	OS GPS
Grid orientation	OS GPS


Drawing No.	Rev.
J158-02	



Datum: 95.00m.  
Elevation 1.

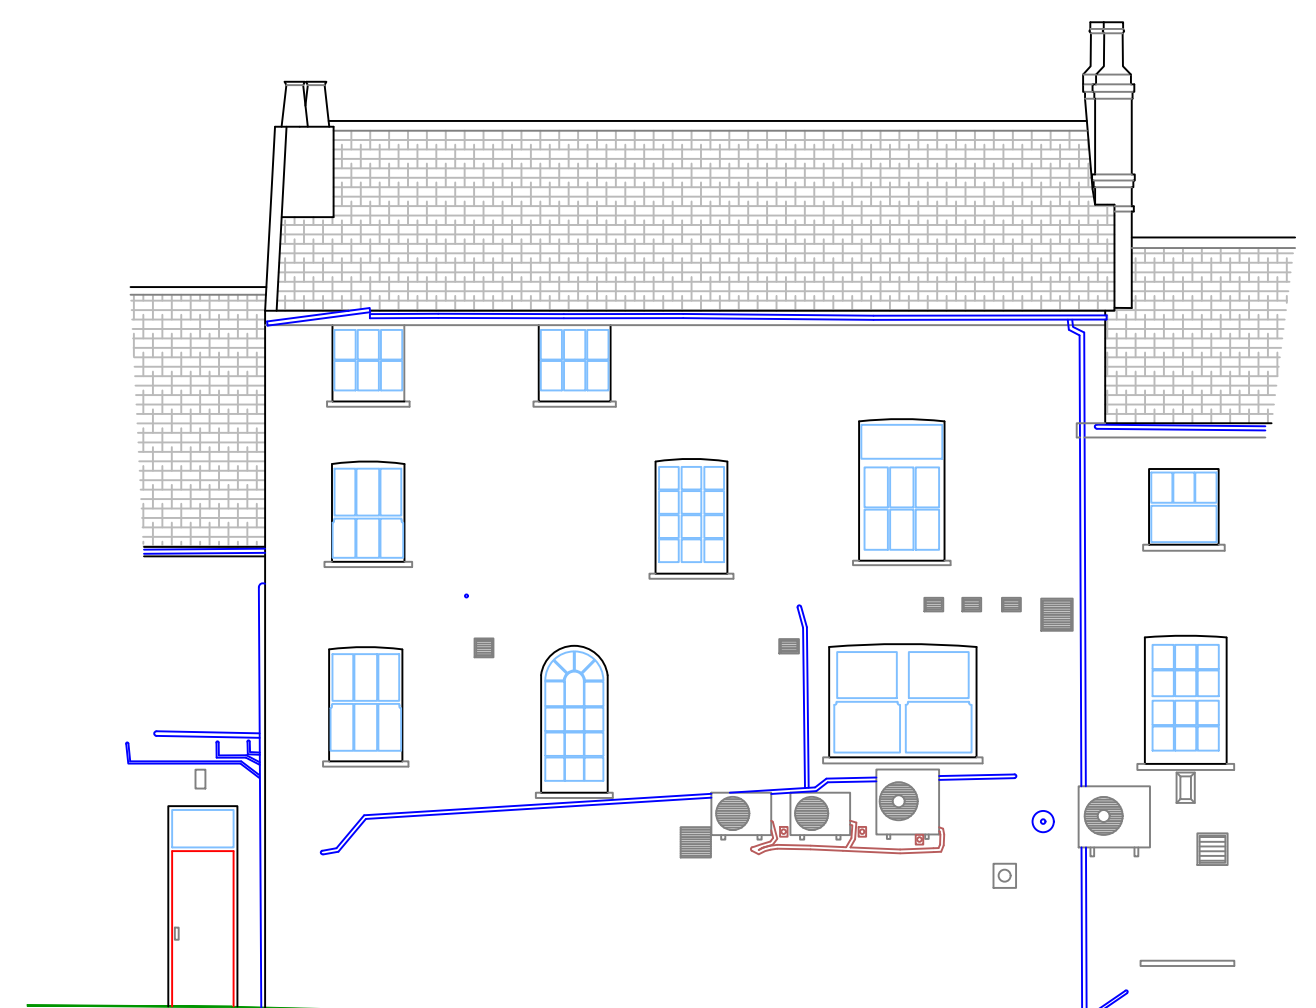

Datum: 95.00m.  
Elevation 2. (Restricted Visibility)

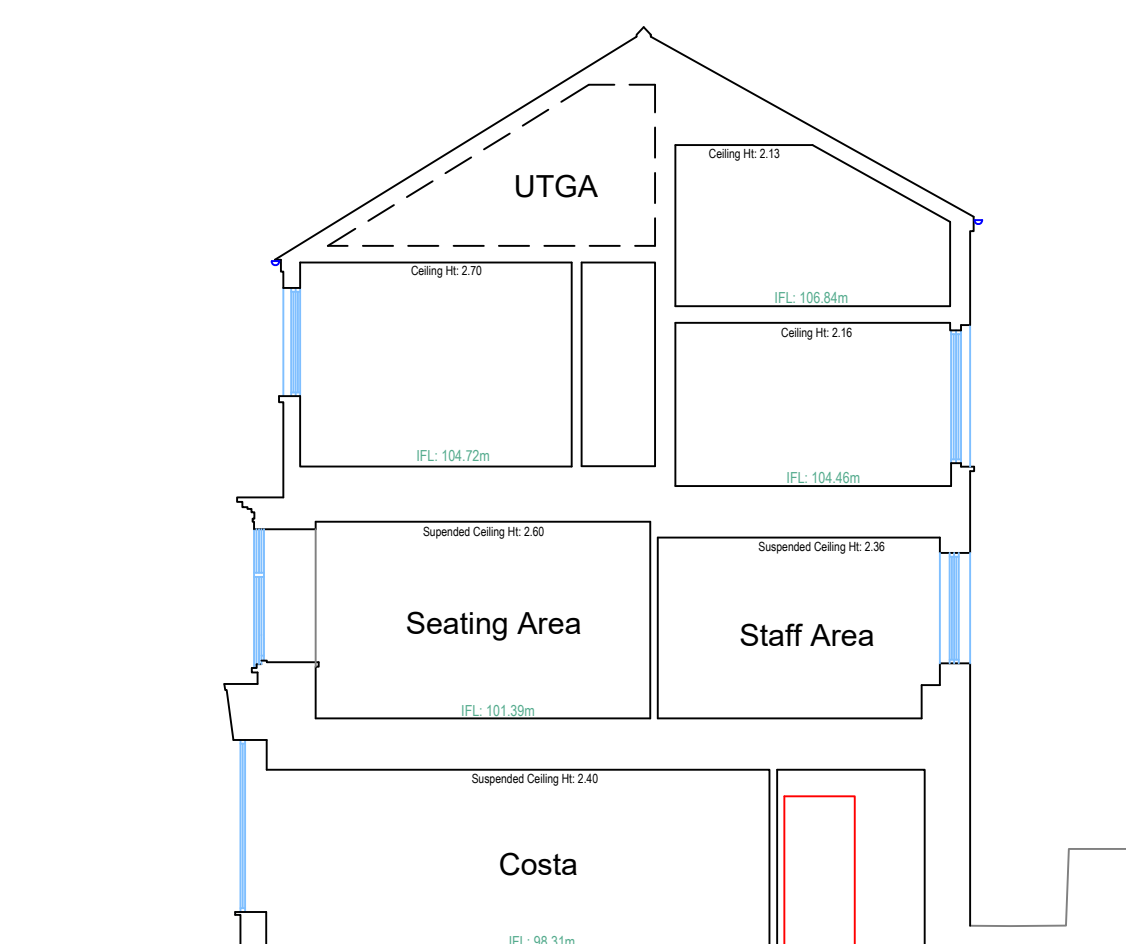

Datum: 95.00m.  
Section A-A



iG Surveys Ltd  
Unit 1 Garden Court,  
Gee Road, Coalville  
Leicestershire  
LE67 4NB