




Lower Ground Floor Plan

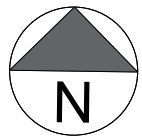

Fitzroy Square

29-30 Fitzroy Square
London
W1T 6LQ

Date	Revision	Project Number	Description	Rev
09/06/2025	00	25.05.3315	Property Survey	0/0


Drawing Name
Lower Ground Floor Plan

REFERENCES


 Net Internal Area

sterlingtemple

0203 4639225
www.sterlingtemple.com

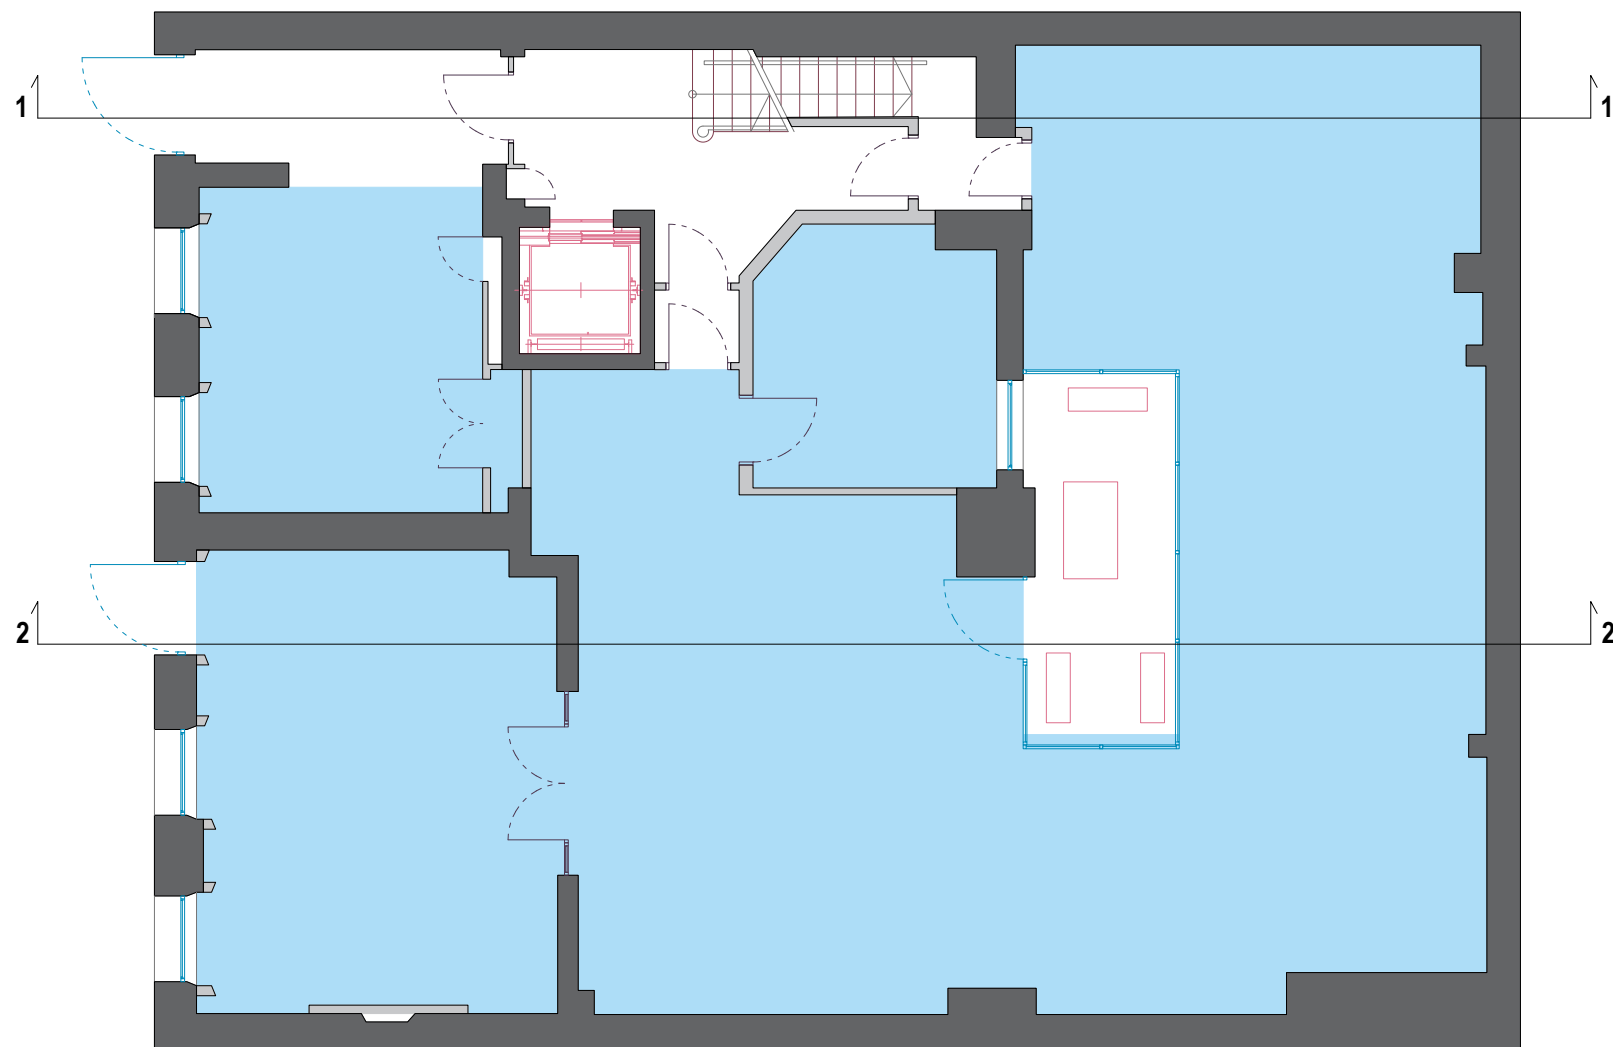

Ground Floor Plan

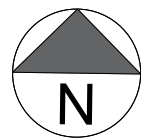

0m 5m
Scale 1:100

Fitzroy Square

29-30 Fitzroy Square
London
W1T 6LQ

Drawing Name
Ground Level Floor Plan


REFERENCES

Net Internal Area


Date	Revision	Project Number	Description	Rev
09/06/2025	00	25.05.3315	Property Survey	0/0

sterlingtemple

0203 4639225
www.sterlingtemple.com

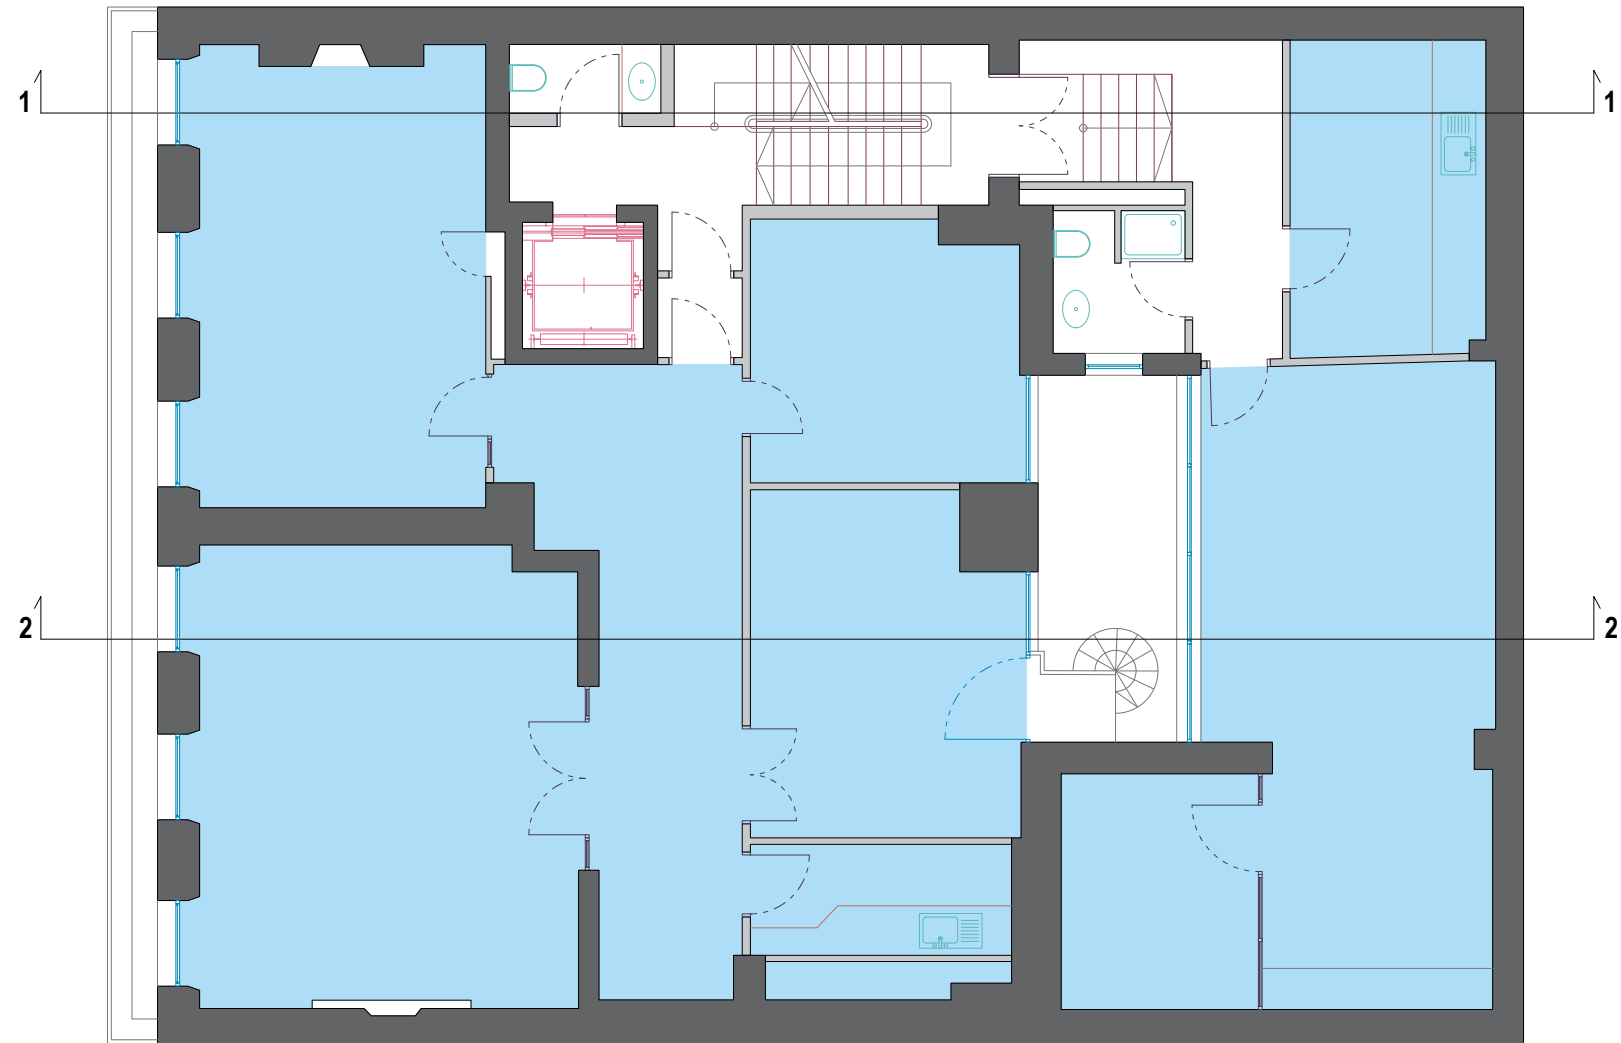

First Floor Plan

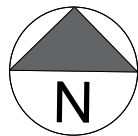

Fitzroy Square

29-30 Fitzroy Square
London
W1T 6LQ

Drawing Name
First Level Floor Plan

REFERENCES

 Net Internal Area


Date	Revision	Project Number	Description	Rev
09/06/2025	00	25.05.3315	Property Survey	0/0

sterlingtemple

0203 4639225
www.sterlingtemple.com



Second Floor Plan

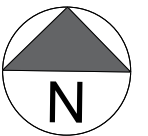

Fitzroy Square

29-30 Fitzroy Square
London
W1T 6LQ

Drawing Name
Second Level Floor Plan


REFERENCES

 Net Internal Area


Date	Revision	Project Number	Description	Rev
09/06/2025	00	25.05.3315	Property Survey	0/0

sterlingtemple

0203 4639225
www.sterlingtemple.com

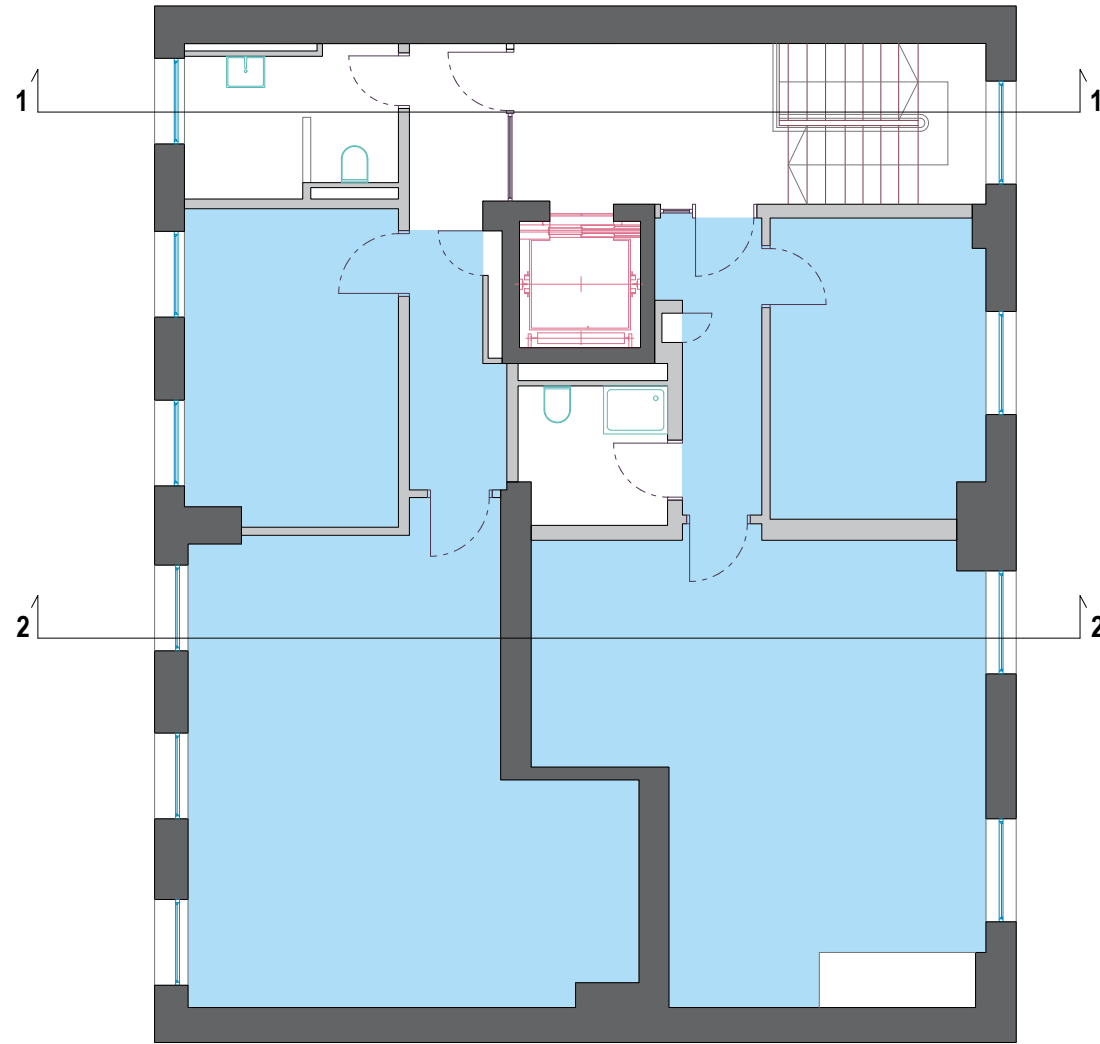

Third Floor Plan

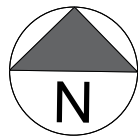

Fitzroy Square

29-30 Fitzroy Square
London
W1T 6LQ


Date	Revision	Project Number	Description	Rev
09/06/2025	00	25.05.3315	Property Survey	0/0

Drawing Name
Third Level Floor Plan

REFERENCES	
	Net Internal Area

sterlingtemple

0203 4639225
www.sterlingtemple.com

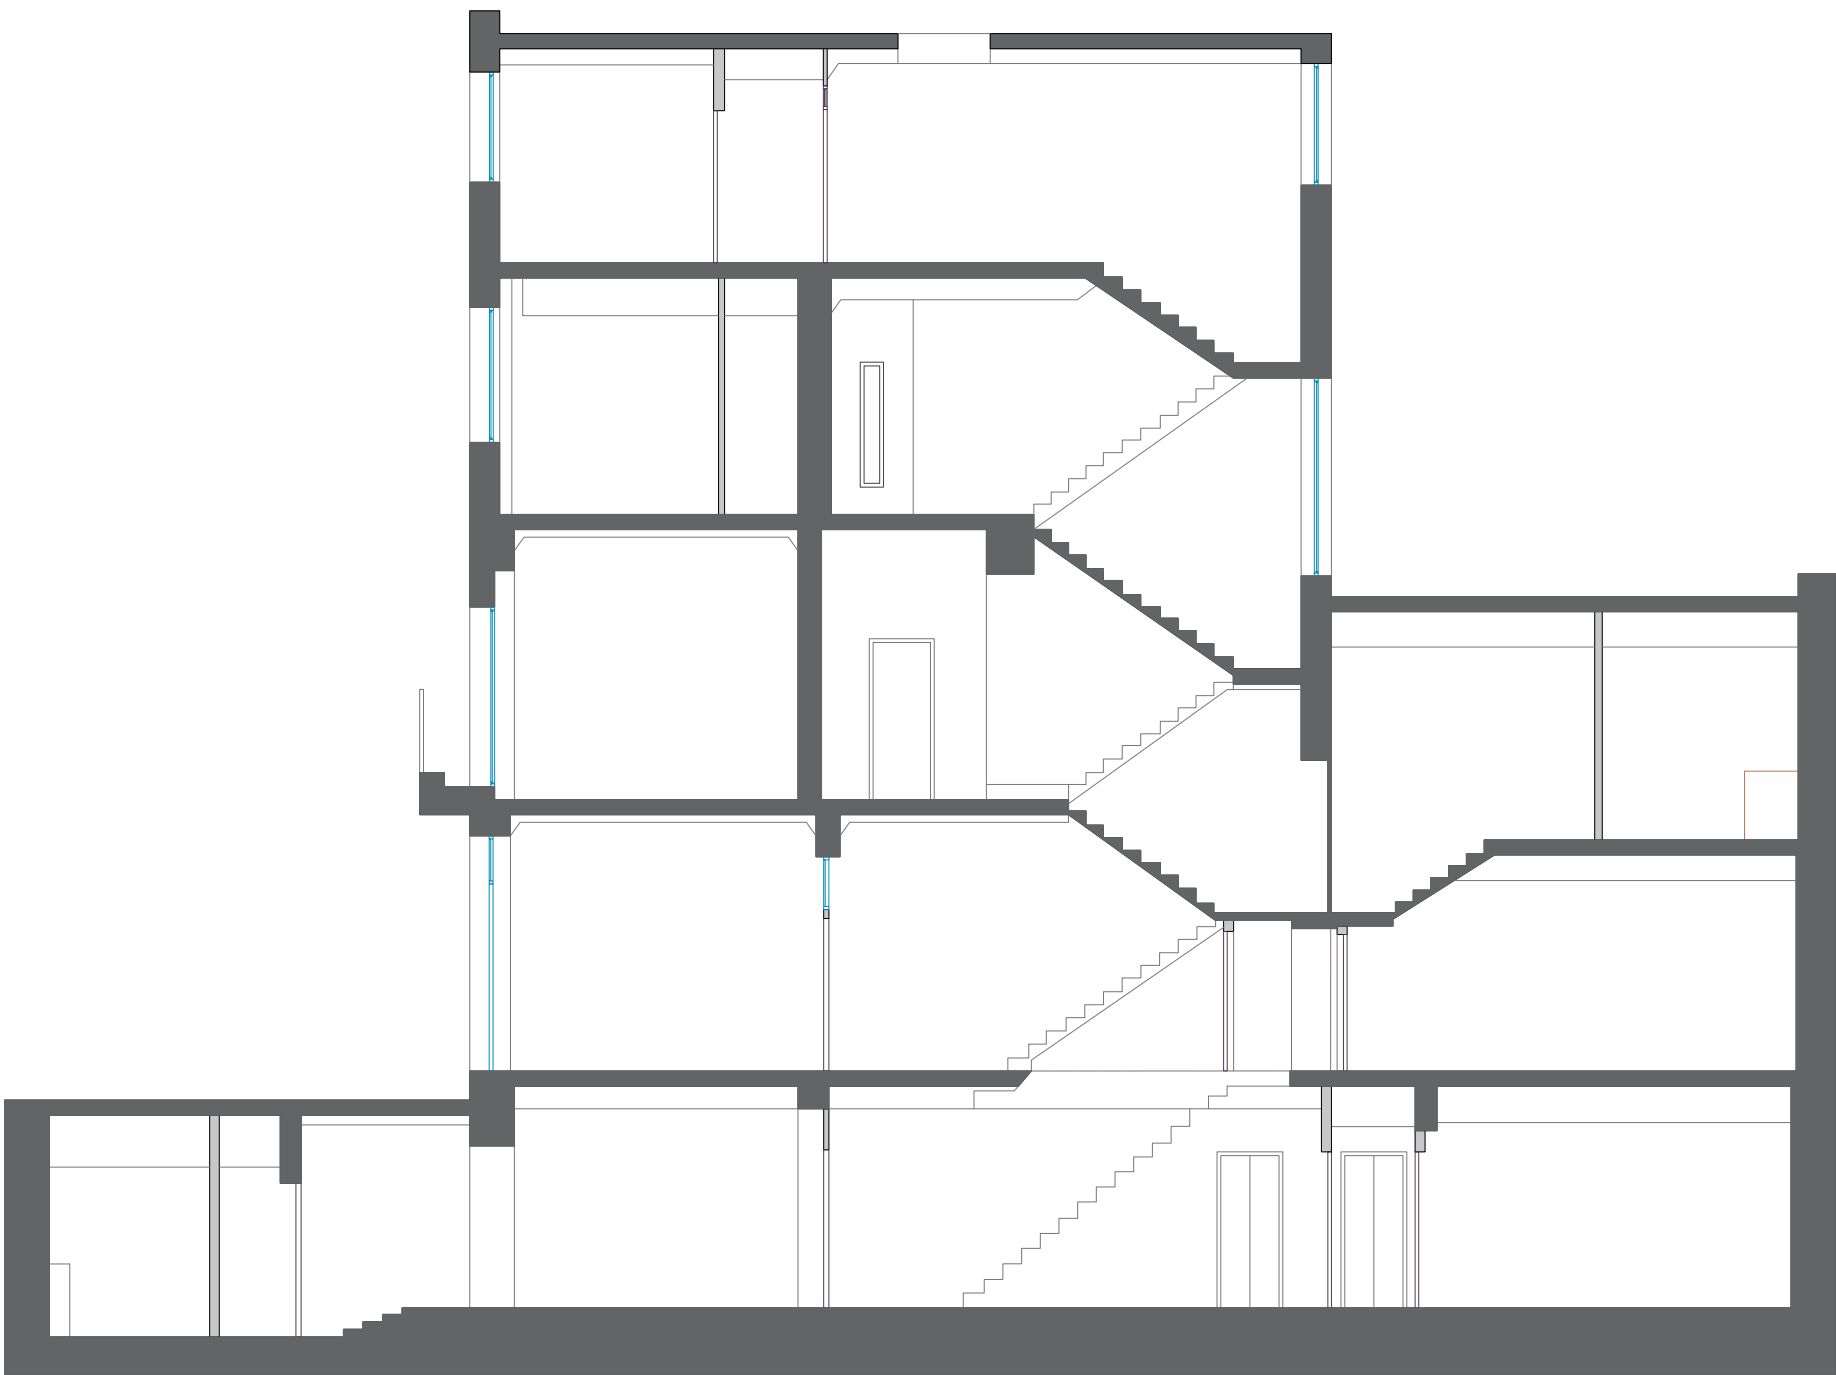

Section 1



Fitzroy Square

29-30 Fitzroy Square
London
W1T 6LQ


Date	Revision	Project Number	Description	Rev
09/06/2025	00	25.05.3315	Property Survey	0/0

Drawing Name
Section 1

REFERENCES

sterlingtemple

0203 4639225
www.sterlingtemple.com

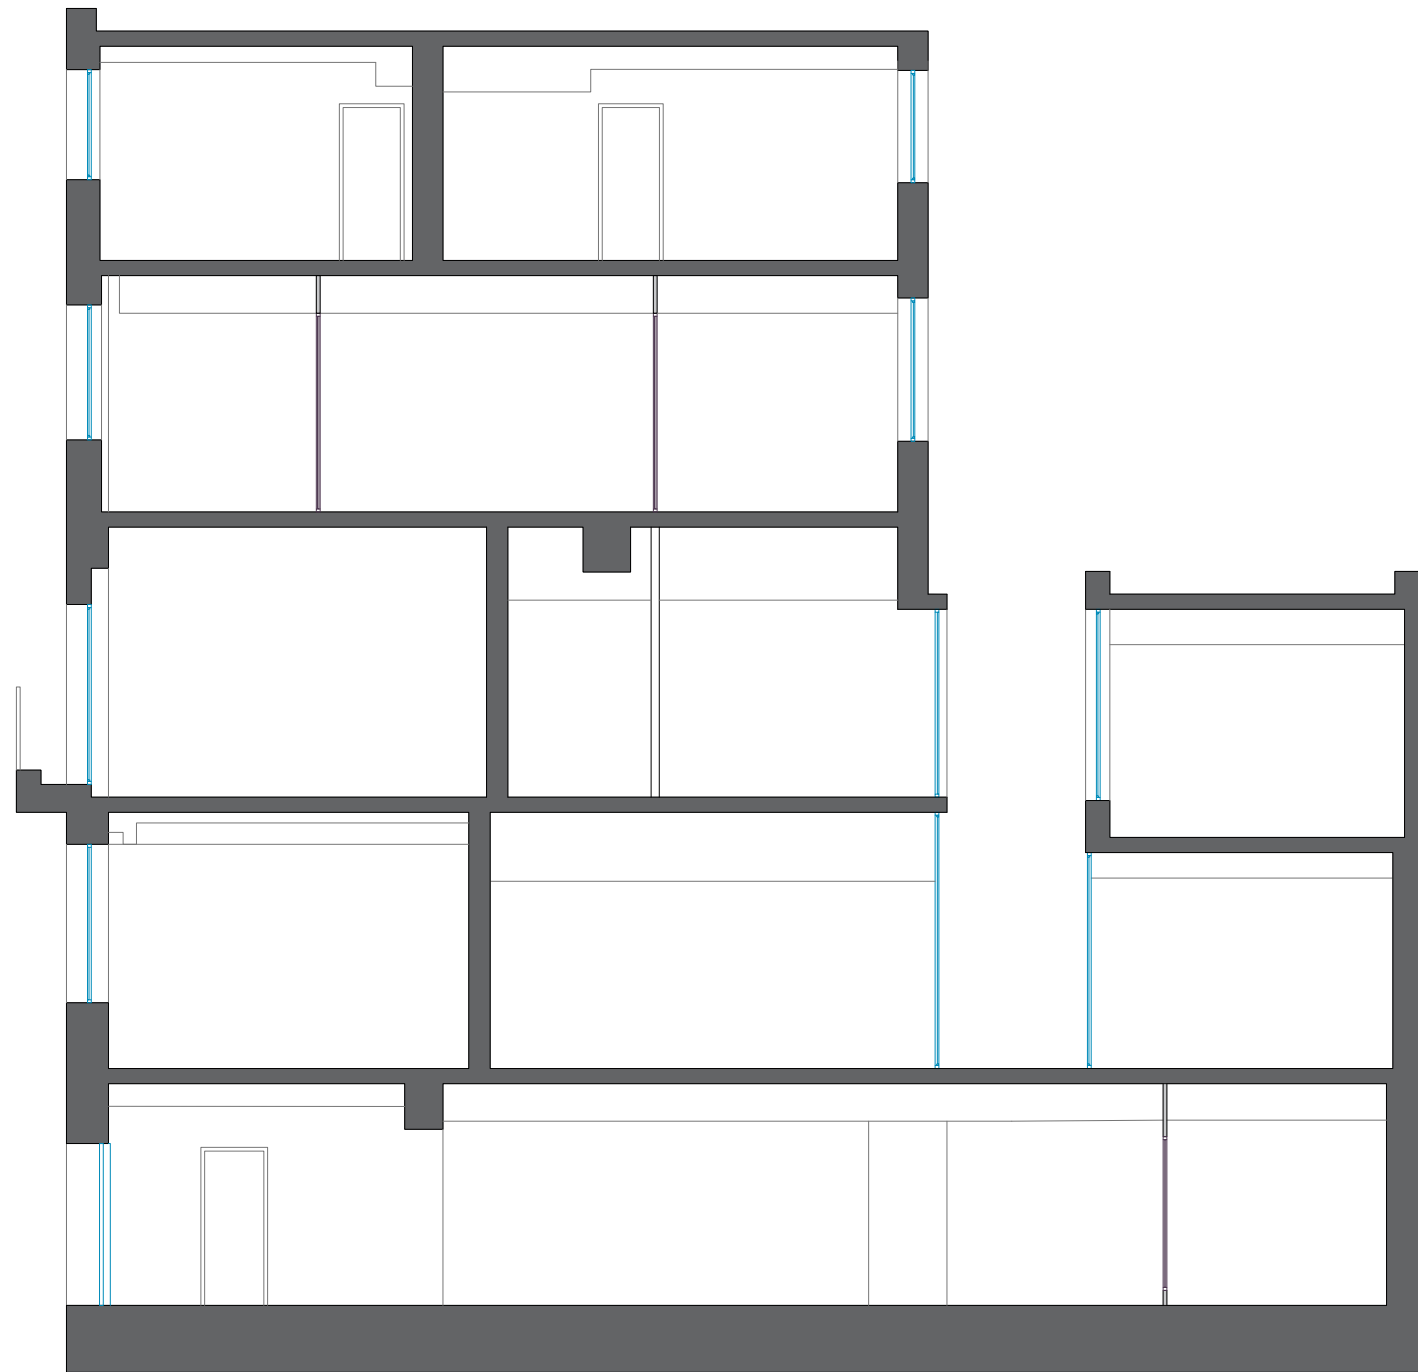

Section 2



Fitzroy Square

29-30 Fitzroy Square
London
W1T 6LQ


Drawing Name
Section 2

REFERENCES

Date	Revision	Project Number	Description	Rev
09/06/2025	00	25.05.3315	Property Survey	0/0

sterlingtemple

0203 4639225
www.sterlingtemple.com

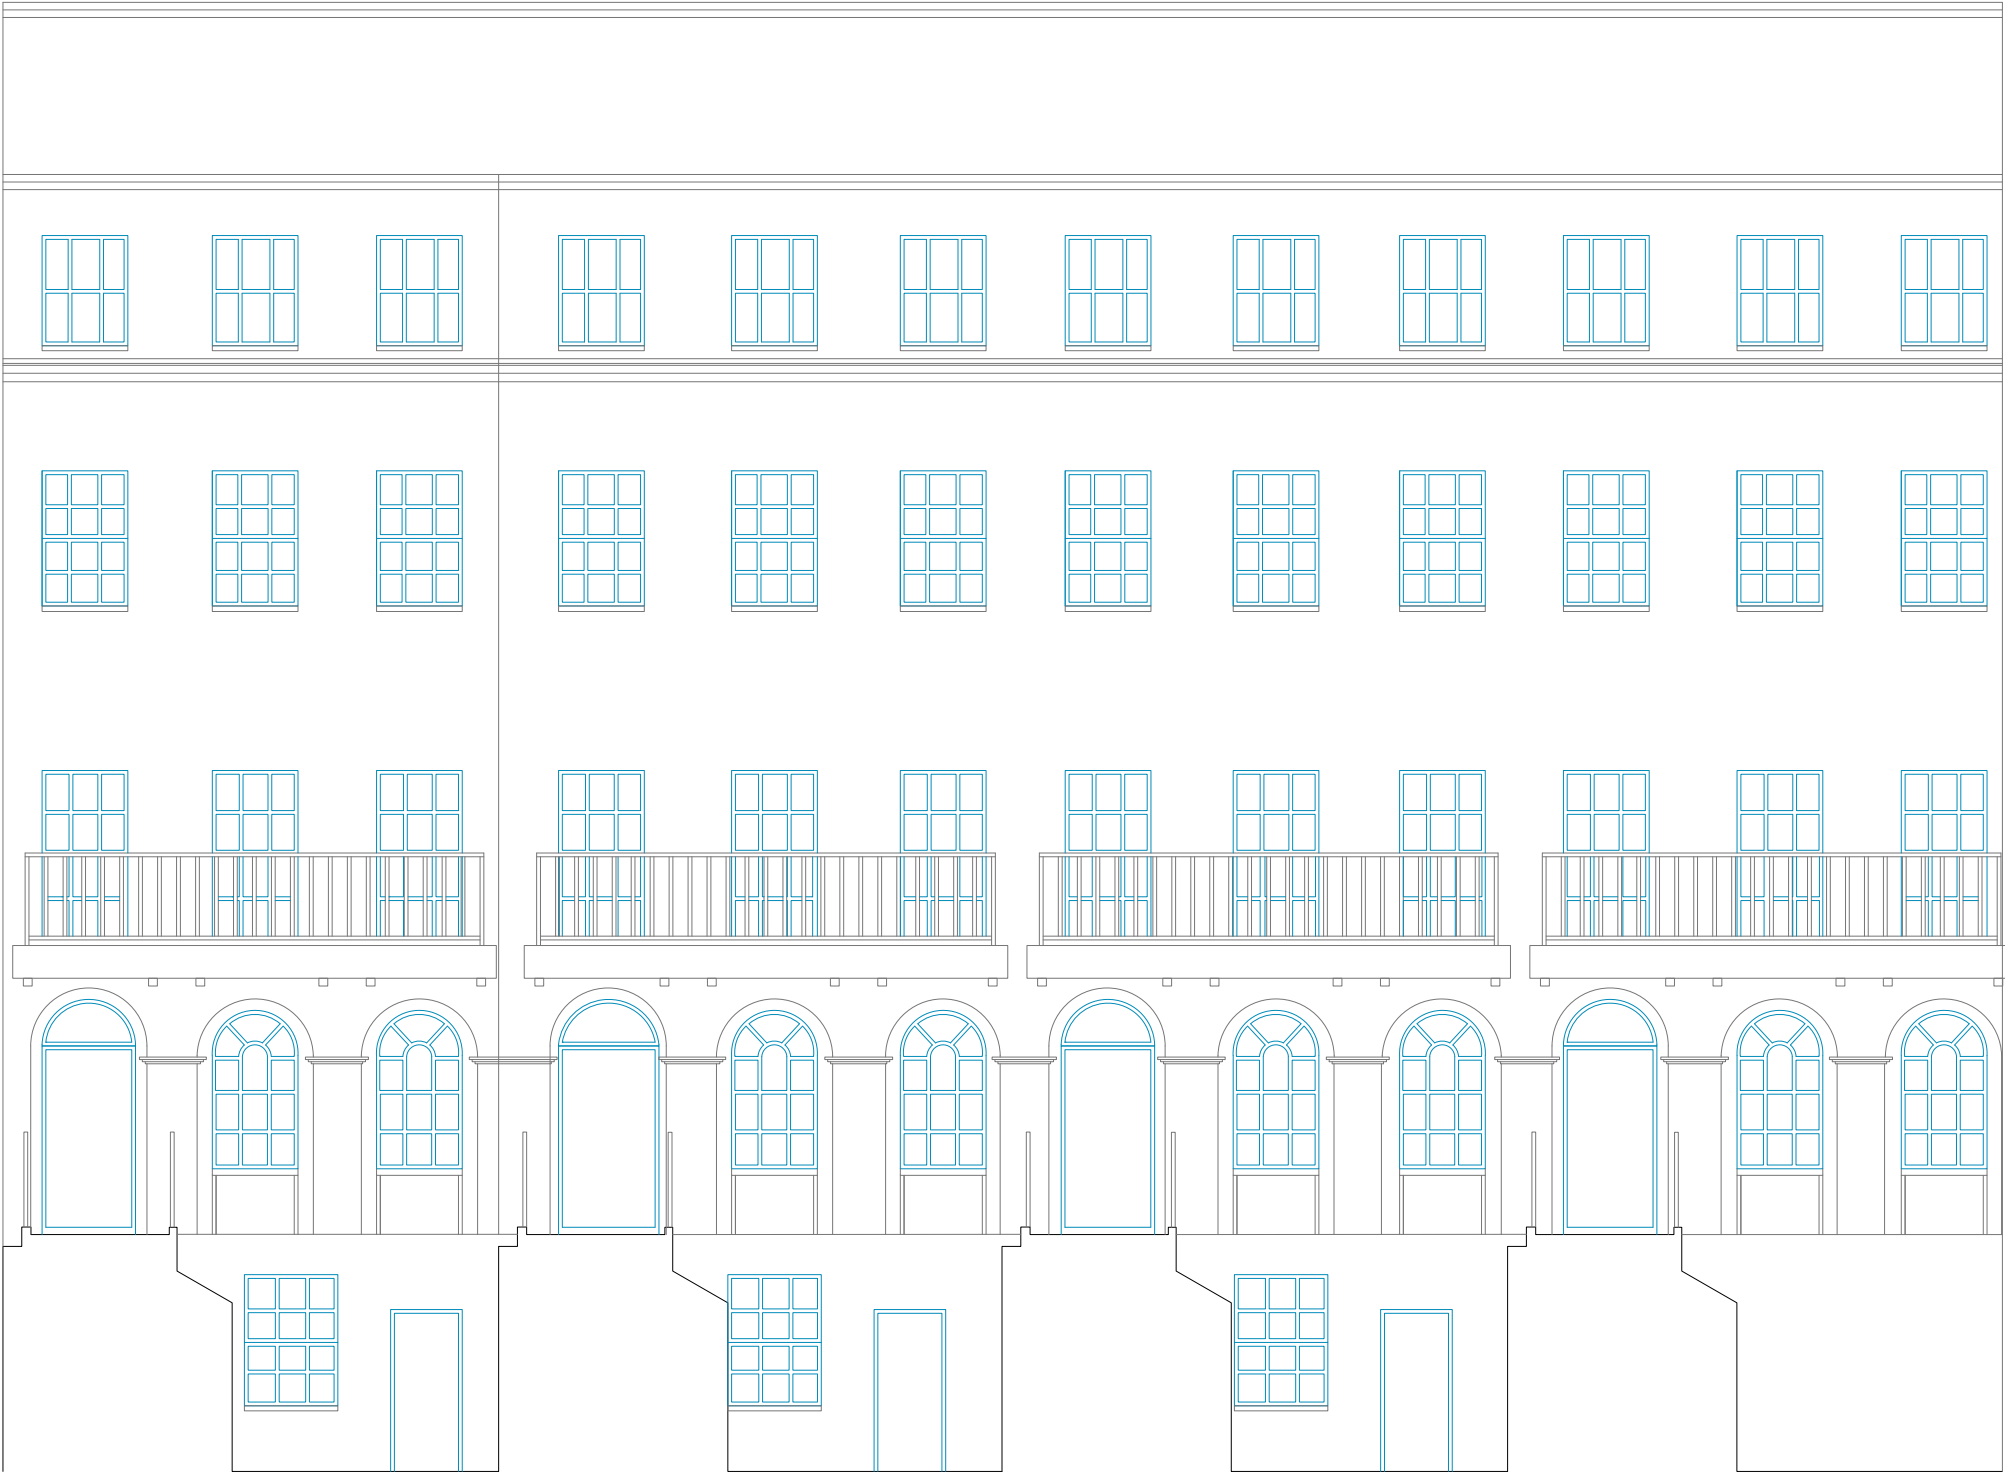

Front Elevation



Fitzroy Square

29-30 Fitzroy Square
London
W1T 6LQ


Date	Revision	Project Number	Description	Rev
09/06/2025	00	25.05.3315	Property Survey	0/0

Drawing Name
Elevation Front

REFERENCES

sterlingtemple

0203 4639225
www.sterlingtemple.com

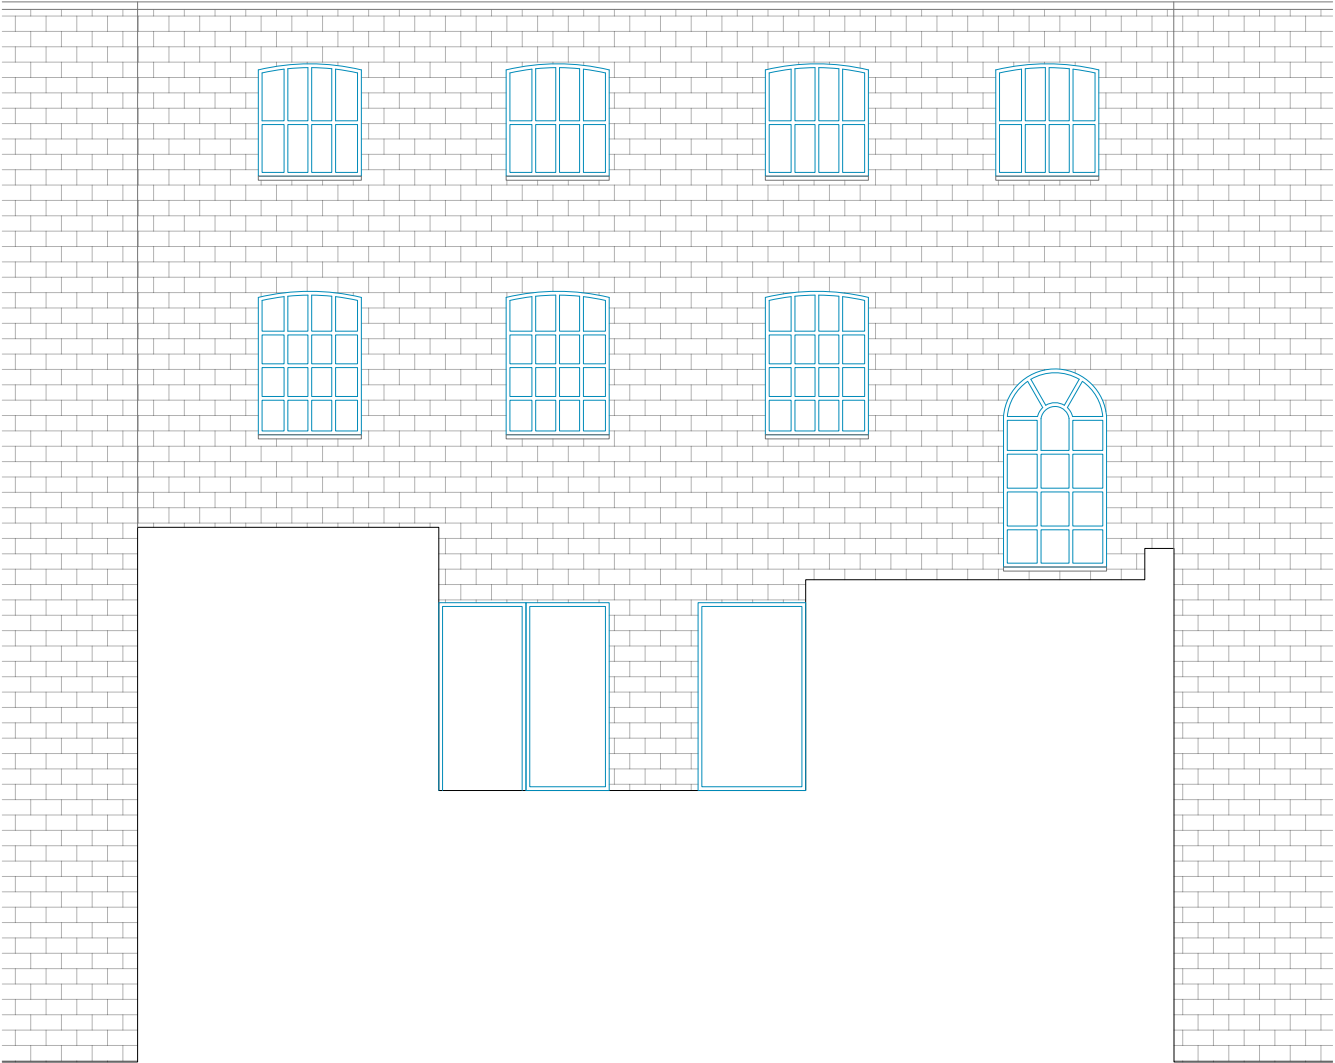

Rear Elevation



Fitzroy Square

29-30 Fitzroy Square
London
W1T 6LQ

Date	Revision	Project Number	Description	Rev
09/06/2025	00	25.05.3315	Property Survey	0/0

Drawing Name
Elevation Rear

REFERENCES

sterlingtemple

0203 4639225
www.sterlingtemple.com