



DISCLAIMER:
This drawing should not be scaled.
The contractor is to check all dimensions on site and inform the contract administrator/project manager of any discrepancies.
All work is to comply in every aspect with the Building Regulations, Codes of Practice and British Standards.
This drawing is to be read in conjunction with all other contract drawings and specifications.
This drawing is copyrighted and must not be reproduced in any format or disclosed to any third party without the written consent of Tuffin Ferraby Taylor (TFT) Ltd.

REV	REVISION	DATE	PROD	CHKD
-	-	-	-	-

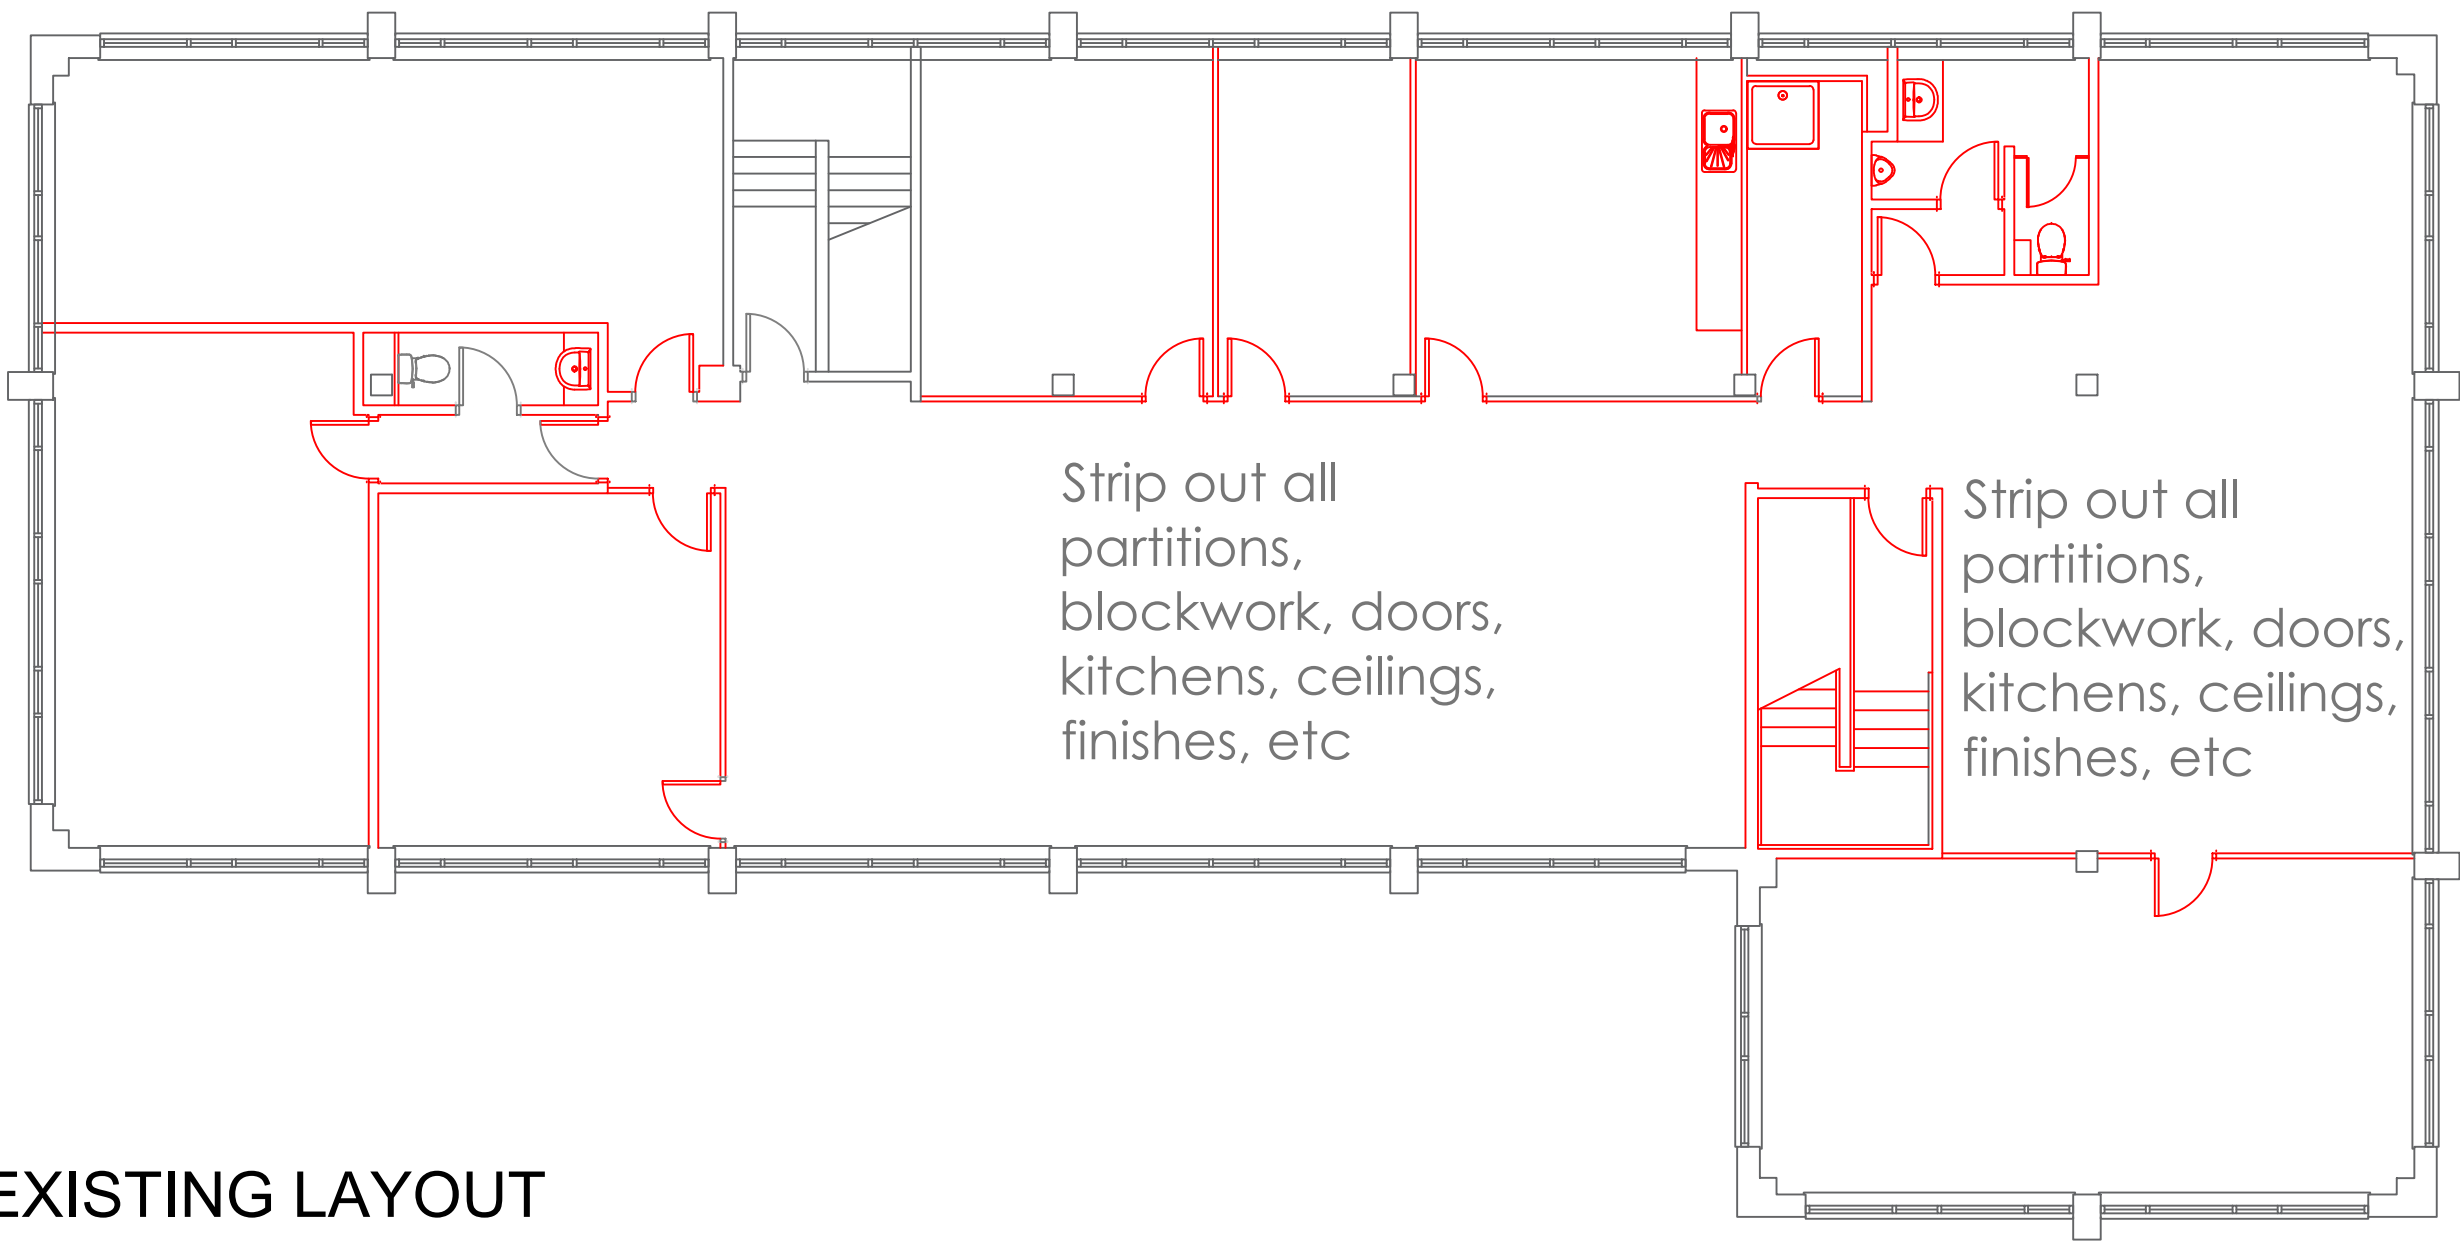

EXISTING LAYOUT

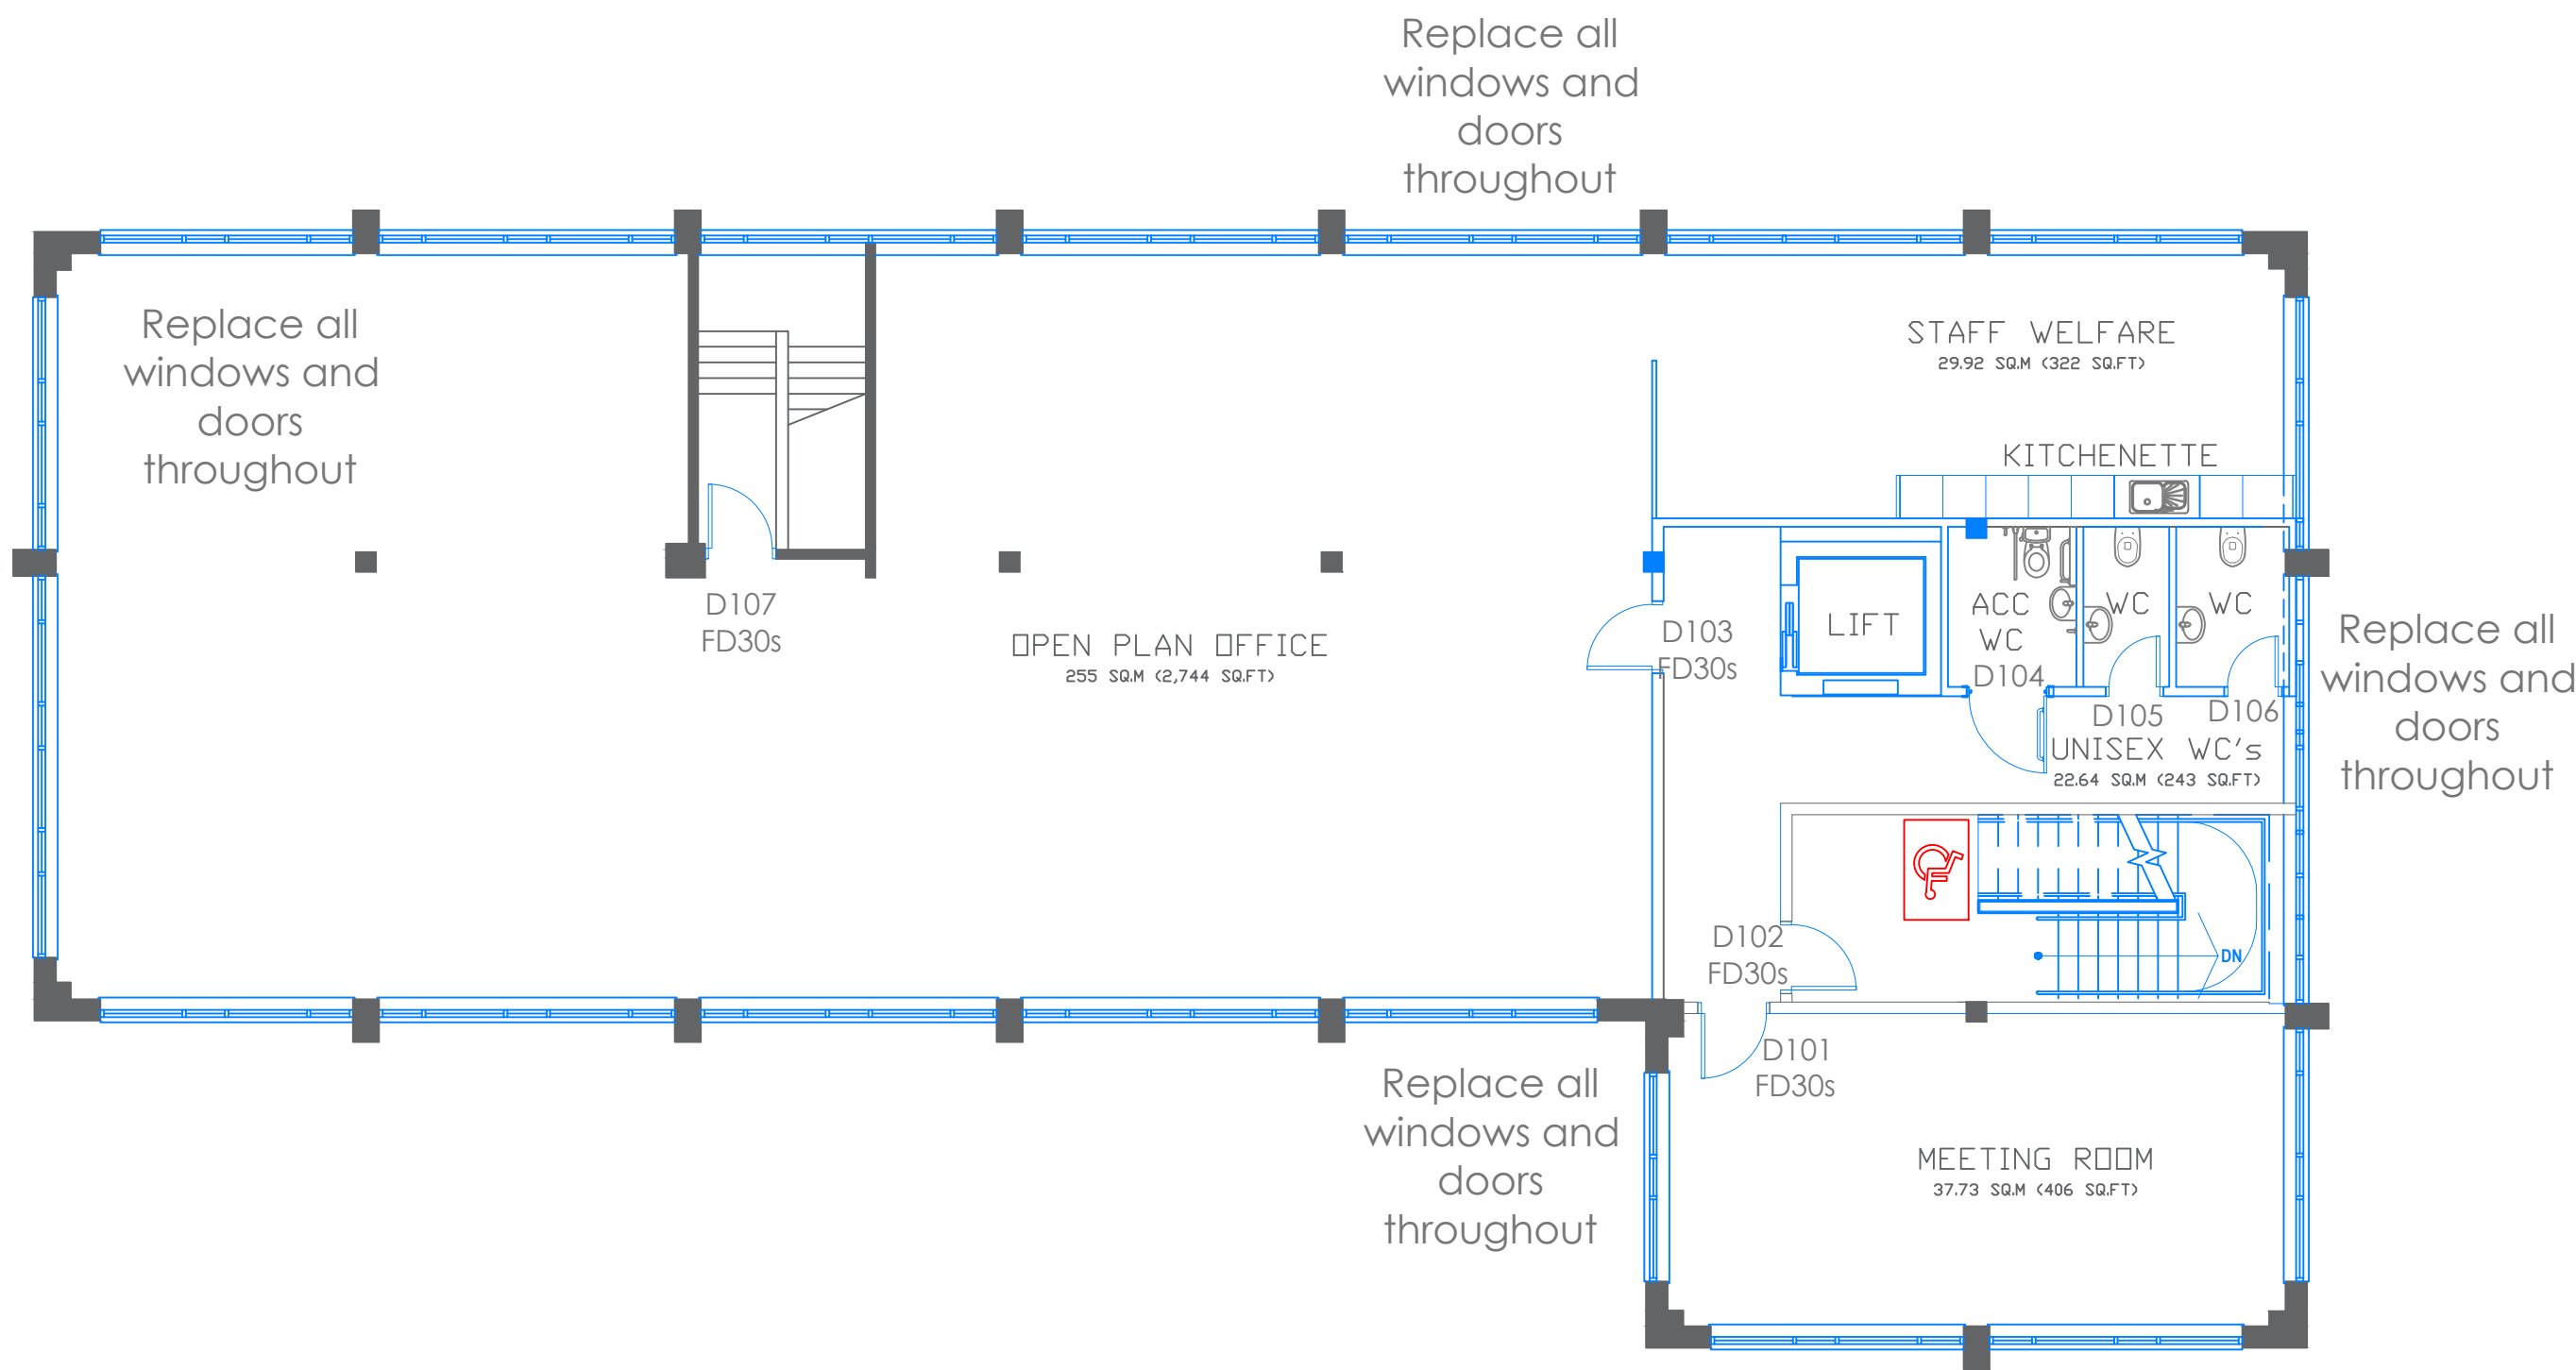

PROPOSED LAYOUT



The Spaces Building
4500 Parkway, Whiteley
PO15 7AZ

t: +44 (0) 20 3479 77 77
e: enquiries@tftconsultants.com
w: www.tftconsultants.com

CLIENT	Aviva Investors		
PROJECT	Unit 22 Nursling Industrial Estate Oriana Way, Nursling Southampton SO16 0YU		
DRAWING	First Floor Office		
DRW NO	240378-07	REV	-
DATE	June 2024	DRAWN BY	DB
SCALE	1:100	SIZE	A1