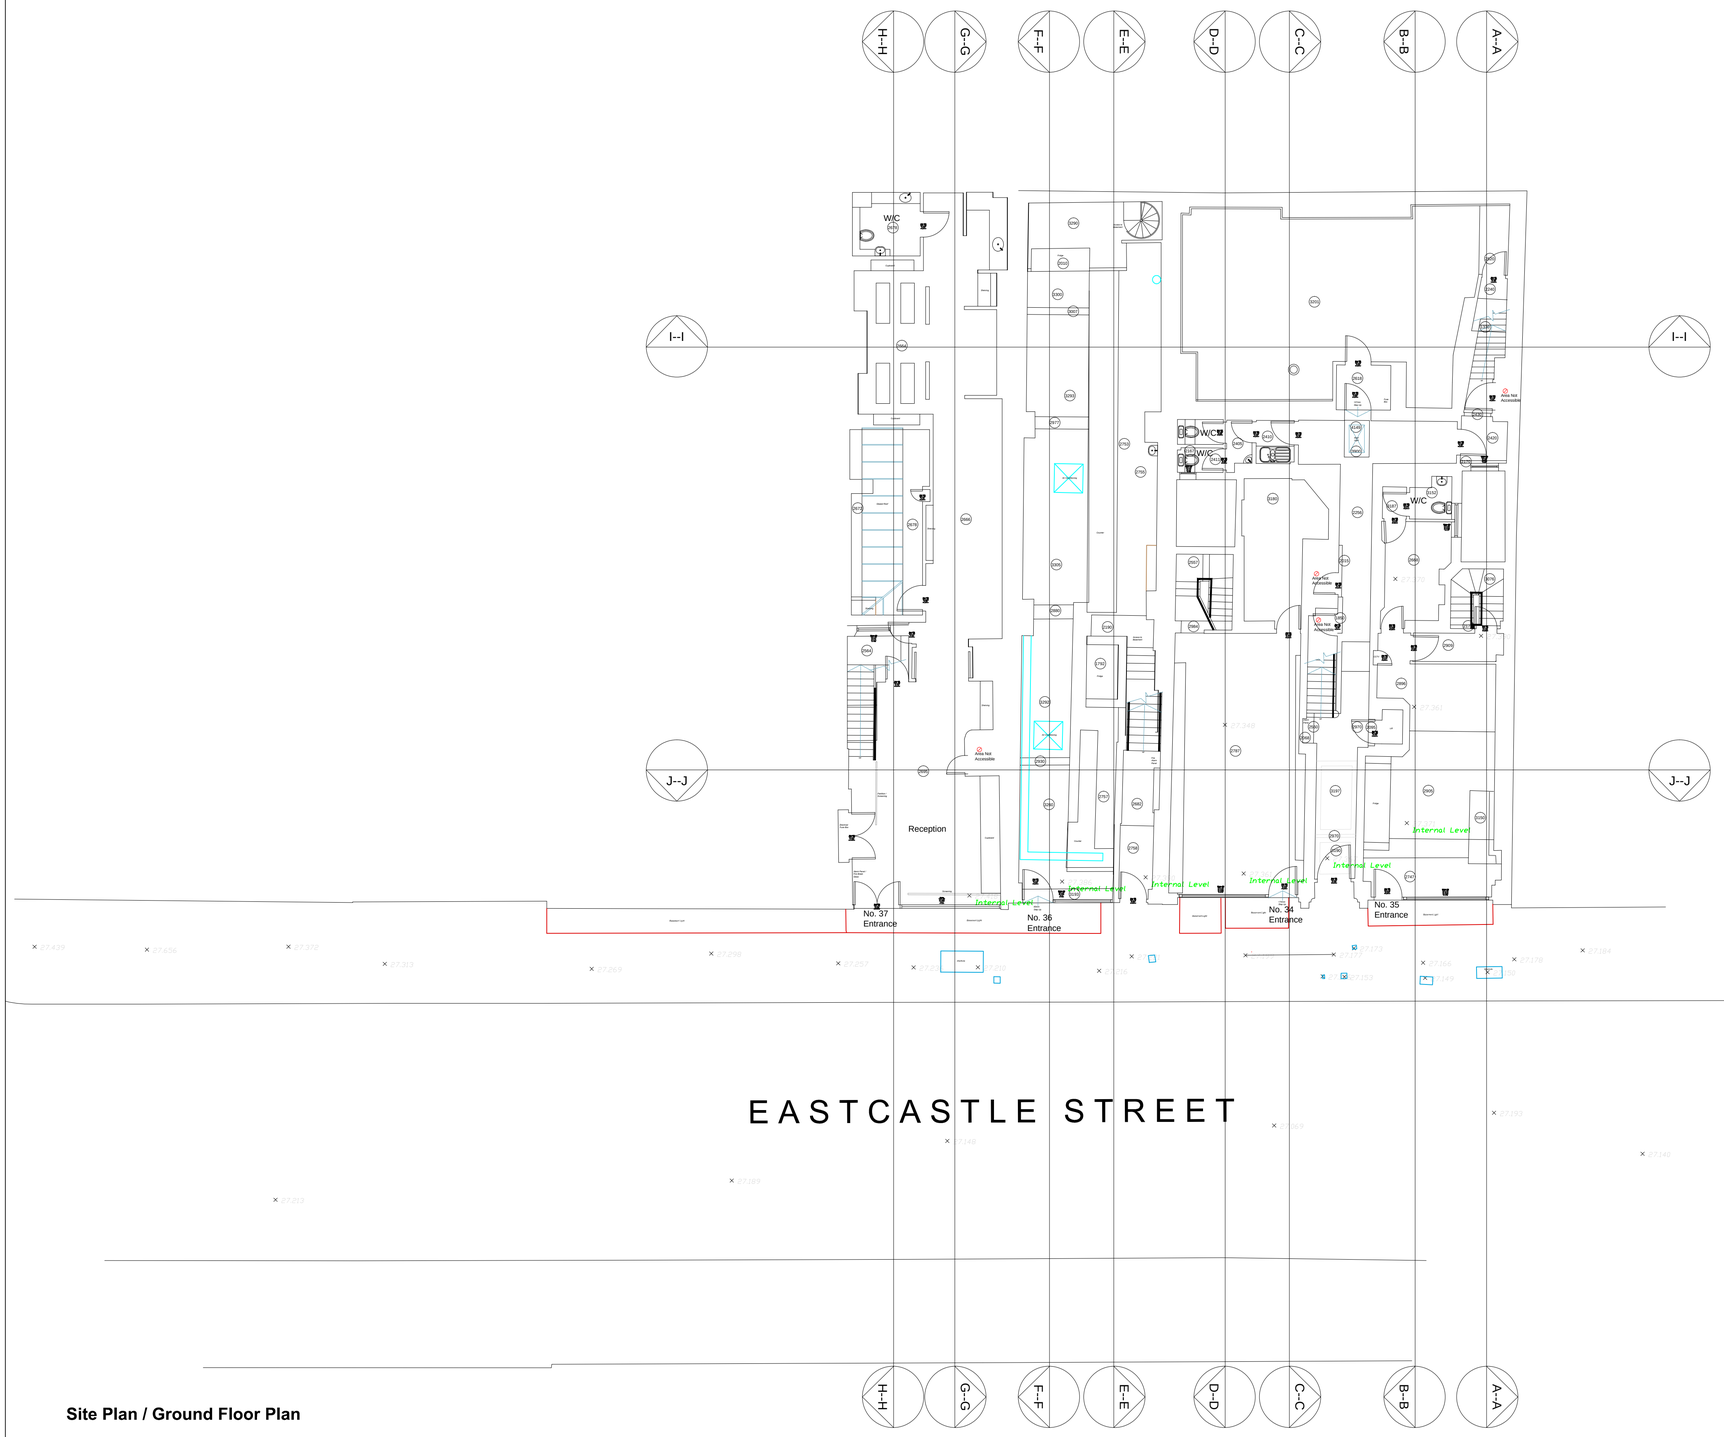

Site Plan / Ground Floor Plan

This drawing is to be read in conjunction with all relevant specifications and drawings issued.
For discrepancies or omissions contact Mobile CAD Surveying Ltd prior to work commencing.
The contractor is to check and verify all building and site dimensions and levels before work commences.

©COPYRIGHT Mobile CAD Surveying Ltd 2011

DO NOT SCALE THIS DRAWING - CHECK ALL DIMENSIONS ON SITE

SITE KEY

Room 001
Room Description
100.000 sq m ----------Room Area (m)
1076.391 ft2 ----------Room Area (ft)
2.000 m ---------- Room Height
200.000 m3----------Room Volume
40.000 m ----------Room Perimeter
Floor Finish ----------Floor finish
(H=Hard, M=Medium, S=Soft)

Abbreviations:
SM Format (HH, OH, SH, W)
HH = Floor to Head Height
OH = Opening Height
SH = Floor to Sill Height
W = Width of opening
CH = Ceiling Height from Floor Level
U/S = Underside
U/B = Underside Beam

Rev	Date	Amendments

Mobile CAD office & on site... Surveying™

Tel: 0844 567 2609
sales@mobilecadsurveying.co.uk
www.mobilecadsurveying.co.uk

Project
Building Survey

Address
33-37 Eastcastle Street,
London,
W1W 8ET

Drawing No:	02		
Drawing Title:	Ground Floor Plan		
Drawing Date:	April 2014		
Drawing Size:	1:100	@ A1	Issue