
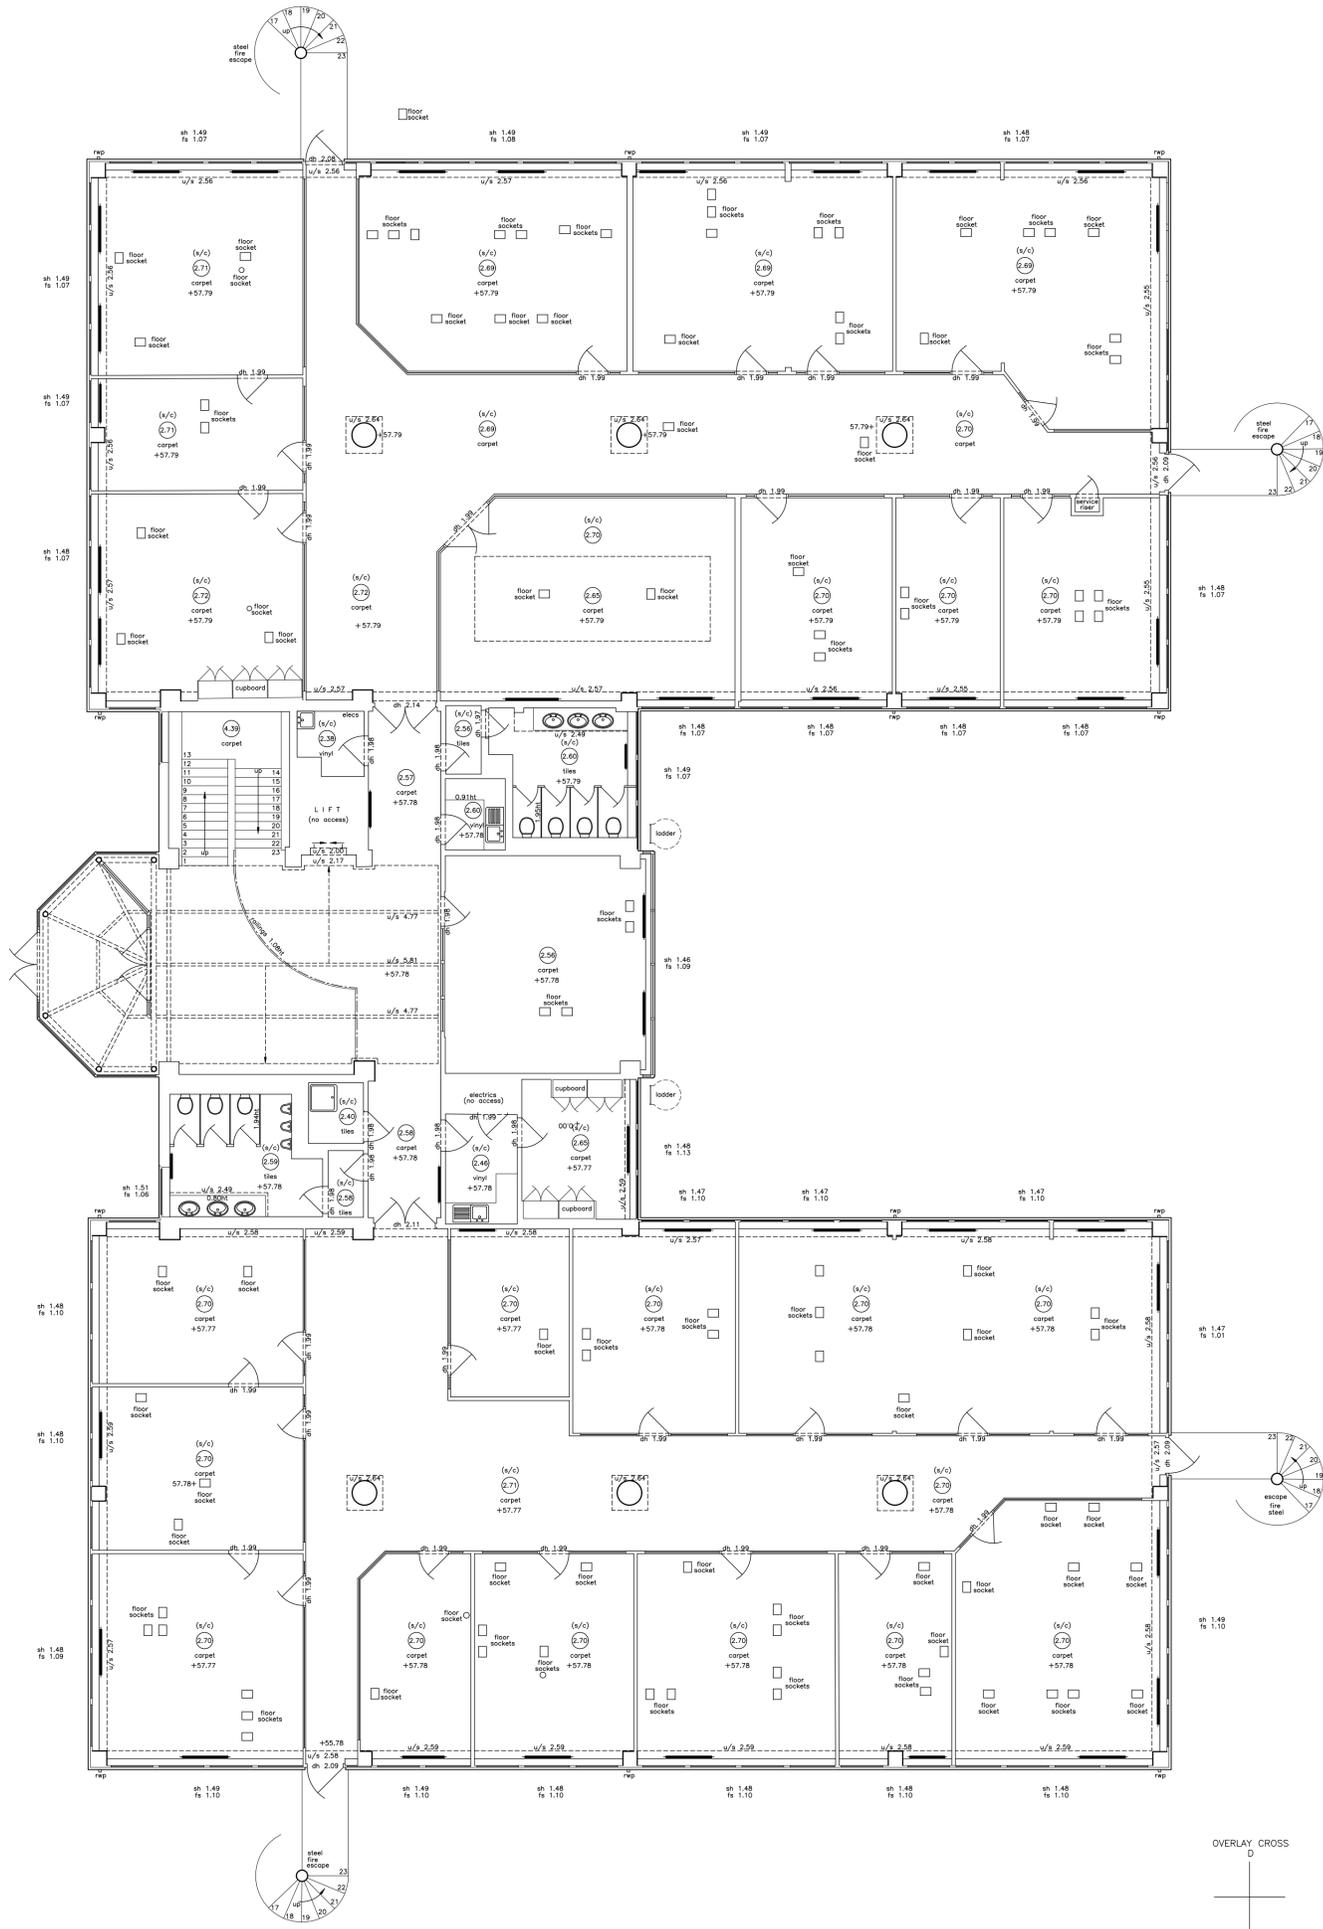
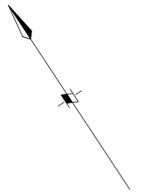
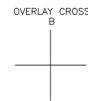





Notes

ALL LEVELS ARE IN METRES DERIVED FROM GPS TRANSFORMA OSGM15
THE CO-ORDINATES ARE DERIVED FROM THE ORDNANCE SURV

- sh sill to head height
- fs floor to sill height
- u/s underside height
- t/s topside height
- fb floorboard direction
- conc concrete
- rl roof light
- cup'd cupboard
- fp fireplace
- sd sliding door
- svp soil and vent pipe
- rwp rain water pipe
- carpet
- ⊙ (3.17) room height
- roof slope
- ▬ radiator

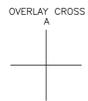

FIRST FLOOR PLAN

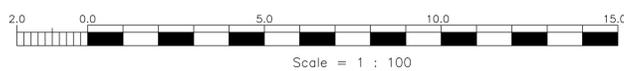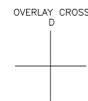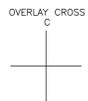

RW/RRJ © ON CENTRE SURVEYS LTD. 2025

job **SETON HOUSE**
WARWICK TECHNOLOGY PARK
GALLOWES HILL
WARWICK
CV34 4DA

client **WAREING & COMPANY**
on behalf of
SCHROEDERS

title	dwg no.
FIRST FLOOR PLAN	24052B-2

scale	date
1/100	NOVEMBER 2025

ON-CENTRE SURVEYS L
LAND & BUILDING SURVEYORS
GEODETIC ENGINEERS
2 CHARLES COURT, BUDSROOKE ROAD, WARWICK CV34
TEL: 01926 494294
E-MAIL: info@oncentre.co.uk
A member of The Survey Association