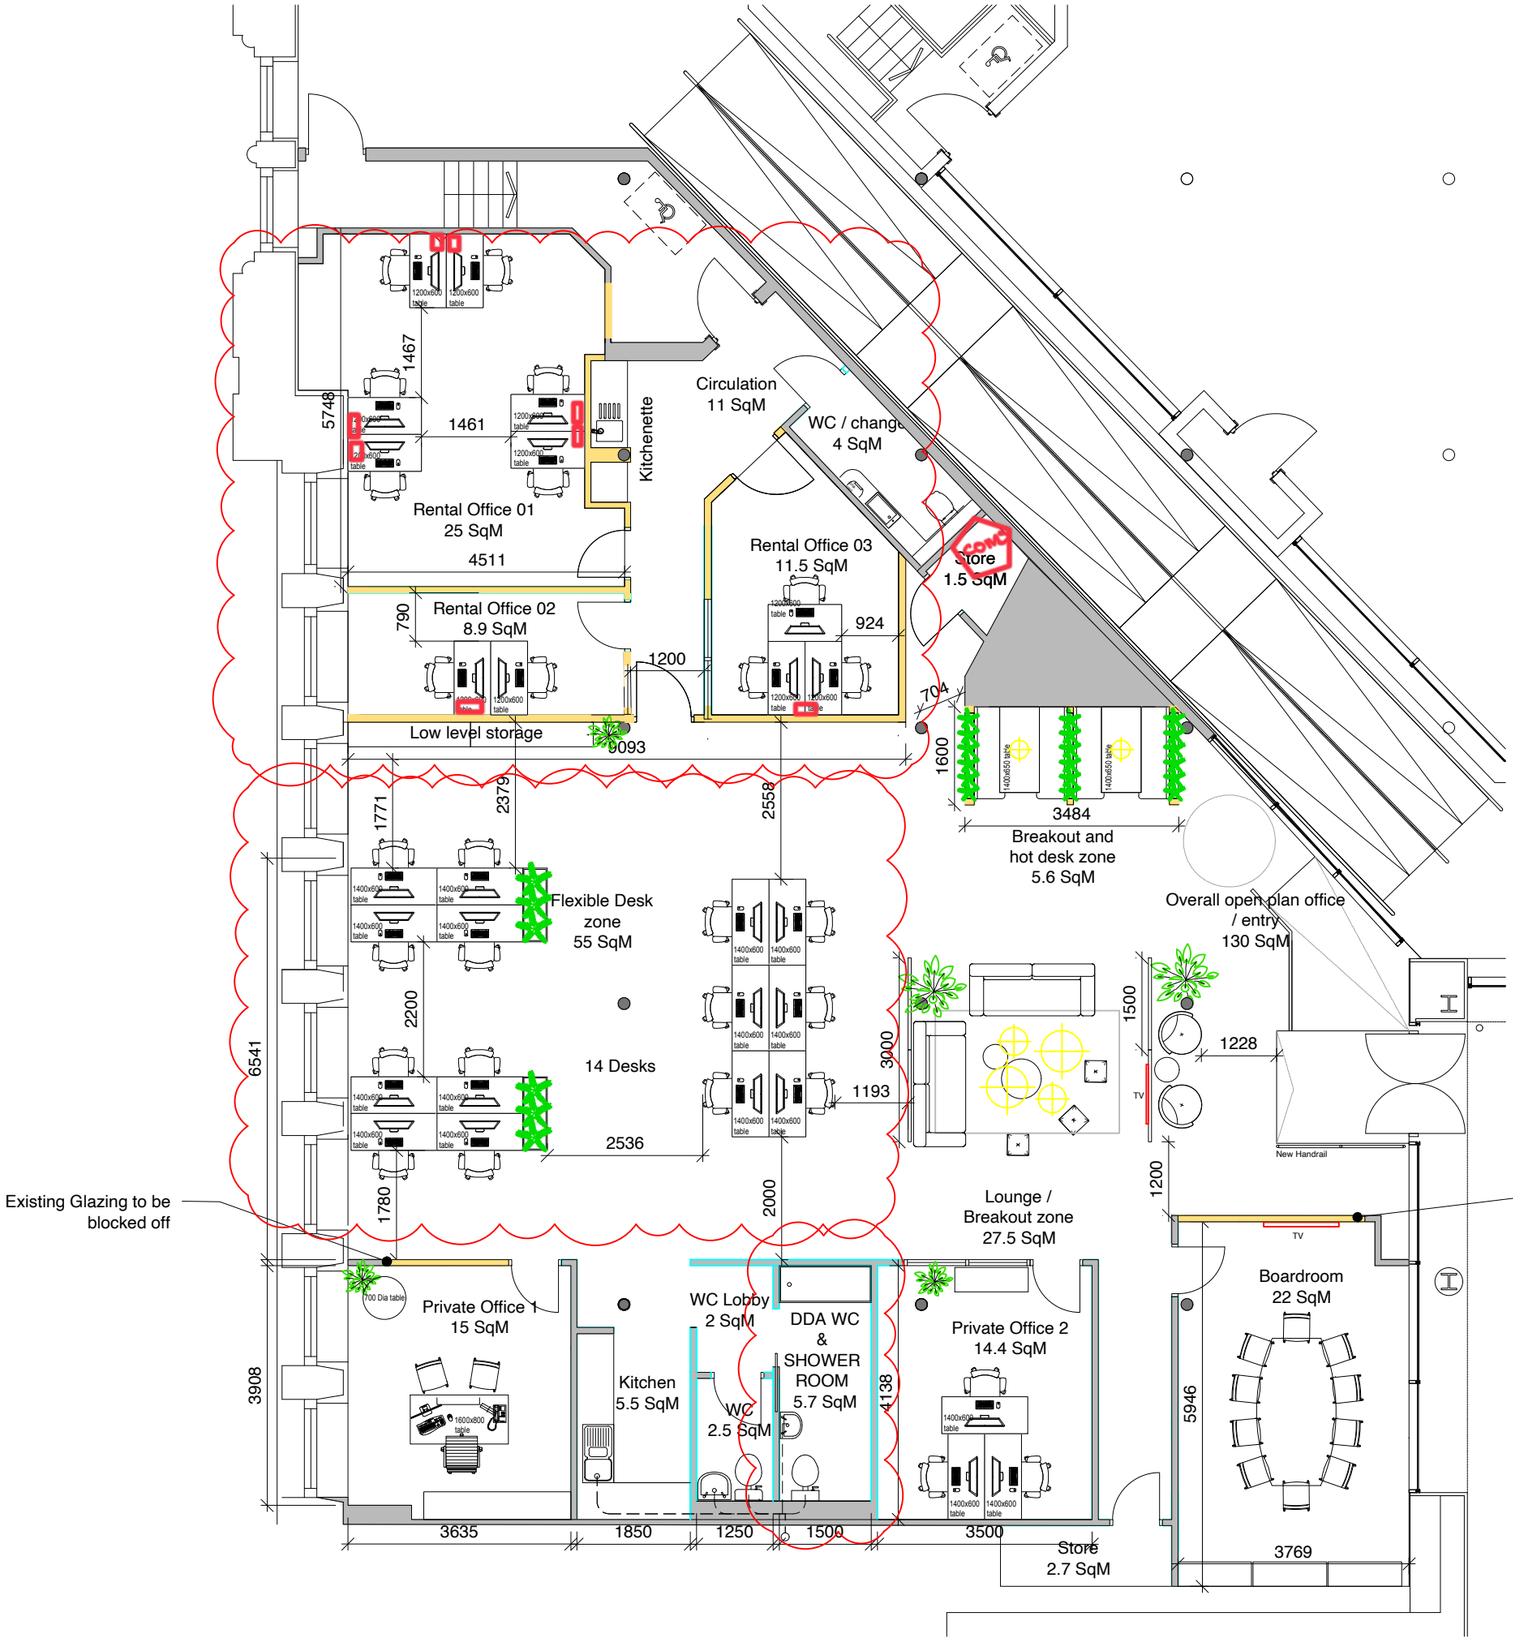


Notes

Do not scale from this drawing all dimensions to be checked on site and Designer / architect notified of any discrepancies
copyright reserved.

Studio So Ltd. owns the copyright of this drawing, which must not be reproduced in whole or part without the written permission of Studio So.

All dimensions are in millimeters unless indicated. Contractor to check all dimensions prior to commencing work onsite & adopt responsibility for dimensional accuracy prior to works.

Drawing to be read in conjunction with all relevant information. Any discrepancies found between information on this drawing, given elsewhere or recorded onsite shall be reported to Studio So immediately.

rev:	date:	description:	dm:	chk:	apd:
G	21.01.25	New partition wall moved to reduce rental offices in size. Kitchenette recessed into wall.	AV		
F	14.11.24	Glazing blocked up in Boardroom and private office 1	AV		
E	06.11.24	Built in booths added. Boardroom table updated. Table added in private office	AV		
D	25.10.24		AV		
C	07.10.24	GA update following site visit.	AV		
B	20/09/24	GA update following site strip out works. per Area Sqm added			

client: Wonderworld Group

project: WW HQ Office

INFORMATION

stage: /

title: Proposed GA

scale:		first issue:	drawn:	checked:	approved:
1:100	A3	17.06.24			

project no: 2231

drawing no: AL(20)001

rev: G

Studio So Design Ltd
Suite 2, 39 Commercial Street
Leith, Edinburgh
EH6 6JD
www.studio-so.co.uk