


$S = 686,35 \text{ mp}$

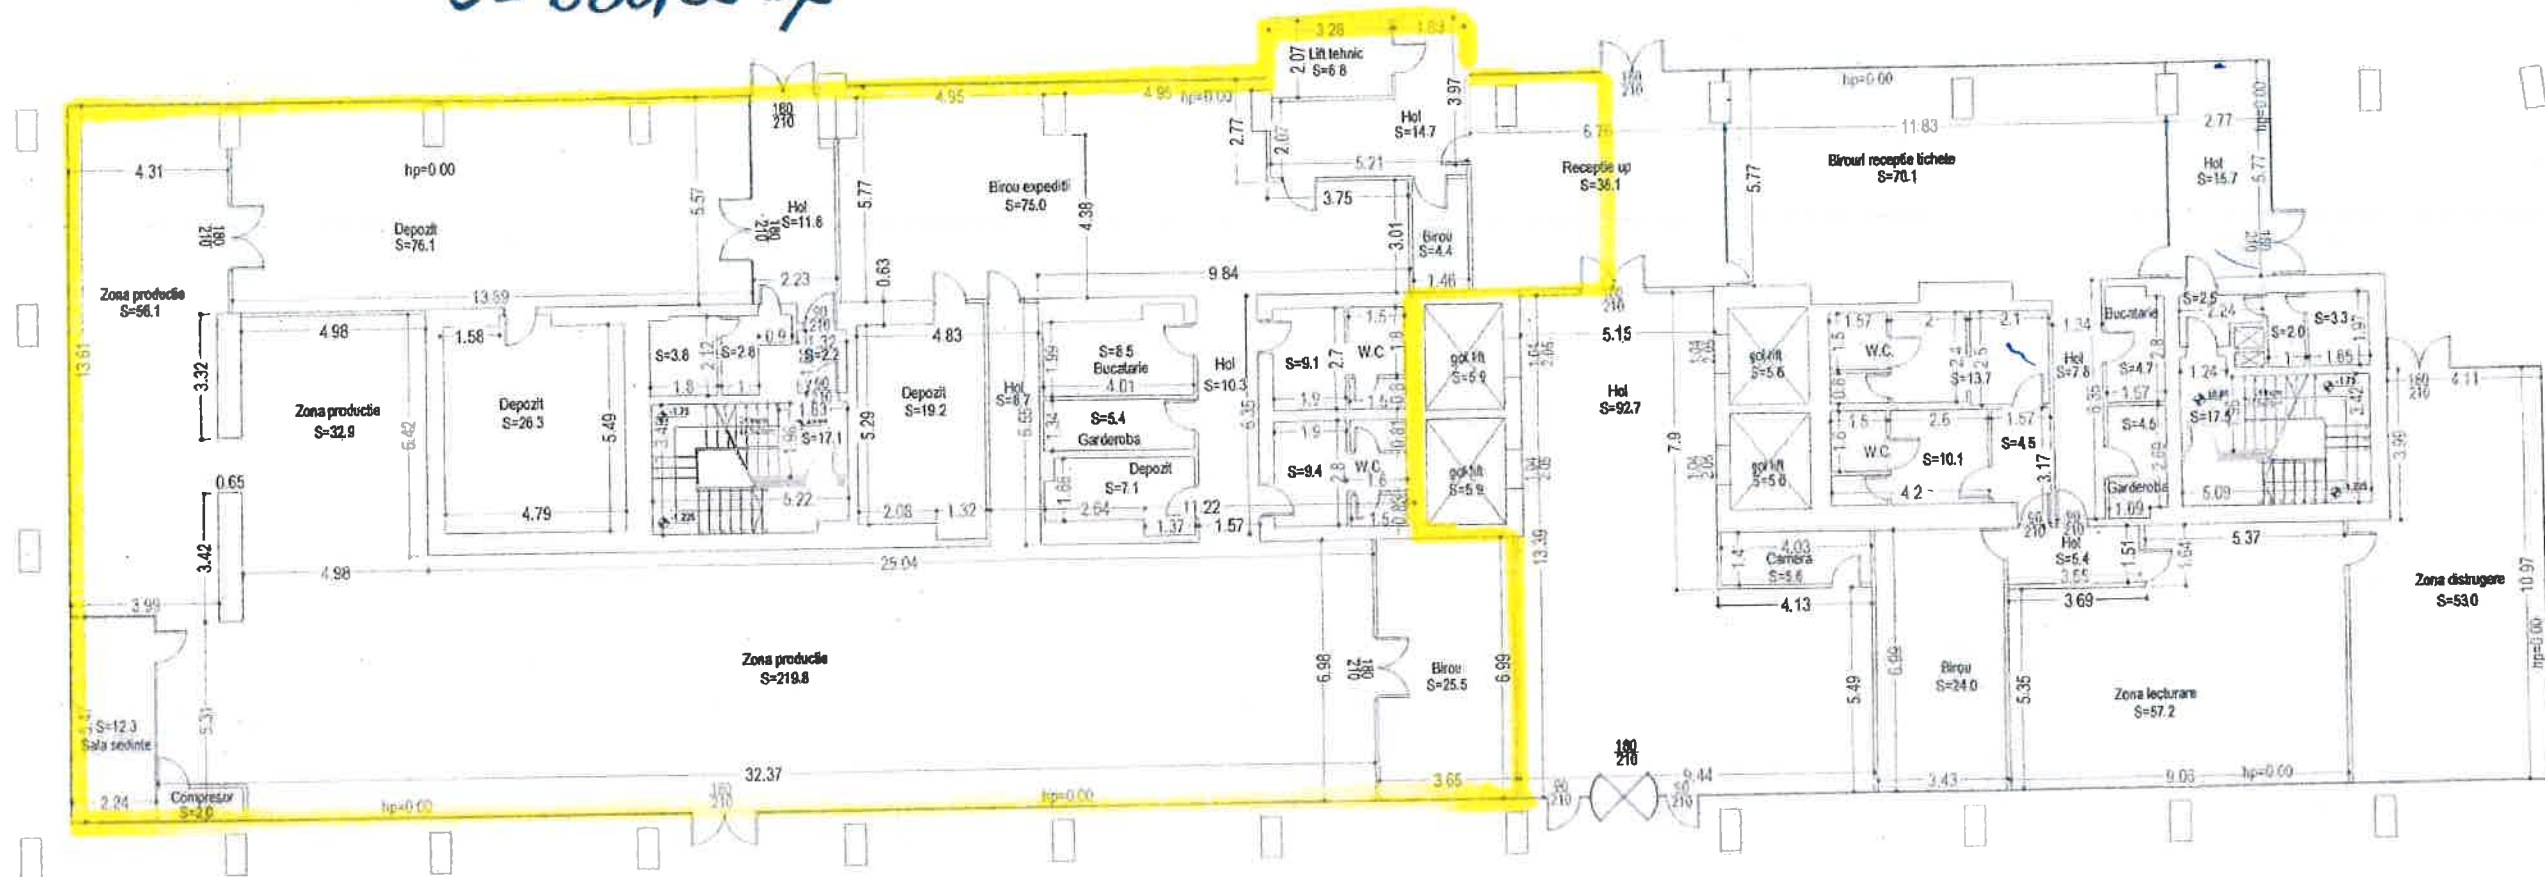

Suprafetele incaperilor reprezinta suprafetele utile calculate in m.p.
 Suprafata construita desfasurata parter (include stalpii exteriori)=1437.8 m.p.
 Suprafata utila parter (nu include lifuri si scari)=1058.3 m.p.

Doru-Alexandru Sarchis
 Doru-Alexandru Sarchis
 RO-B-F NR.0357
 2021.04.27 09:04:59 +03'00'

 Doru-Alexandru Sarchis Ing. Doru Sarchis Ing. Doru Sarchis Ing. Doru Sarchis Ing. Doru Sarchis Ing. Doru Sarchis		SCARA 1:100 DATA Apr 2021		PLANSA 1 COMANDA 181
PROIECTAT DESEINAT VERIFICAT REF. COLECTIV APROBAT		RELEVU PARTER Str. Oudina-Pavilion nr. 12 sector 2 Bucuresti Serviciu: P.M.P.S BUSINESS PARK		