


Employer
 Nine Elms Property Limited

Contractor
 Multiplex Construction Europe Limited

Architect
 Kohn Pedersen Fox Associates
 Architects & Planning Consultants
 7a Langley Street, Covent Garden
 London, WC2H 9JA
 Tel: +44 (0) 203 119 5300 Fax: 020 7497 1175

--- SITE BOUNDARY

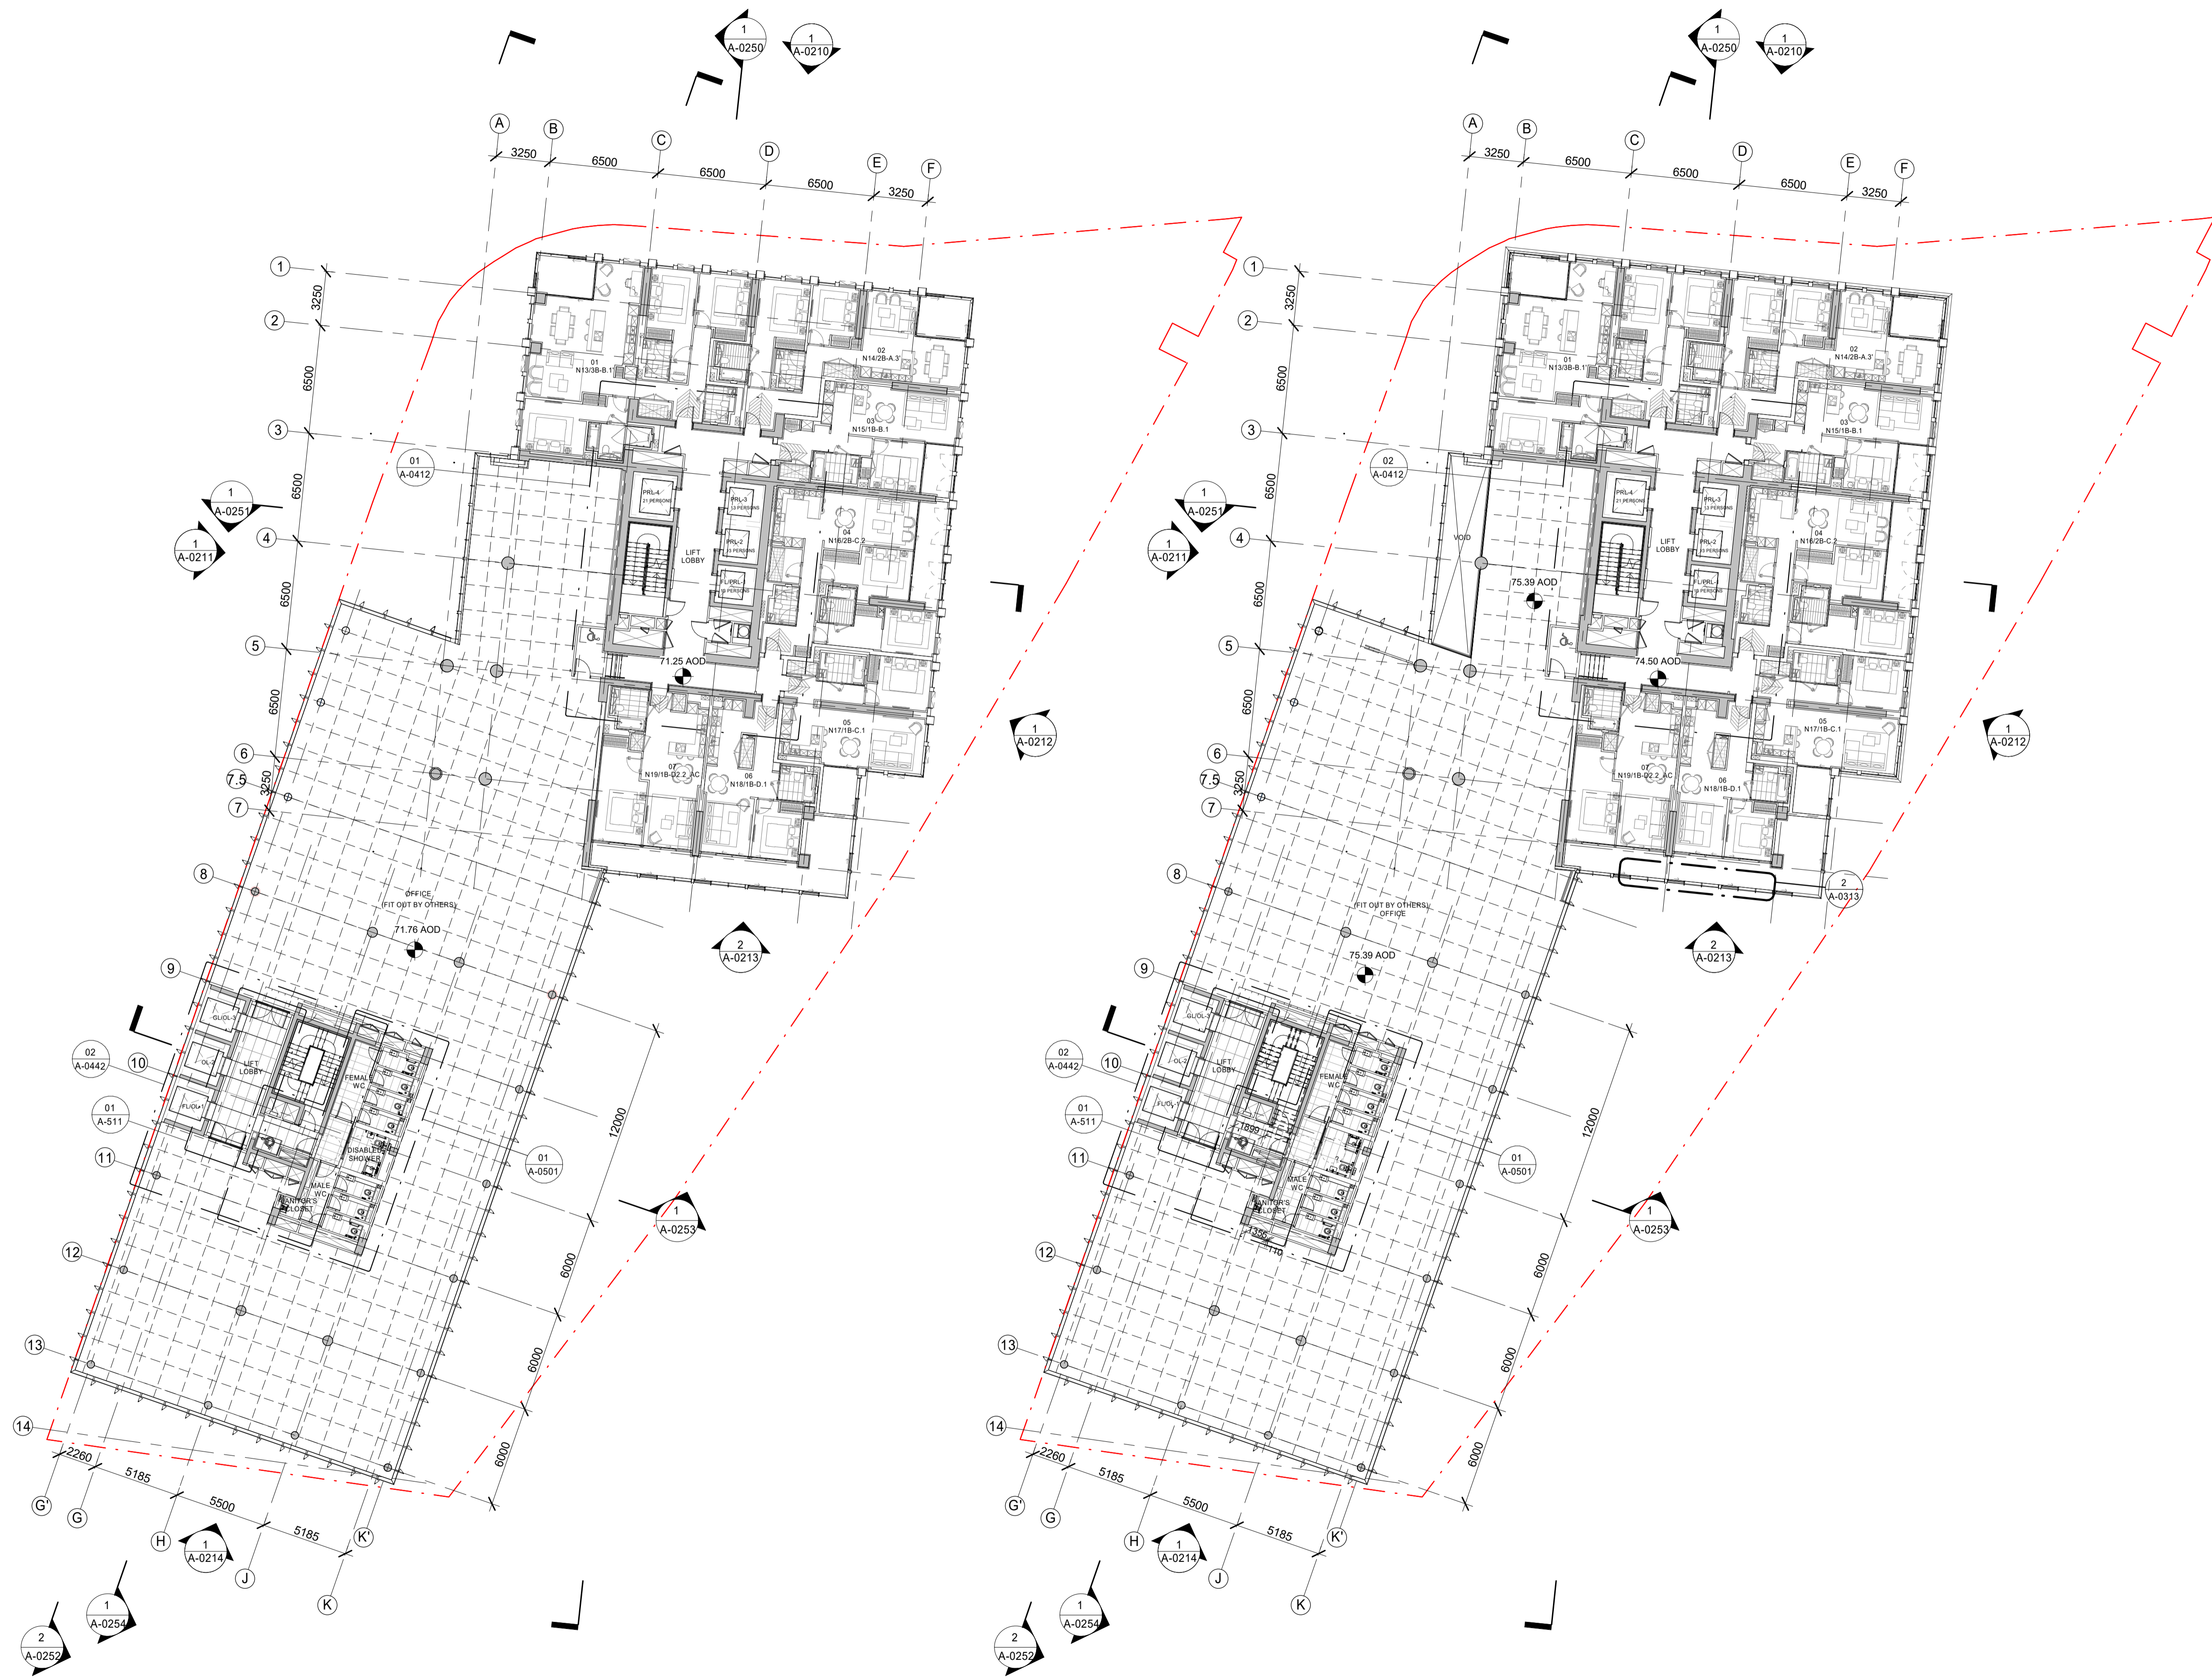


1 LEVEL 20 NORTH TOWER - LEVEL 21 SOUTH BUILDING (VARIES)
 SCALE: 1:200

2 LEVEL 21 NORTH TOWER - LEVEL 22 SOUTH BUILDING (VARIES)
 SCALE: 1:200

RE1	Record Information	19.10.2021
No.	Issue	Date

Key Plan

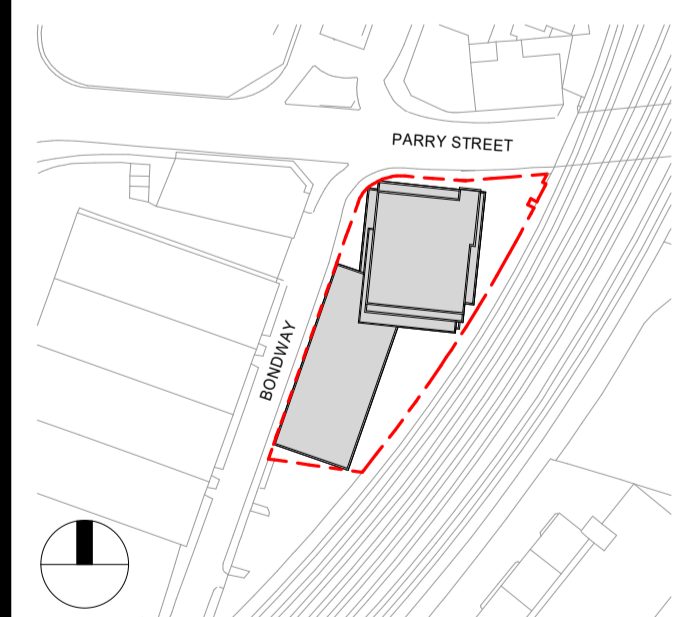

Date
 03.02.2014
 Scale
 As indicated @ A1
 Project No.
 2215
 Drawn by
 NY

**LEVEL 20/21 NORTH
 TOWER - 21/22 SOUTH
 BUILDING**

No. _____ Rev. _____
ALO-KPF-20-ML-PL-A-0112 RE1