



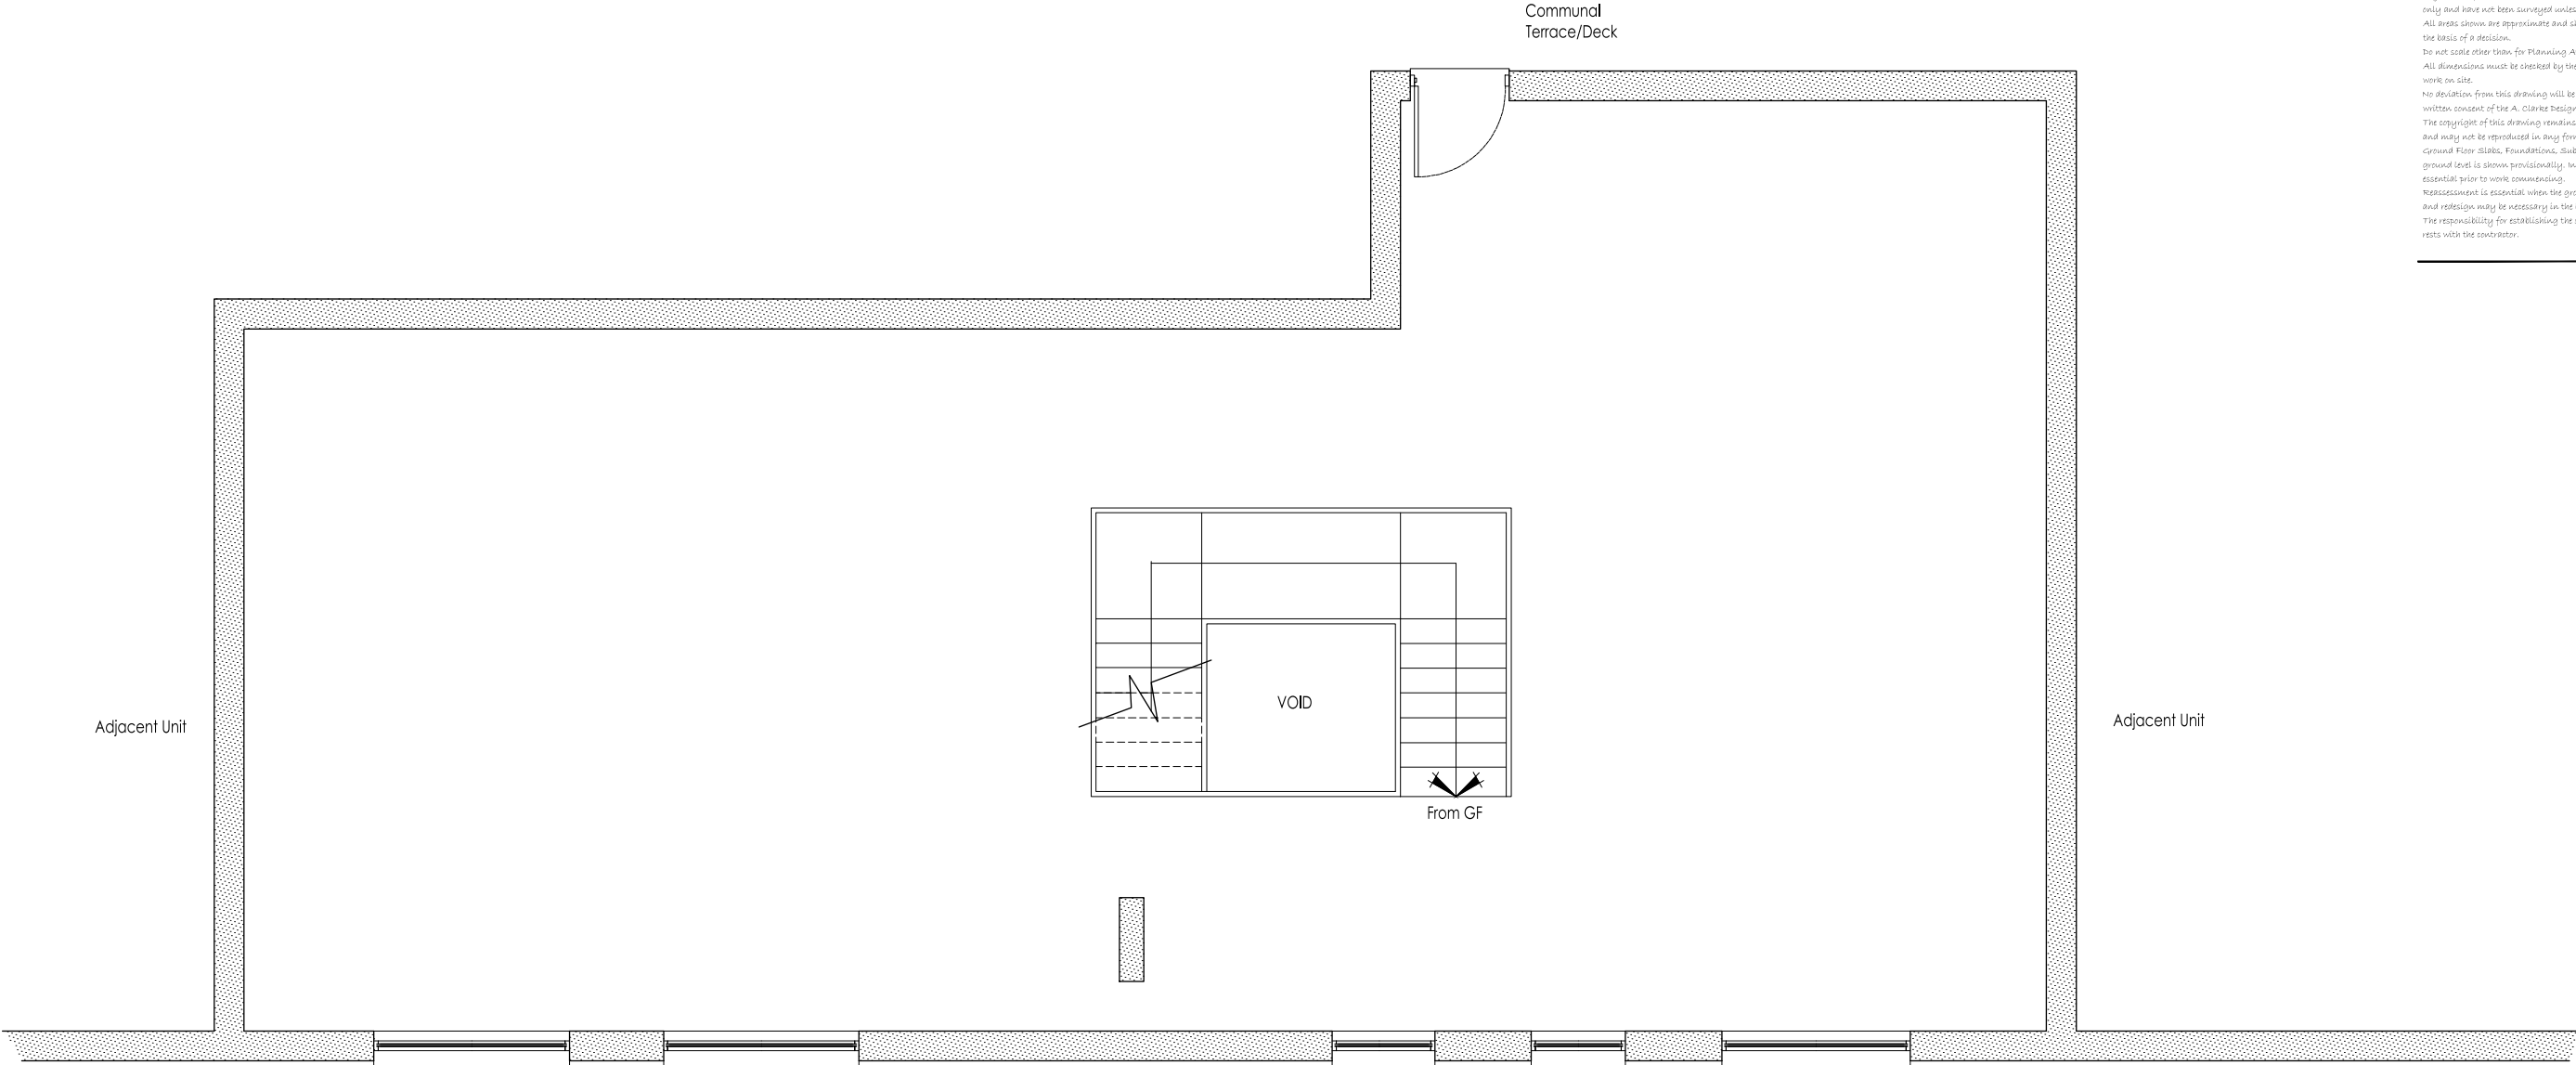

Proposed First Floor Plan - (131m² GIA)

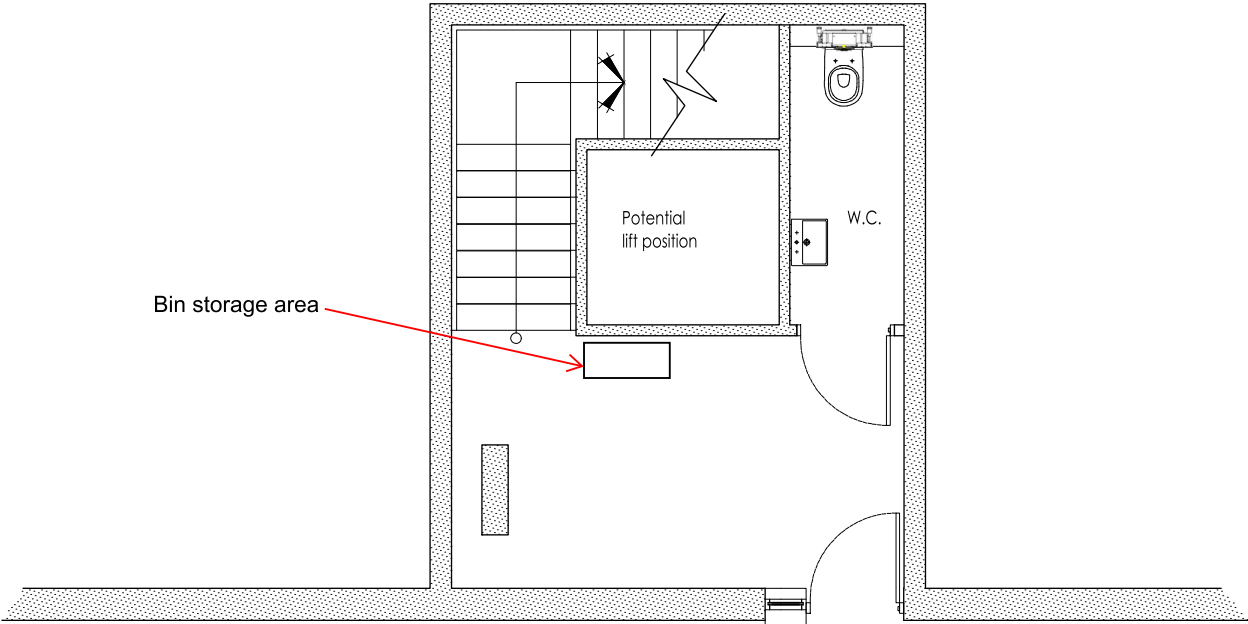

Proposed Ground Floor Access - (22.4m² GIA)

Notes:
Adjacent Properties and Boundaries are shown for illustrative purposes only and have not been surveyed unless otherwise stated.
All areas shown are approximate and should be verified before forming the basis of a decision.
Do not scale other than for Planning Application purposes.
All dimensions must be checked by the contractor before commencing work on site.
No deviation from this drawing will be permitted without the prior written consent of the A. Clarke Design Ltd.
The copyright of this drawing remains with the A. Clarke Design Ltd and may not be reproduced in any form without prior written consent.
Ground Floor Slabs, Foundations, Sub-Structures, etc. All work below ground level is shown provisionally. Inspection of ground condition is essential prior to work commencing.
Reassessment is essential when the ground conditions are apparent, and redesign may be necessary in the light of soil conditions found.
The responsibility for establishing the soil and sub-soil conditions rests with the contractor.

REV	A	28.07.2020 - bin storage area	
REV	DATE	DESCRIPTION	INT

© This drawing is copyright and must not be reproduced without the written consent of A. Clarke Design Ltd.
Do not scale from this drawing. All written dimensions should be checked on site.
A. Clarke Design Ltd to be informed of any dimensional discrepancy.

A. CLARKE DESIGN
ARCHITECTURAL DESIGN SERVICES

A. Clarke Design Ltd
Stanley Barn Farm, Stanley Pontlarge
Cheltenham, Glos, GL54 5HD
01242-620064
adam@aclarkedesign.co.uk
www.aclarkedesign.co.uk

UNIT 7 A
FIRST FLOOR, 27 TARVES WAY
GREENWICH SE10 9JU

PROPOSED CHANGE OF USE

PROPOSED LAYOUTS

Scale	1:50@A2	PLANNING 1760-06 A
Date	12/05/20	
Drawn	AC	

PROPOSED LAYOUTS