



LOCATION PLAN @ 1:1250


GROUND FLOOR @ 1:100

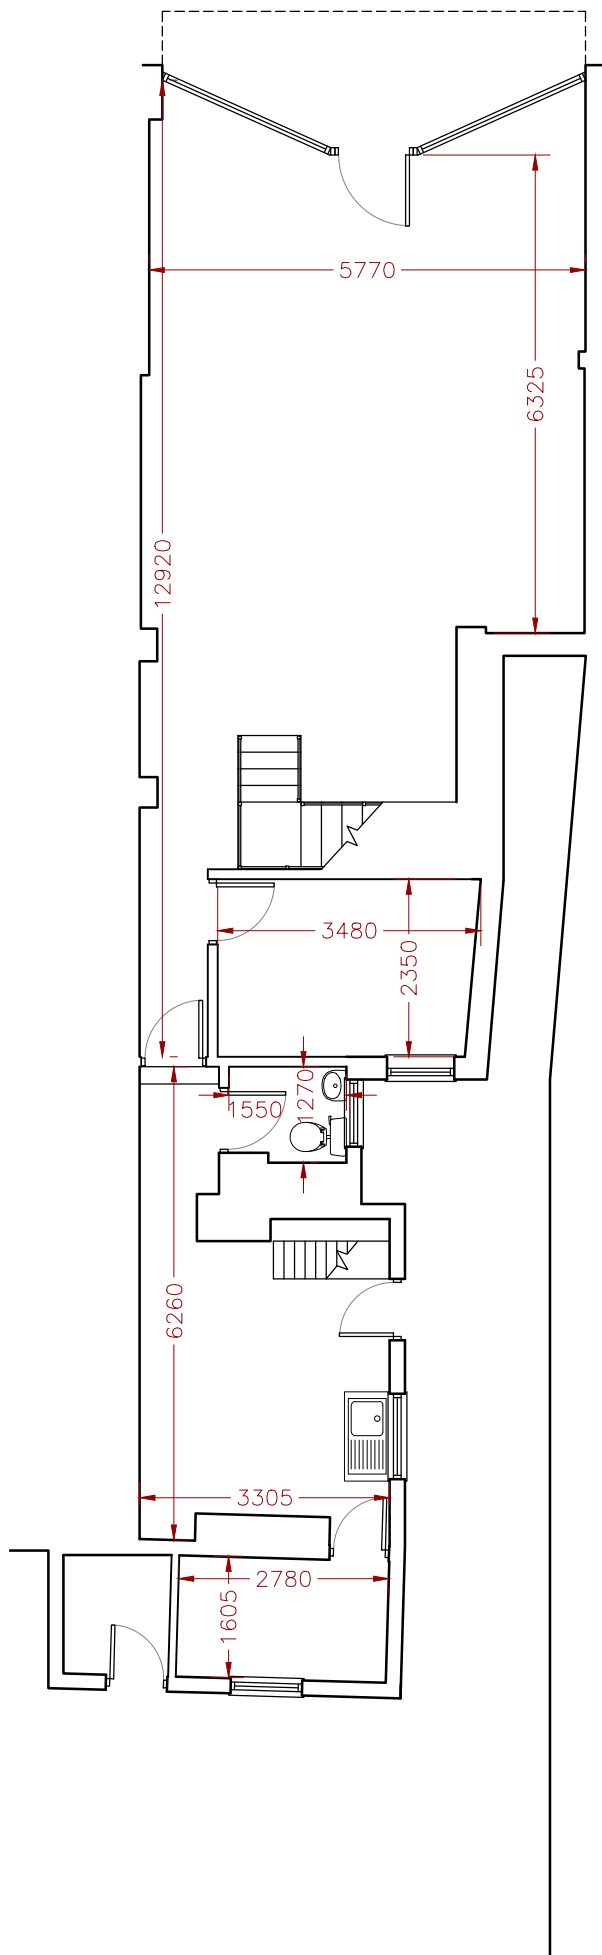


FIRST FLOOR @ 1:100

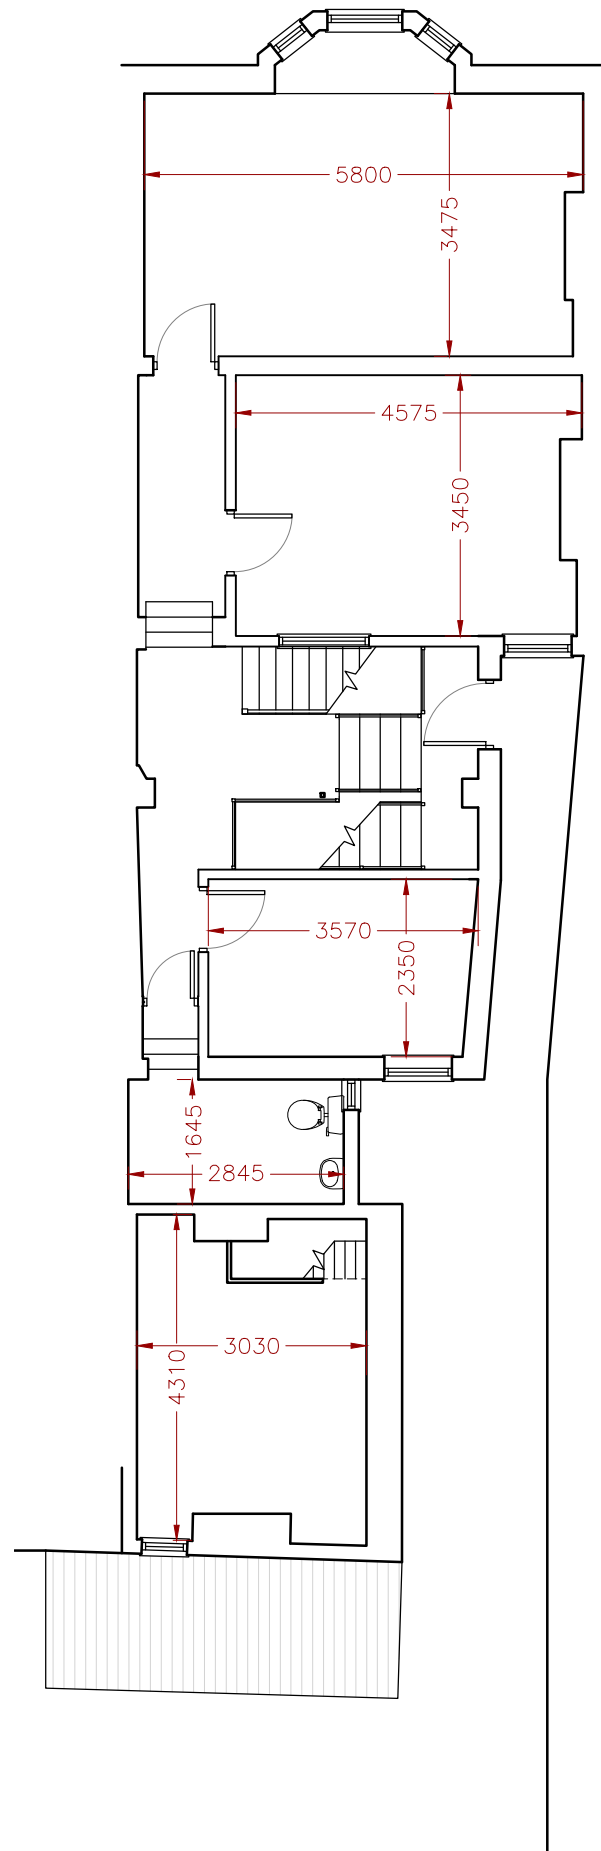

SECOND FLOOR @ 1:100

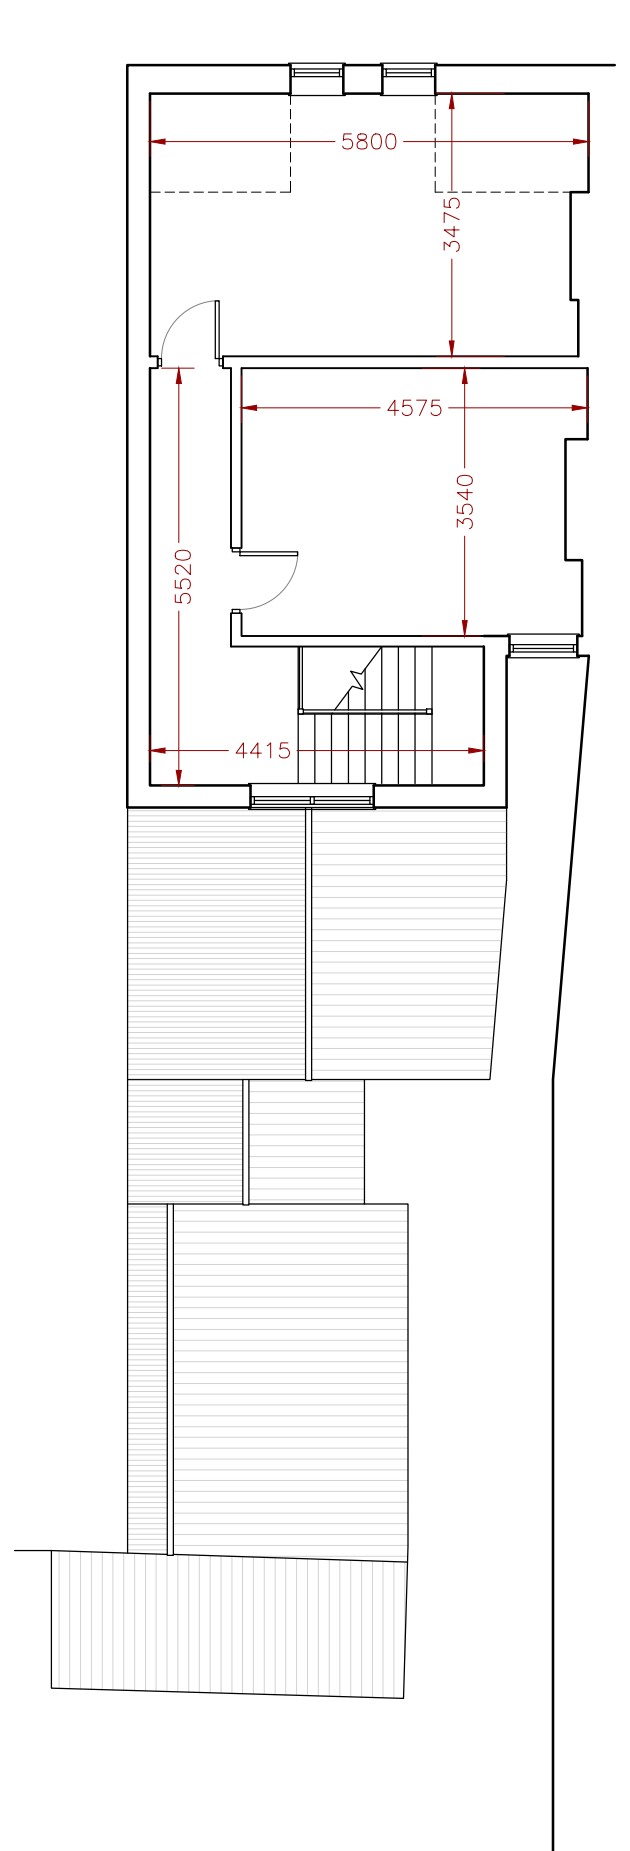

 ARCHITECTURE - SURVEYING - PLANNING admin@knight-consulting.co.uk    www.knight-consulting.co.uk	First Floor Unit 7 The Quarterdeck Port Solent PO6 4TP T: 01489 660194		Project <b>268 LONDON ROAD          WATERLOOVILLE          PO7 7EP</b>		
	Client <b>ADAM QUINT</b>	Scale <b>1:100@A3</b>	Date <b>APR 2026</b>		
Drawing <b>EXISTING PLAN</b>	Project no. <b>KC</b>	Sequential <b>01</b>	Bldg/Floor <b>A</b>	Detail <b>EX</b>	Rev <b>.</b>